


TEMPORARY 4 INCH WHITE LINE, PAINT  
 SPECIAL PROVISION (DURABLE 4 INCH WHITE LINE, POLYUREA)(28 MILS)  
 (ALL LINES WILL INCLUDE EDGE LINE BREAKS AND  
 RADIUS FOR TOWN HIGHWAYS)  
 NEW HAVEN:  
 STA. 227+00.0 - STA. 243+50.0 LT & RT

MILLED RUMBLE STRIPS (CENTERLINE)  
 NEW HAVEN:  
 STA. 227+00.00 - STA. 229+68.00  
 233+92 STA. 233+38.00 - STA. 240+77.00  
 243+15 STA. 243+41.00 - STA. 243+50.00

TEMPORARY 4 INCH YELLOW LINE, PAINT  
 SPECIAL PROVISION (DURABLE 4 INCH YELLOW LINE, POLYUREA)(28 MILS)  
 (ALL LINES WILL INCLUDE C/L BREAKS FOR  
 TOWN HIGHWAYS) S=SOLID, D=DASHED  
 NEW HAVEN:  
 STA. 227+00.0 - STA. 229+50.0 LT C RT  
 STA. 229+50.0 - STA. 237+50.0 D - S  
 STA. 237+50.0 - STA. 243+50.0 S - S

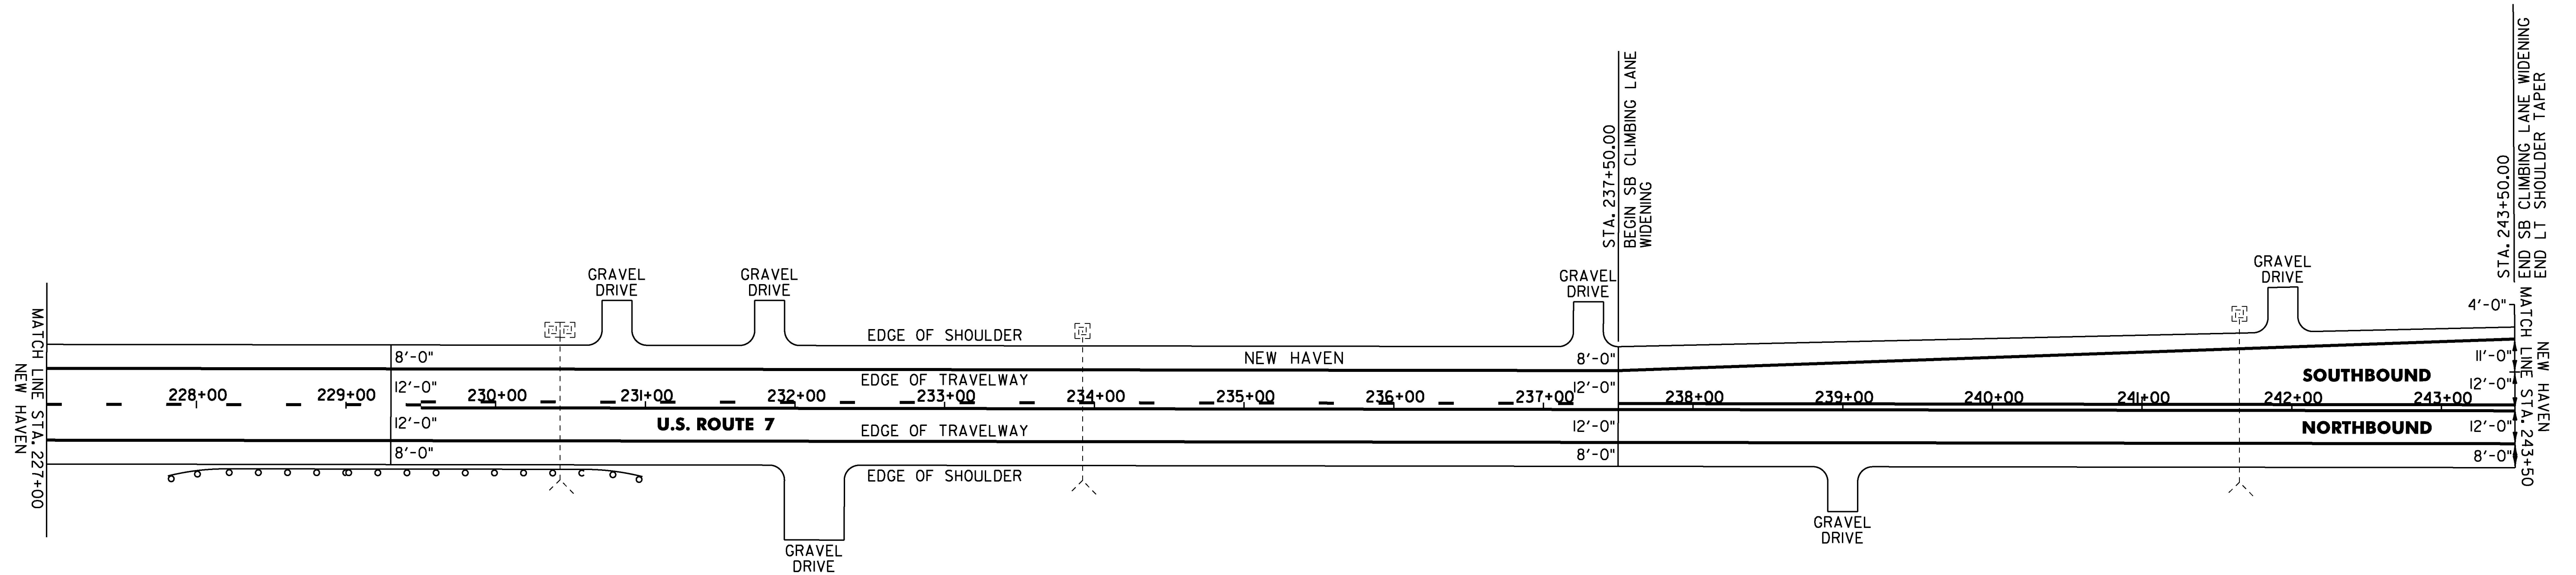

NOT TO SCALE

PROJECT NAME:	MIDDLEBURY-FERRISBURGH
PROJECT NUMBER:	NH SURF(55)
FILE NAME: p15v015.dgn	PLOT DATE: 16-MAR-2016
PROJECT LEADER: J. HARRINGTON	DRAWN BY: L. BULLOCK
DESIGNED BY: L. BULLOCK	CHECKED BY: J. HARRINGTON
PLAN SHEET 22	SHEET 36 OF 96