


TEMPORARY 4 INCH WHITE LINE, PAINT  
 SPECIAL PROVISION (DURABLE 4 INCH WHITE LINE, POLYUREA)(28 MILS)  
 (ALL LINES WILL INCLUDE EDGE LINE BREAKS AND  
 RADIUS FOR TOWN HIGHWAYS)  
 NEW HAVEN:  
 STA. 307+00.0 - STA. 322+00.0 LT & RT  
 STA. 307+00.0 - STA. 310+50.0 DASHED RT

TEMPORARY LETTER OR SYMBOL, PAINT  
 SPECIAL PROVISION (DURABLE LETTER OR SYMBOL, POLYUREA)(28 MILS) OR  
 DURABLE LETTER OR SYMBOL, THERMOPLASTIC  
 NEW HAVEN:  
 STA. 310+41.0 RT, ARROW //  
 STA. 312+21.0 RT, ARROW //  
 STA. 314+01.0 RT, ARROW //

MILLED RUMBLE STRIPS (CENTERLINE)  
 NEW HAVEN:  
 314+60 STA. 314+68.00 - STA. 322+00.00

TEMPORARY 4 INCH YELLOW LINE, PAINT  
 SPECIAL PROVISION (DURABLE 4 INCH YELLOW LINE, POLYUREA)(28 MILS)  
 (ALL LINES WILL INCLUDE C/L BREAKS FOR  
 TOWN HIGHWAYS) S=SOLID, D=DASHED  
 NEW HAVEN: LT C RT  
 STA. 307+00.0 - STA. 322+00.0 S - S

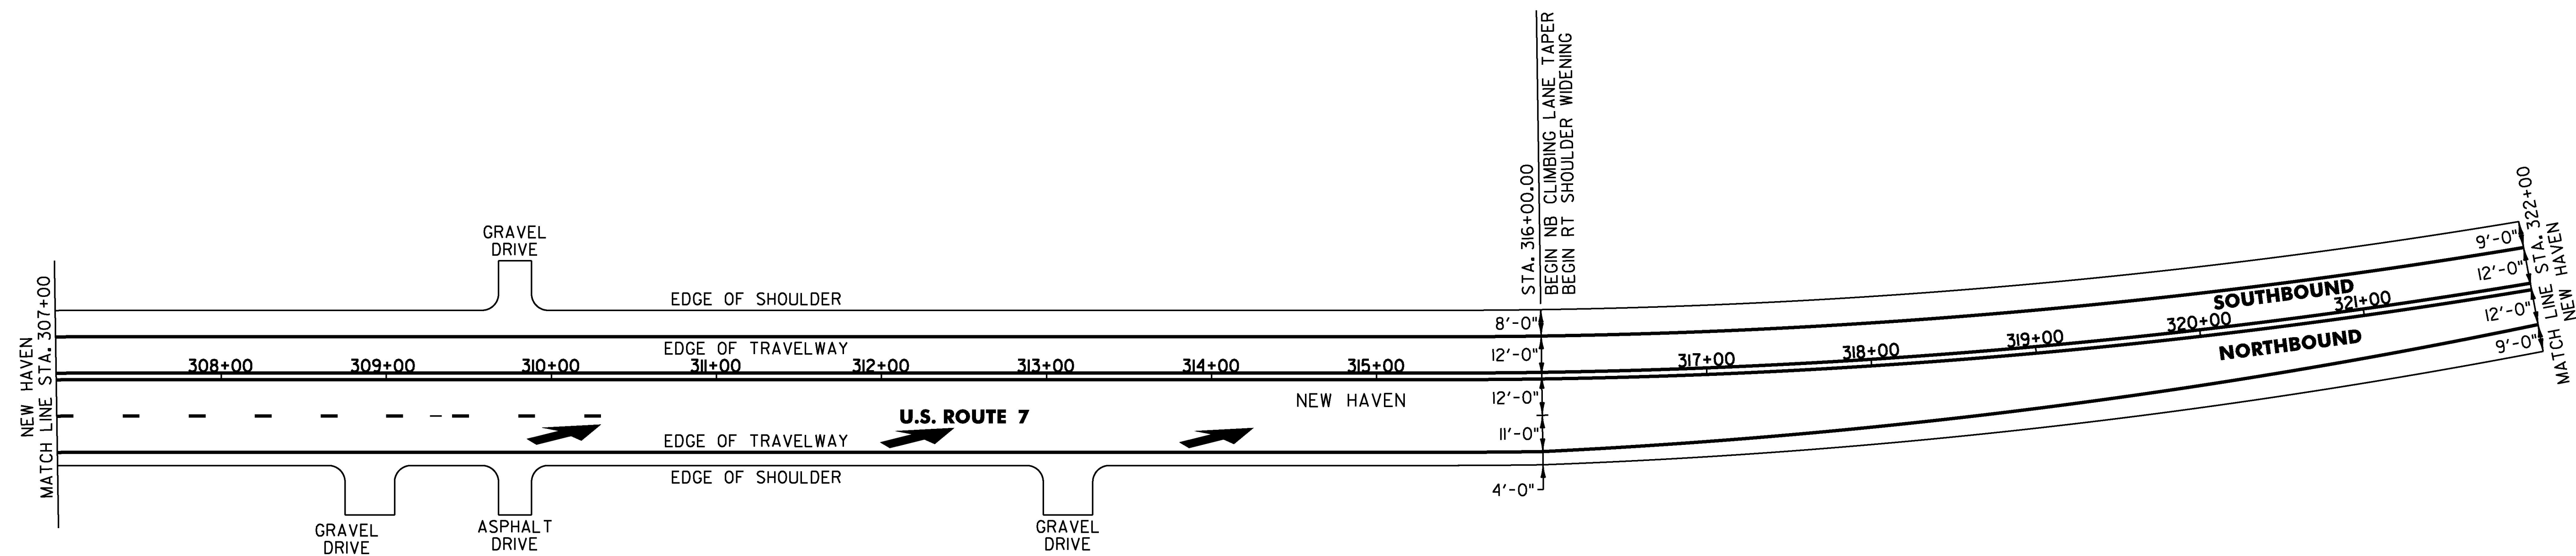

NOT TO SCALE

PROJECT NAME:	MIDDLEBURY-FERRISBURGH
PROJECT NUMBER:	NH SURF(55)
FILE NAME:	p15v015.dgn
PROJECT LEADER:	J. HARRINGTON
DESIGNED BY:	L. BULLOCK
PLAN SHEET 27	
PLOT DATE:	16-MAR-2016
DRAWN BY:	L. BULLOCK
CHECKED BY:	J. HARRINGTON
SHEET	41 OF 96