


TEMPORARY 4 INCH WHITE LINE, PAINT  
 SPECIAL PROVISION (DURABLE 4 INCH WHITE LINE, POLYUREA)(28 MILS)  
 (ALL LINES WILL INCLUDE EDGE LINE BREAKS AND  
 RADIUS FOR TOWN HIGHWAYS)  
 NEW HAVEN:  
 STA 322+00.00 - STA 336+00.00 LT & RT

TEMPORARY 4 INCH YELLOW LINE, PAINT  
 SPECIAL PROVISION (DURABLE 4 INCH YELLOW LINE, POLYUREA)  
 (ALL LINES WILL INCLUDE C/L BREAKS FOR  
 TOWN HIGHWAYS) S=SOLID, D=DASHED  
 NEW HAVEN: LT C RT  
 STA 322+00.00 - STA 335+28.00 S - S  
 STA 335+28.00 - STA 336+00.00 S - D  
 STA 326+62.08 DOUBLE SOLID RT, TH-8

~~TEMPORARY 24 INCH STOP BAR, PAINT  
 SPECIAL PROVISION (DURABLE 24 INCH STOP BAR, POLYUREA)(28 MILS)~~  
 NEW HAVEN:  
 STA 326+62.08 RT, TH-8  
  
 TEMPORARY LETTER OR SYMBOL, PAINT  
 SPECIAL PROVISION (DURABLE LETTER OR SYMBOL, POLYUREA)(28 MILS)  
 NEW HAVEN:  
 STA 326+62.08 RT, TH-8 "STOP" (4 EA)

MILLED RUMBLE STRIPS (CENTERLINE)  
 NEW HAVEN:  
 STA. 322+00.00 - STA. 322+61.00 322+10  
 STA. 330+00.00 - STA. 336+00.00  
 333+00.00

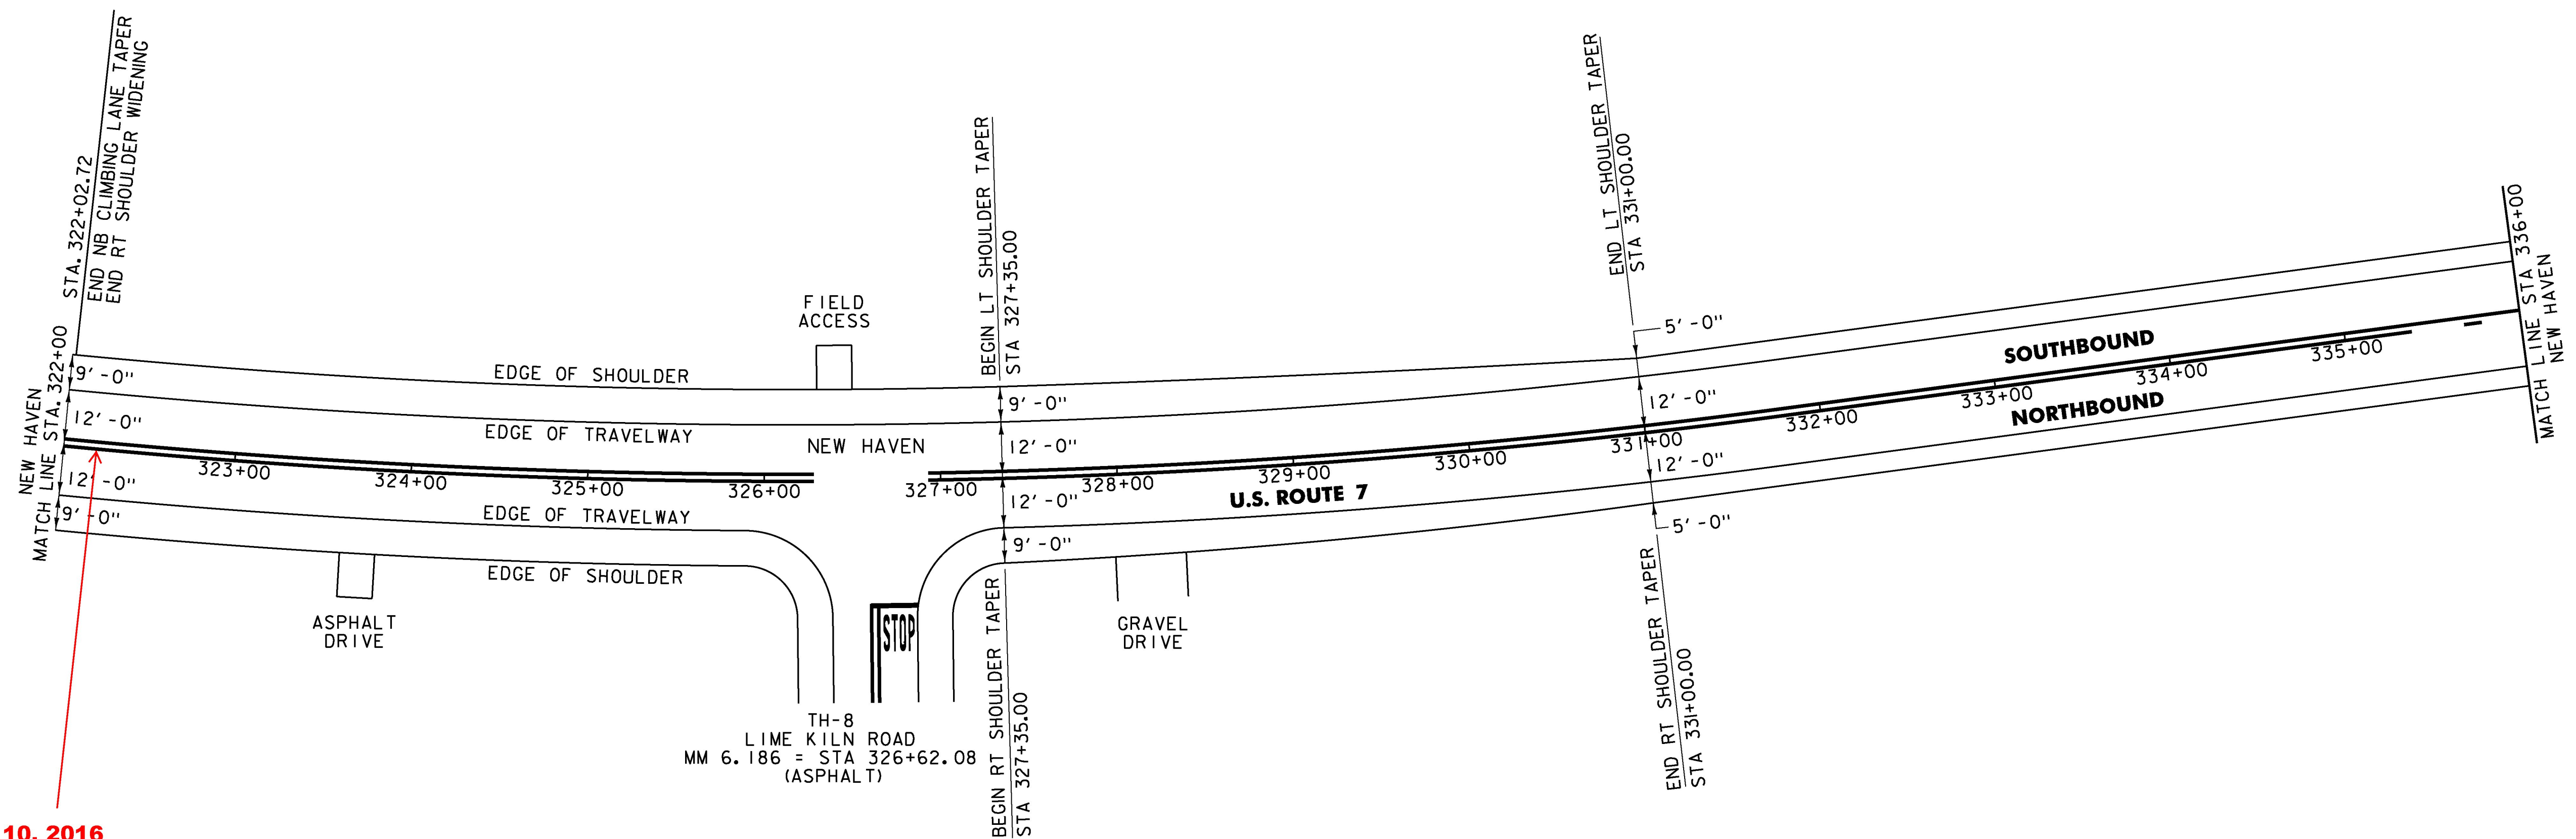

**Oct. 10, 2016**  
**Interim Completion**  
**New Haven 322+07**

NOT TO SCALE

PROJECT NAME: MIDDLEBURY-FERRISBURGH	PLOT DATE: 16-MAR-2016
PROJECT NUMBER: NH SURF(55)	DRAWN BY: L. BULLOCK
FILE NAME: pl5v015.dgn	CHECKED BY: J. HARRINGTON
DESIGNED BY: L. BULLOCK	PLAN SHEET 28
	SHEET 42 OF 96