


TEMPORARY 4 INCH WHITE LINE, PAINT  
 SPECIAL PROVISION (DURABLE 4 INCH WHITE LINE, POLYUREA)(28 MILS)  
 (ALL LINES WILL INCLUDE EDGE LINE BREAKS AND  
 RADIUS FOR TOWN HIGHWAYS)  
 NEW HAVEN:  
 STA 352+00.00 - STA 368+00.00 LT & RT

TEMPORARY 4 INCH YELLOW LINE, PAINT  
 SPECIAL PROVISION (DURABLE 4 INCH YELLOW LINE, POLYUREA)(28 MILS)  
 (ALL LINES WILL INCLUDE C/L BREAKS FOR  
 TOWN HIGHWAYS) S=SOLID, D=DASHED  
 NEW HAVEN:  
 STA 352+00.00 - STA 357+45.00 LT C RT  
 STA 357+45.00 - STA 358+78.00 D - S  
 STA 358+78.00 - STA 366+17.00 S - D  
 STA 366+17.00 - STA 368+00.00 - D -

MILLED RUMBLE STRIPS (CENTERLINE)  
 NEW HAVEN:  
 STA. 352+00.00 - STA. 368+00.00

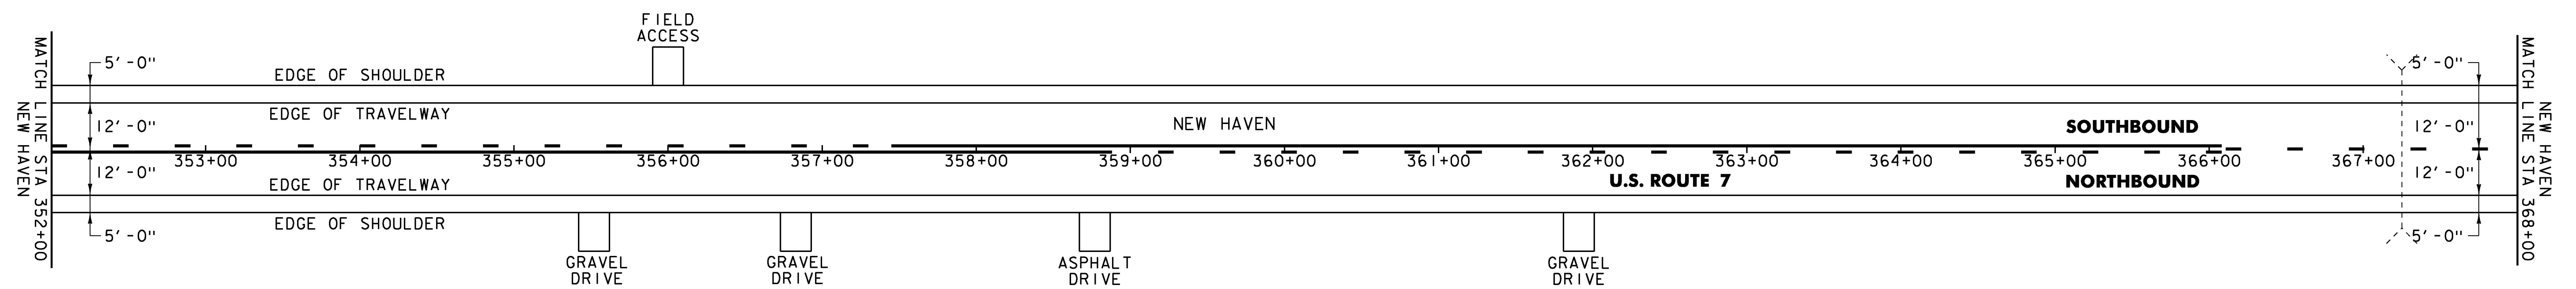

NOT TO SCALE

PROJECT NAME: MIDDLEBURY-FERRISBURGH	
PROJECT NUMBER: NH SURF(55)	
FILE NAME: pl5v015.dgn	PLOT DATE: 16-MAR-2016
PROJECT LEADER: J. HARRINGTON	DRAWN BY: L. BULLOCK
DESIGNED BY: L. BULLOCK	CHECKED BY: J. HARRINGTON
PLAN SHEET 30	SHEET 44 OF 96