


TEMPORARY 4 INCH WHITE LINE, PAINT
 SPECIAL PROVISION (DURABLE 4 INCH WHITE LINE, POLYUREA)(28 MILS) OR
 DURABLE 4 INCH WHITE LINE, THERMOPLASTIC
 (ALL LINES WILL INCLUDE EDGE LINE BREAKS AND
 RADIUS FOR TOWN HIGHWAYS)
 NEW HAVEN:
 STA 368+00.00 - STA 384+00.00 LT & RT

SPECIAL PROVISION (DURABLE 4 INCH YELLOW LINE, POLYUREA)(28 MILS)
 (ALL LINES WILL INCLUDE C/L BREAKS FOR
 TOWN HIGHWAYS) S=SOLID, D=DASHED
 NEW HAVEN:
 STA 368+00.00 - STA 384+00.00 LT C RT
 - D -

MILLED RUMBLE STRIPS (CENTERLINE)
 NEW HAVEN:
 STA. 368+00.00 - STA. ~~382+27.00~~
 382+20.00

TEMPORARY 4 INCH YELLOW LINE, PAINT
 (ALL LINES WILL INCLUDE C/L BREAKS FOR
 TOWN HIGHWAYS) S=SOLID, D=DASHED
 NEW HAVEN:
 STA 368+00.00 - STA 384+00.00 LT C RT
 - D -

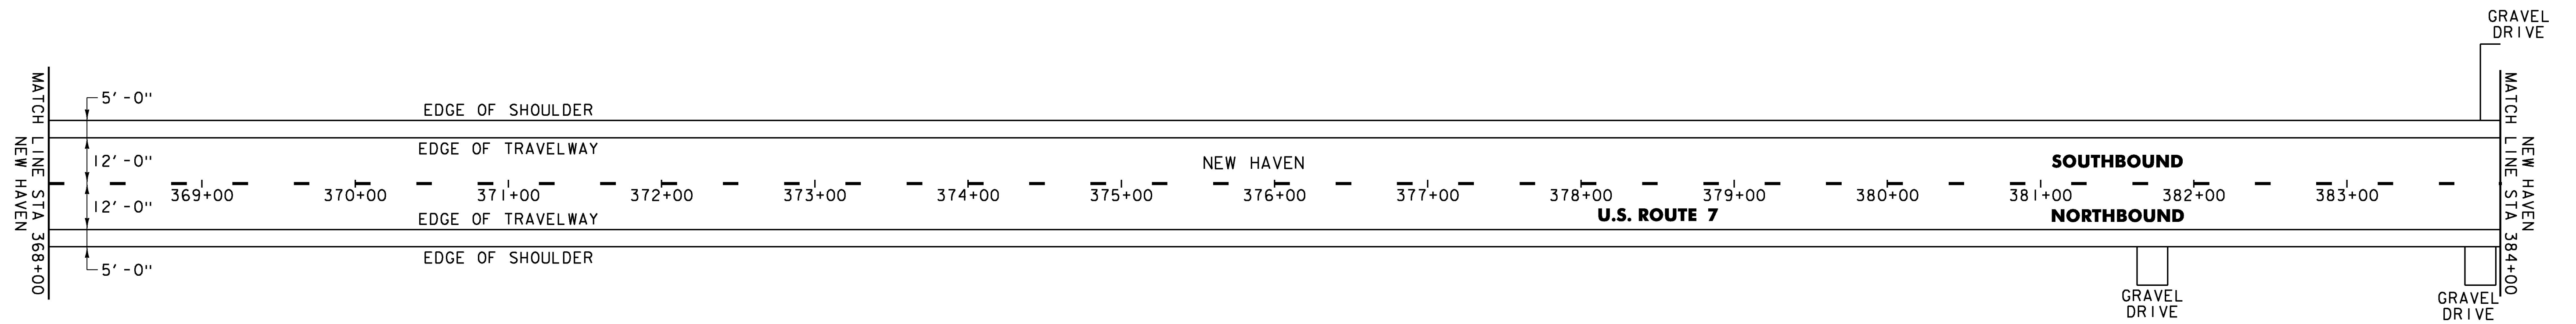

NOT TO SCALE

| | |
|-------------------------------|---------------------------|
| PROJECT NAME: | MIDDLEBURY-FERRISBURGH |
| PROJECT NUMBER: | NH SURF(55) |
| FILE NAME: pl5v015.dgn | PLOT DATE: 16-MAR-2016 |
| PROJECT LEADER: J. HARRINGTON | DRAWN BY: L. BULLOCK |
| DESIGNED BY: L. BULLOCK | CHECKED BY: J. HARRINGTON |
| PLAN SHEET 31 | SHEET 45 OF 96 |