


TEMPORARY 4 INCH WHITE LINE, PAINT
 SPECIAL PROVISION (DURABLE 4 INCH WHITE LINE, POLYUREA)(28 MILS)
 (ALL LINES WILL INCLUDE EDGE LINE BREAKS AND
 RADIUS FOR TOWN HIGHWAYS)
 WALTHAM:
 STA 58+00.00 - STA 74+00.00 LT & RT
 STA 65+37.50 - STA 74+00.00 DASHED LT

TEMPORARY 4 INCH YELLOW LINE, PAINT
 SPECIAL PROVISION (DURABLE 4 INCH YELLOW LINE, POLYUREA)(28 MILS)
 (ALL LINES WILL INCLUDE C/L BREAKS FOR
 TOWN HIGHWAYS) S=SOLID, D=DASHED
 WALTHAM:
 STA 58+00.00 - STA 74+00.00 LT C RT
 S - S

TEMPORARY LETTER OR SYMBOL, PAINT
 SPECIAL PROVISION (DURABLE LETTER OR SYMBOL, POLYUREA)(28 MILS) OR
 DURABLE LETTER OR SYMBOL, THERMOPLASTIC
 WALTHAM:
 STA. 61+86.5 LT, ARROW ↗
 STA. 63+66.5 LT, ARROW ↗
 STA. 65+46.5 LT, ARROW ↗

MILLED RUMBLE STRIPS (CENTERLINE)
 WALTHAM:
 STA. 58+00.00 - STA. ~~72+34.00~~ 71+77.00

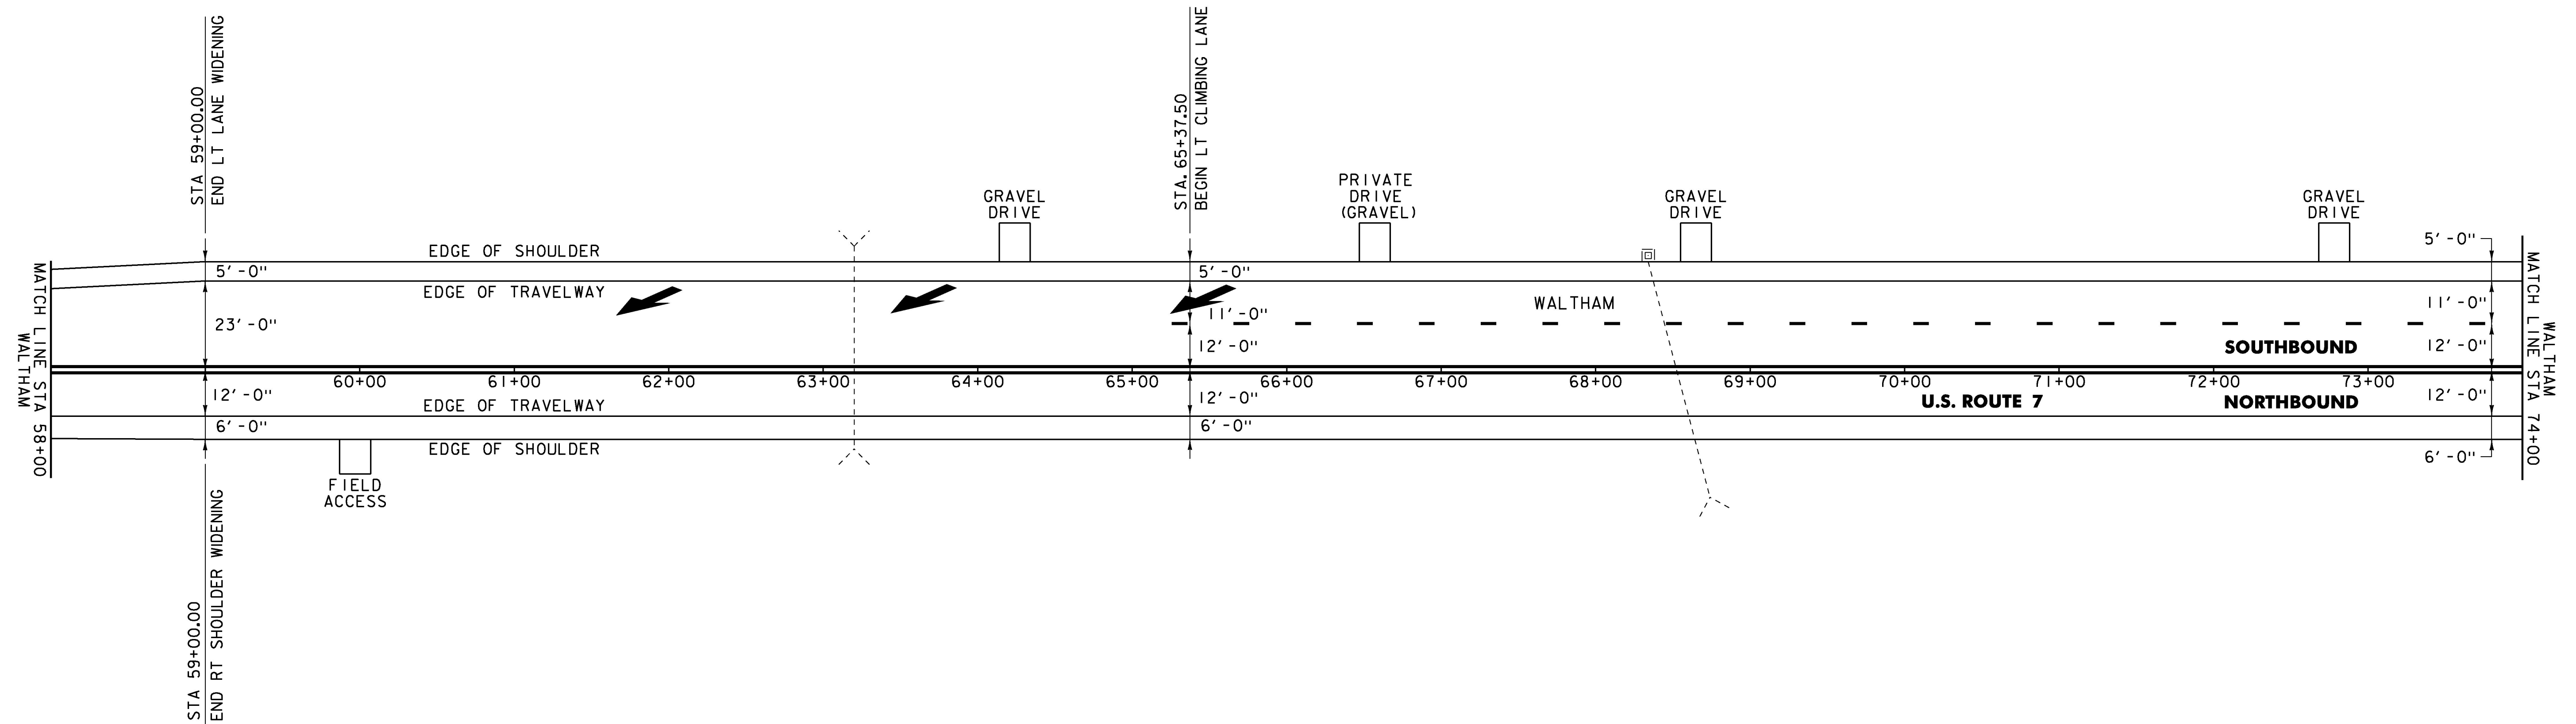

NOT TO SCALE

PROJECT NAME:	MIDDLEBURY-FERRISBURGH
PROJECT NUMBER:	NH SURF(55)
FILE NAME:	p15v015.dgn
PROJECT LEADER:	J. HARRINGTON
DESIGNED BY:	L. BULLOCK
PLAN SHEET 37	
PLOT DATE:	16-MAR-2016
DRAWN BY:	L. BULLOCK
CHECKED BY:	J. HARRINGTON
SHEET	51 OF 96