

TEMPORARY 4 INCH WHITE LINE, PAINT
SPECIAL PROVISION (DURABLE 4 INCH WHITE LINE, POLYUREA)(28 MILS)
(ALL LINES WILL INCLUDE EDGE LINE BREAKS AND RADIUS FOR TOWN HIGHWAYS)

WALTHAM:
STA 74+00.00 - STA 86+22.24 LT & RT
STA 74+00.00 - STA 86+22.24 DASHED LT

FERRISBURGH:
STA 0+00.00 - STA 3+00.00 LT & RT
STA 0+00.00 - STA 3+00.00 DASHED LT
STA 2+60.00 - STA 3+00.00 DOTTED RT

TEMPORARY 4 INCH YELLOW LINE, PAINT
SPECIAL PROVISION (DURABLE 4 INCH YELLOW LINE, POLYUREA)(28 MILS)
(ALL LINES WILL INCLUDE C/L BREAKS FOR TOWN HIGHWAYS) S=SOLID, D=DASHED

WALTHAM:
STA 74+00.0 - STA. 80+75.0 LT & RT
STA 83+95.20 DOUBLE SOLID RT, TH-3
STA 80+75.00 - STA 83+55.00 DOUBLE SOLID MEDIAN LT & RT
STA 84+40.00 - STA 86+00.00 DOUBLE SOLID MEDIAN LT & RT
STA 86+00.00 - STA 86+22.24 SOLID MEDIAN EDGE LINE LT & RT


FERRISBURGH:
STA 0+00.00 - STA 3+00.00 SOLID MEDIAN EDGE LINE LT
STA 0+00.00 - STA 3+00.00 DOUBLE SOLID MEDIAN RT

TEMPORARY 8 INCH YELLOW LINE, PAINT
SPECIAL PROVISION (DURABLE 8 INCH YELLOW LINE, POLYUREA)(28 MILS)

WALTHAM:
STA 80+75.00 - STA 83+55.00 HATCHED MEDIAN LT & RT
STA 84+40.00 - STA 86+00.00 HATCHED MEDIAN LT & RT

TEMPORARY 24 INCH STOP BAR, PAINT
SPECIAL PROVISION (DURABLE 24 INCH STOP BAR, POLYUREA)(28 MILS) OR DURABLE 24 INCH STOP BAR, THERMOPLASTIC

WALTHAM:
STA 83+95.20 RT, TH-3
STA. 74+60 LT, Crosby Heights

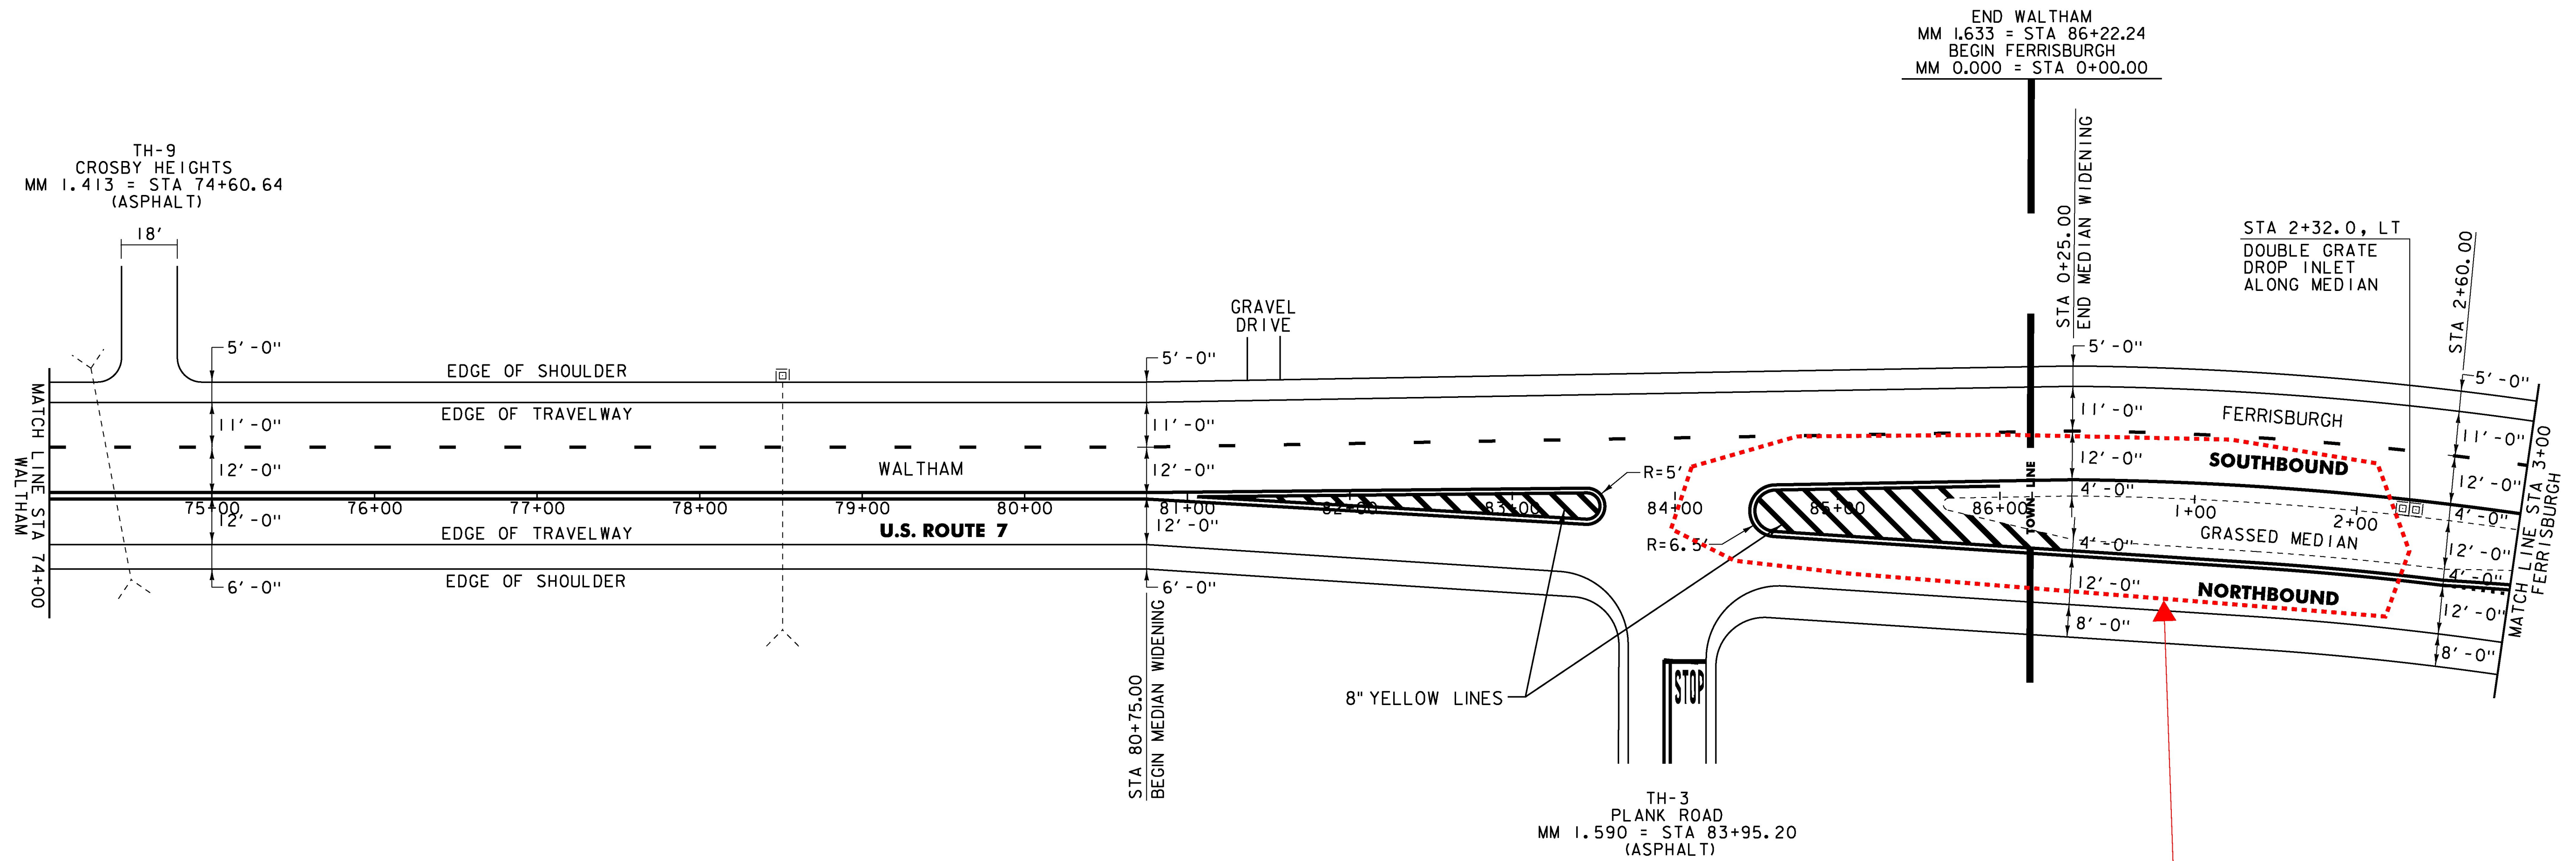

See Sheet 52A and 52B for Revised Plank Road Intersection Details

TEMPORARY LETTER OR SYMBOL, PAINT
SPECIAL PROVISION (DURABLE LETTER OR SYMBOL, POLYUREA)(28 MILS) OR DURABLE LETTER OR SYMBOL, THERMOPLASTIC
WALTHAM:
STA 83+95.20 RT, TH-3 "STOP" (4 EA)

MILLED RUMBLE STRIPS (CENTERLINE)
WALTHAM:
STA. 74+45.00 - STA. 80+75.00
STA. 74+75.00 - STA. 80+74.00

CHANGING ELEV. OF DROP INLETS, CATCH BASINS, OR MANHOLES
FERRISBURGH:
STA 2+32.0 LT (DID NOT ADJUST)

NOT TO SCALE

PROJECT NAME:	MIDDLEBURY-FERRISBURGH
PROJECT NUMBER:	NH SURF(55)
FILE NAME:	p15v015.dgn
PROJECT LEADER:	J. HARRINGTON
DESIGNED BY:	L. BULLOCK
PLAN SHEET 38	CHECKED BY: J. HARRINGTON
	PLOT DATE: 16-MAR-2016
	DRAWN BY: L. BULLOCK
	SHEET 52 OF 96