

TEMPORARY 4 INCH WHITE LINE, PAINT  
 SPECIAL PROVISION (DURABLE 4 INCH WHITE LINE, POLYUREA)(28 MILS)  
 WALTHAM STA. 84+16 LT. - FERRISBURGH STA. 0+88 LT. (SOLID)  
 FERRISBURGH STA. 0+88 LT. - FERRISBURGH STA. 2+58 LT. (DOTTED)

TEMPORARY 4 INCH YELLOW LINE, PAINT  
 SPECIAL PROVISION (DURABLE 4 INCH YELLOW LINE, POLYUREA)(28 MILS)  
 WALTHAM STA. 84+16 RT. - FERRISBURGH STA. 2+50 RT. (DOUBLE)

TEMPORARY 8 INCH YELLOW LINE, PAINT  
 SPECIAL PROVISION (DURABLE 8 INCH YELLOW LINE, POLYUREA)(28 MILS)  
 WALTHAM STA. 84+16 RT. - FERRISBURGH STA. 1+50 RT. (GORE)

TEMPORARY 24 INCH STOP BAR, PAINT  
 SPECIAL PROVISION (DURABLE 24 INCH STOP BAR, POLYUREA)(28 MILS)  
 WALTHAM STA. 84+16 LT./RT.

PAINTED CURB  
 FERRISBURGH STA. 1+50 RT. - 2+50 RT.

REMOVING AND RESETTING CURB  
 FERRISBURGH STA. 1+50 RT. - 2+50 RT.

REMOVING SIGNS  
 WALTHAM STA. 85+91 RT. (2 EA)


REMOVAL OF EXISTING CURB  
 WALTHAM STA. 85+80 C/L - FERRISBURGH 2+50 RT.

ERECTING SALVAGED SIGNS  
 FERRISBURGH STA. 1+64 RT. (2 EA)

UNCLASSIFIED EXCAVATION  
 WALTHAM STA. 85+80 C/L - FERRISBURGH STA. 2+50 RT.

TRAFFIC SIGN, TYPE A  
 FERRISBURGH STA. 0+88 LT.  
 FERRISBURGH STA. 1+64 RT.

SQUARE TUBE SIGN POST AND ANCHOR  
 FERRISBURGH STA. 0+88 LT.

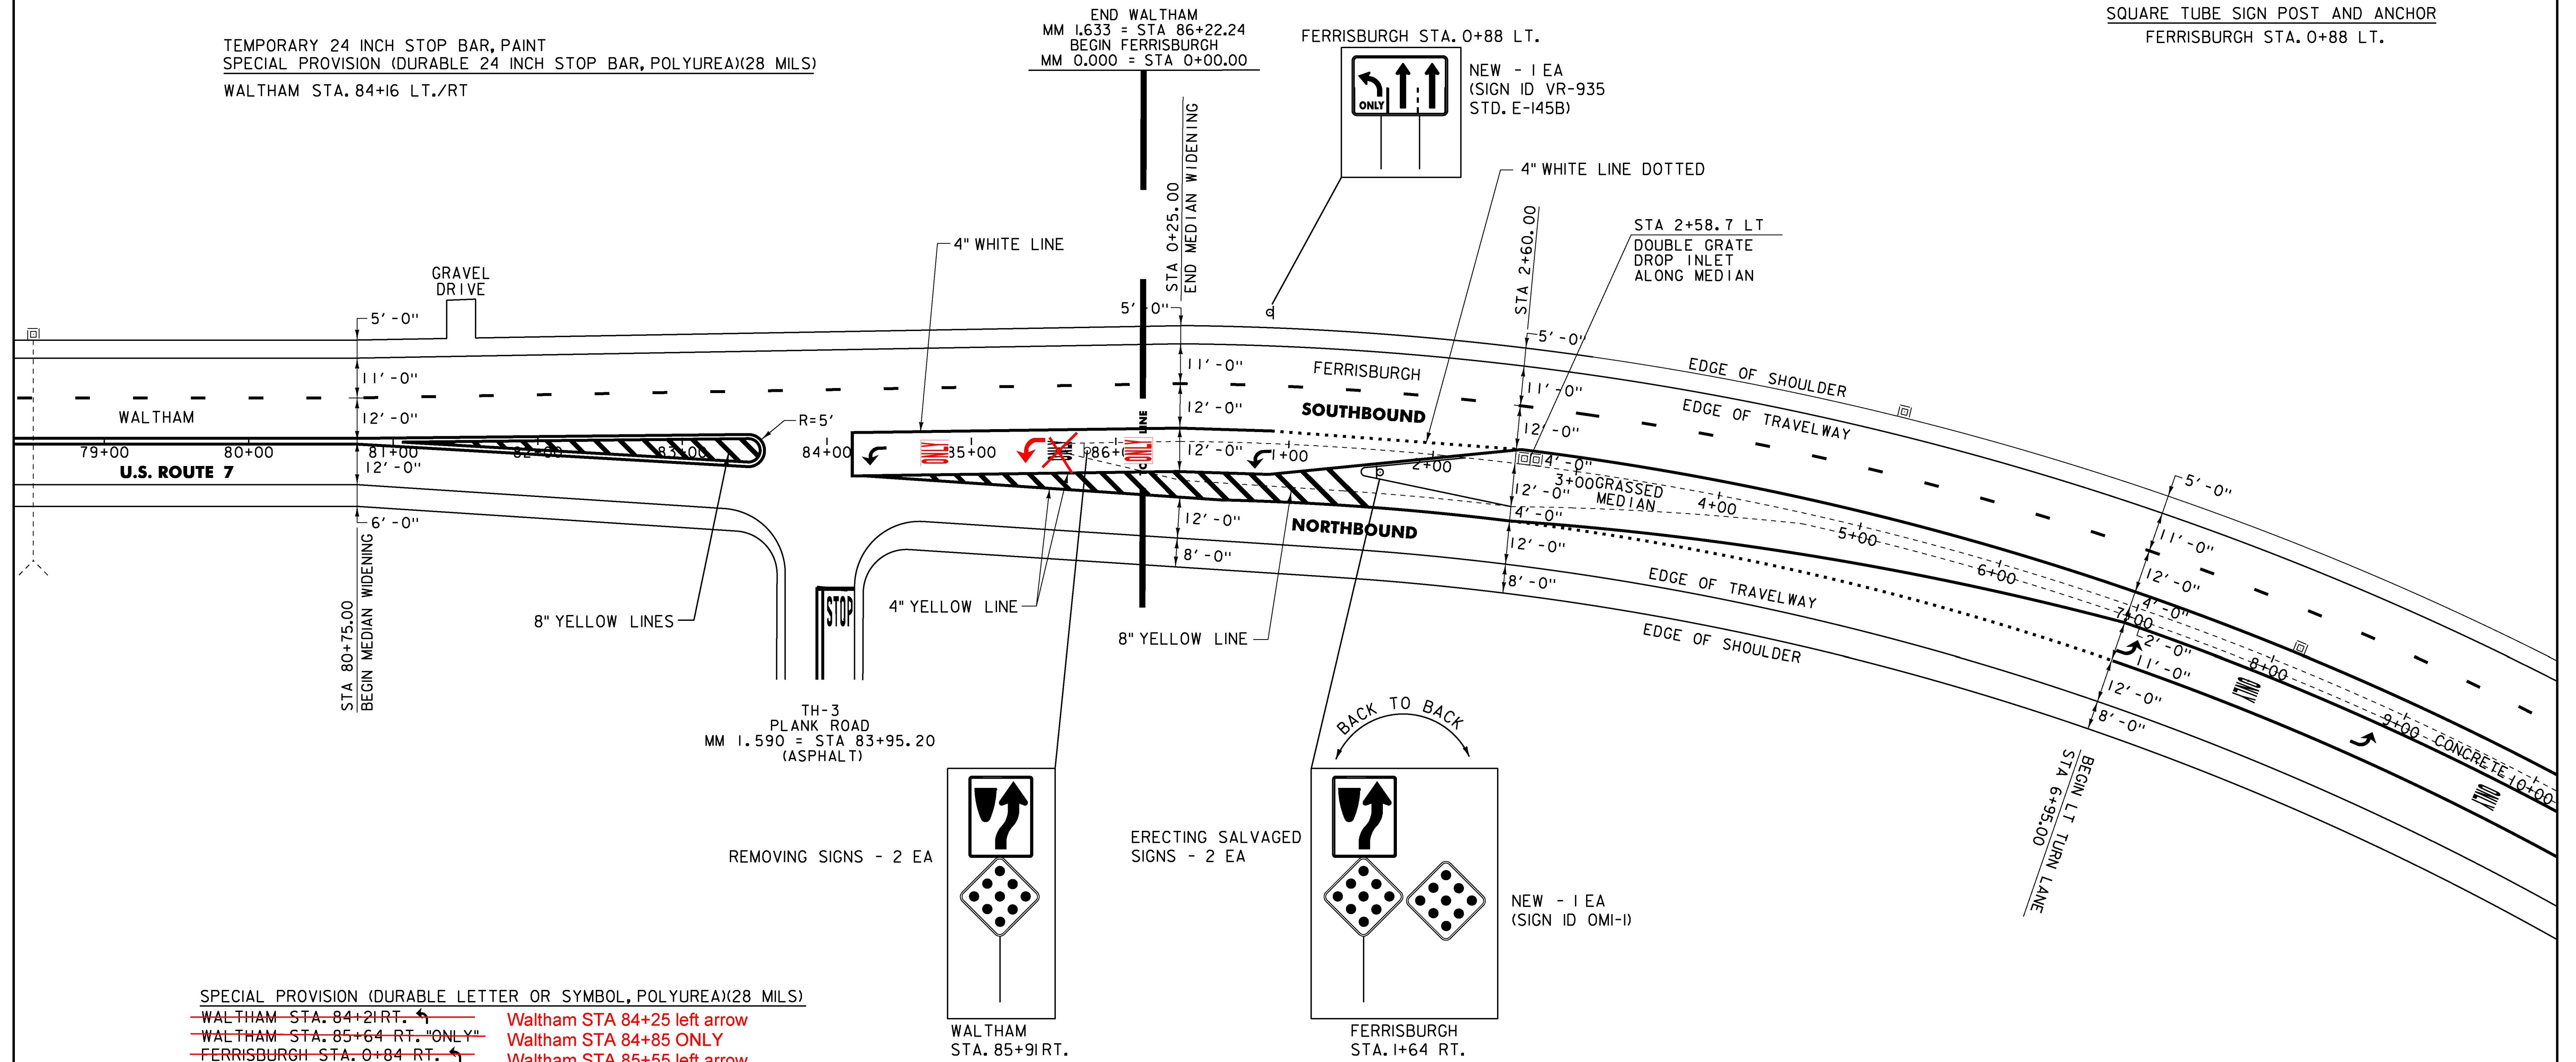

SPECIAL PROVISION (DURABLE LETTER OR SYMBOL, POLYUREA)(28 MILS)  
~~WALTHAM STA. 84+21 RT.~~ → Waltham STA 84+25 left arrow  
~~WALTHAM STA. 85+64 RT. "ONLY"~~ → Waltham STA 84+85 ONLY  
~~FERRISBURGH STA. 0+84 RT.~~ → Waltham STA 85+55 left arrow  
 → Waltham STA 86+20 ONLY  
 → Ferrisburgh STA 0+65 left arrow

TEMPORARY LETTER OR SYMBOL, PAINT  
 WALTHAM STA. 84+21 RT. ↙  
 FERRISBURGH STA. 0+84 RT. ↙

NOT TO SCALE

PROJECT NAME: MIDDLEBURY-FERRISBURGH	
PROJECT NUMBER: NH SURF(55)	
FILE NAME: pl5v015.dgn	PLOT DATE: 17-MAY-2017
PROJECT LEADER: J. HARRINGTON	DRAWN BY: L. BULLOCK
DESIGNED BY: L. BULLOCK	CHECKED BY: J. HARRINGTON
PLAN SHEET Revised Plank Road Intersection	SHEET 52B2 OF 96 2