

TEMPORARY 4 INCH WHITE LINE, PAINT
 SPECIAL PROVISION (DURABLE 4 INCH WHITE LINE, POLYUREA)(28 MILS)

(ALL LINES WILL INCLUDE EDGE LINE BREAKS AND RADIUS FOR TOWN HIGHWAYS)

FERRISBURGH:
 STA 3+00.00- STA 6+95.00 DOTTED RT
 STA 3+00.00 - STA 11+75.00 DASHED LT
 STA 3+00.00 - STA 19+00.00 LT & RT
 STA 6+95.00 - STA 12+65.00 SOLID RT
 FERRISBURGH STATE HIGHWAY MM 0.000 - MM 0.136 LT & RT

TEMPORARY 4 INCH YELLOW LINE, PAINT
 SPECIAL PROVISION (DURABLE 4 INCH YELLOW LINE, POLYUREA)(28 MILS)

(ALL LINES WILL INCLUDE C/L BREAKS FOR TOWN HIGHWAYS) S=SOLID, D=DASHED

FERRISBURGH:
 STA 3+00.00 - STA 12+50.00 SOLID MEDIAN EDGE LINE LT
 STA 13+25.00 - STA 16+25.00 SOLID MEDIAN EDGE LINE LT
 STA 13+25.00 - STA 16+90.00 SOLID MEDIAN EDGE LINE RT
 STA 16+25.00 - STA 19+00.00 DOUBLE SOLID MEDIAN LINE LT
 STA 16+90.00 - STA 19+00.00 DOUBLE SOLID MEDIAN LINE RT
 STA 3+00.00 - STA 6+95.00 DOUBLE SOLID MEDIAN RT
 STA 6+95.00 - STA 12+50 SOLID MEDIAN RT
 FERRISBURGH STATE HIGHWAY MM 0.000 - MM 0.136 DOUBLE SOLID

SPECIAL PROVISION (DURABLE LETTER OR SYMBOL, POLYUREA)(28 MILS) OR DURABLE LETTER OR SYMBOL, THERMOPLASTIC


FERRISBURGH:
 STA 6+99.30 RT, ARROW (1EA)
 STA 7+89.80 RT, "ONLY" (4 EA)
 STA 8+80.30 RT, ARROW (1EA)
 STA 9+70.80 RT "ONLY" (4 EA)
 STA 10+61.30 RT, ARROW (1EA)
 STA 11+51.80 RT, "ONLY" (4 EA)
 STA 12+42.30 RT, ARROW (1EA)
 FERRISBURGH STATE HIGHWAY MM 0.012 RT, "STOP" (4 EA)
 FERRISBURGH STATE HIGHWAY MM 0.021 RT, "AHEAD" (5 EA)
 FERRISBURGH STATE HIGHWAY MM 0.122 RT, "STOP" (4 EA)

TEMPORARY LETTER OR SYMBOL, PAINT

FERRISBURGH:
 STA 6+99.30 RT, ARROW (2 EA)
 STA 8+80.30 RT, ARROW (2 EA)
 STA 10+61.30 RT, ARROW (2 EA)
 STA 12+42.30 RT, ARROW (2 EA)
 FERRISBURGH STATE HIGHWAY MM 0.012 RT, "STOP" (8 EA)
 FERRISBURGH STATE HIGHWAY MM 0.021 RT, "AHEAD" (10 EA)
 FERRISBURGH STATE HIGHWAY MM 0.122 RT, "STOP" (8 EA)

TEMPORARY 8 INCH YELLOW LINE, PAINT
 SPECIAL PROVISION (DURABLE 8 INCH YELLOW LINE, POLYUREA)(28 MILS)

FERRISBURGH:
 STA 16+25.00 - STA 19+00.00 HATCH MEDIAN LT & RT

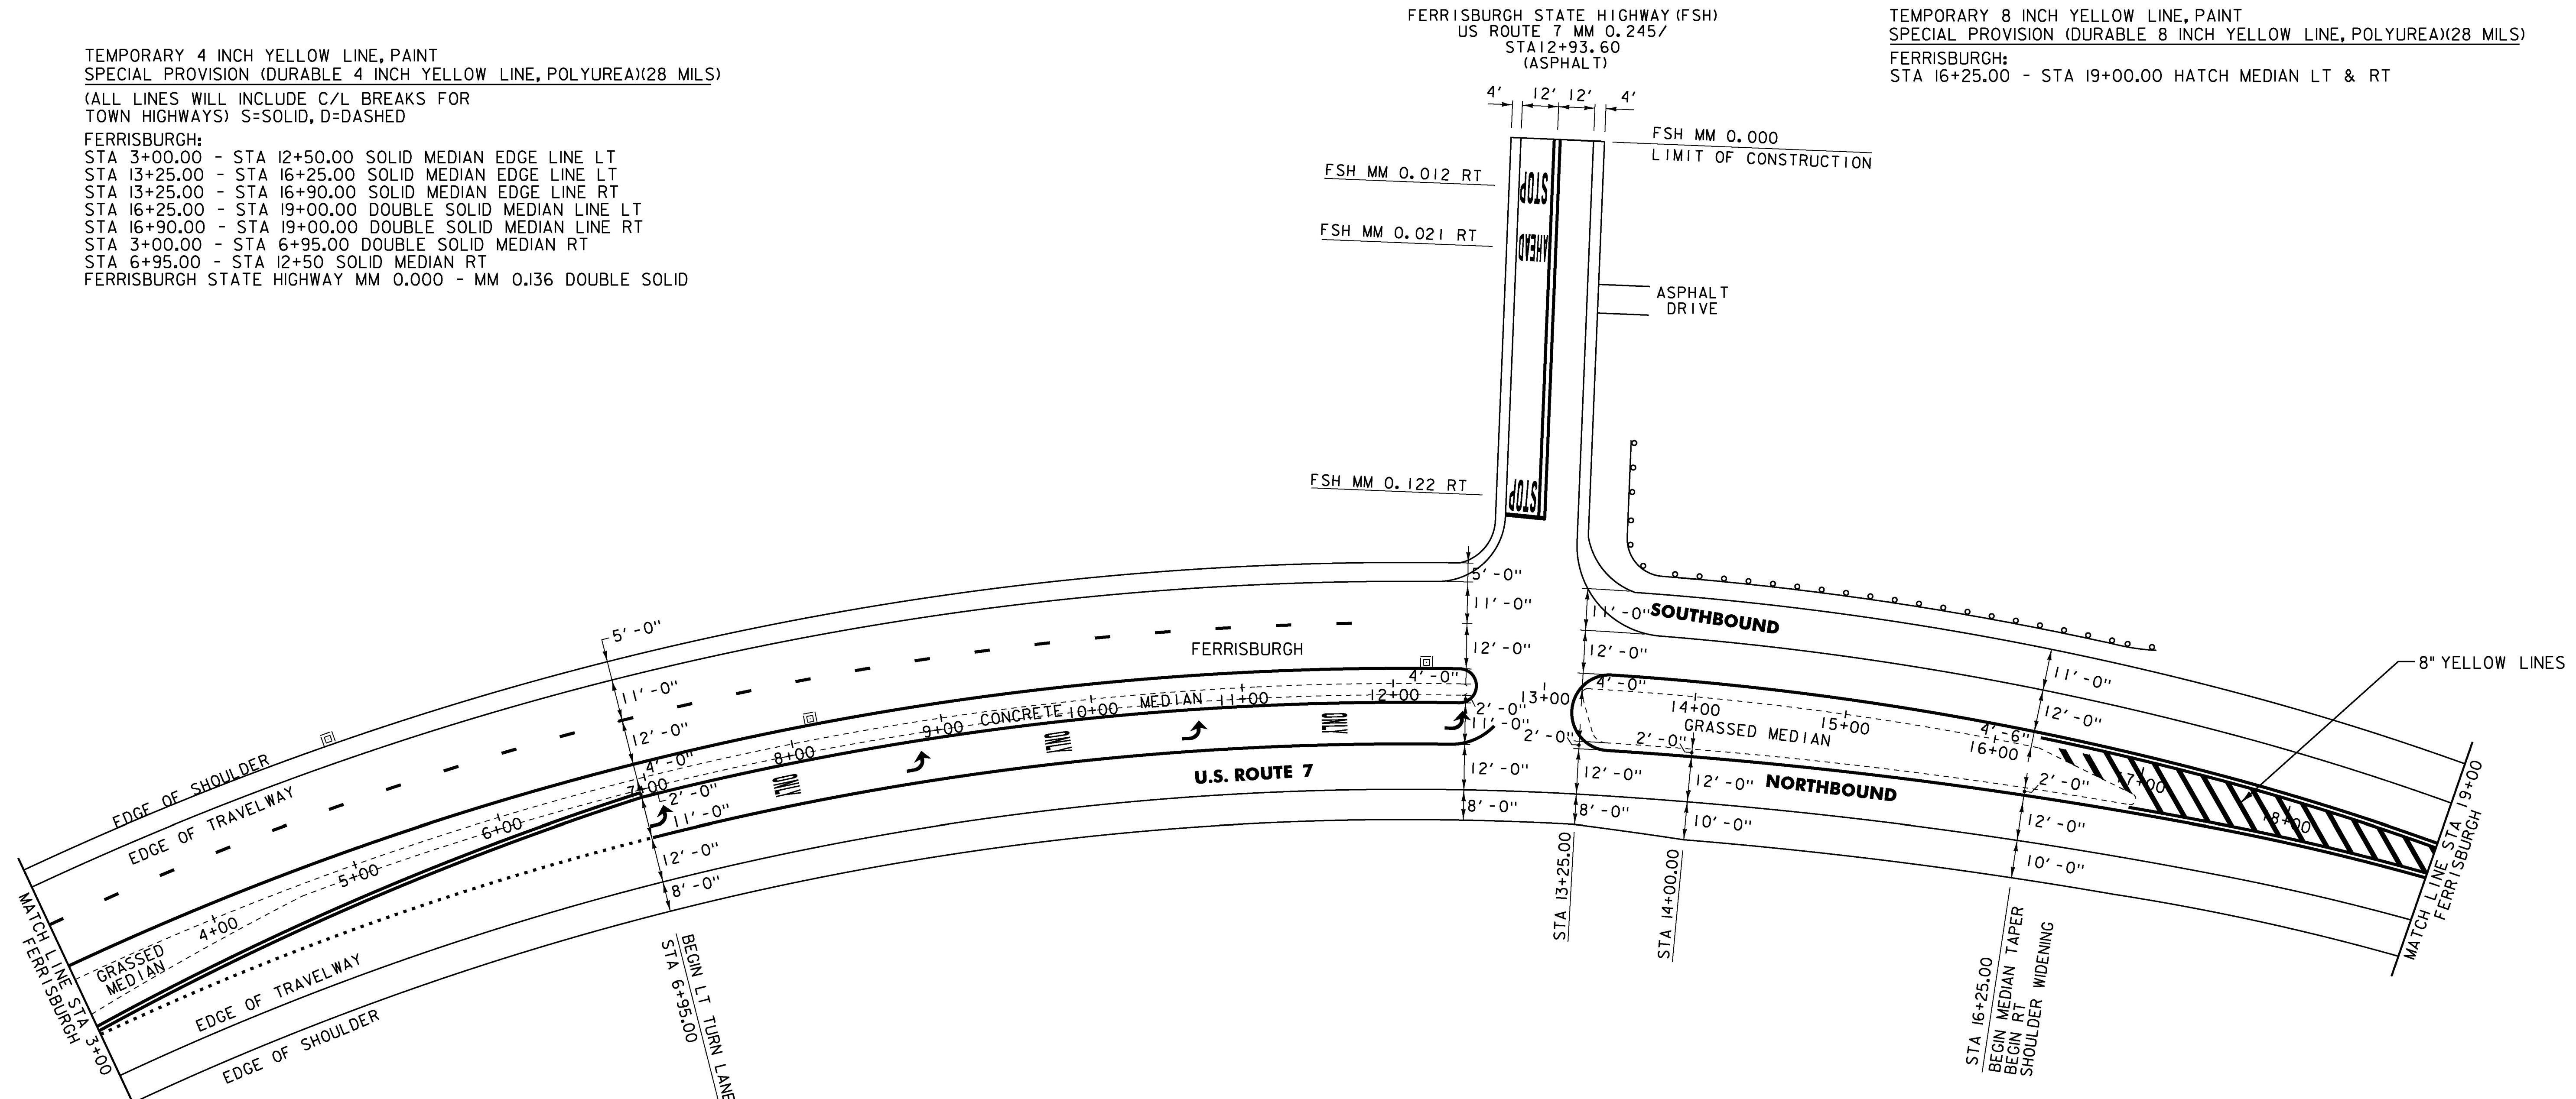

TEMPORARY 24 INCH STOP BAR, PAINT
 SPECIAL PROVISION (DURABLE 24 INCH STOP BAR, POLYUREA)(28 MILS) OR DURABLE 24 INCH STOP BAR, THERMOPLASTIC
 FERRISBURGH:
 STA 12+93.60 LT, NSH-FSH

CHANGING ELEV. OF DROP INLETS, CATCH BASINS, OR MANHOLES

FERRISBURGH:
 STA 8+15.0 LT (DID NOT ADJUST)
 STA 12+22.0 LT (DID NOT ADJUST)

NOT TO SCALE

| | |
|--------------------------------------|---------------------------|
| PROJECT NAME: MIDDLEBURY-FERRISBURGH | |
| PROJECT NUMBER: NH SURF(55) | |
| FILE NAME: pl5v015.dgn | PLOT DATE: 16-MAR-2016 |
| PROJECT LEADER: J. HARRINGTON | DRAWN BY: L. BULLOCK |
| DESIGNED BY: L. BULLOCK | CHECKED BY: J. HARRINGTON |
| PLAN SHEET 39 | SHEET 53 OF 96 |