

TEMPORARY 4 INCH WHITE LINE, PAINT
 SPECIAL PROVISION (DURABLE 4 INCH WHITE LINE, POLYUREA)(28 MILS)
 (ALL LINES WILL INCLUDE C/L BREAKS FOR TOWN HIGHWAYS) S=SOLID, D=DASHED
 FERRISBURGH:
 STA 35+00.00 - STA 51+00.00 LT & RT
 STA 35+12.00 - STA 36+75.00 SOLID LANE LINE LT
 STA 35+12.00 - STA 36+75.00 SOLID LANE LINE LT
 STA 36+75.00 - STA 38+55.00 DOTTED LT
 STA 36+75.00 - STA 38+55.00 DOTTED LT

TEMPORARY 4 INCH YELLOW LINE, PAINT
 SPECIAL PROVISION (DURABLE 4 INCH YELLOW LINE, POLYUREA)(28 MILS)
 (ALL LINES WILL INCLUDE C/L BREAKS FOR TOWN HIGHWAYS) S=SOLID, D=DASHED
 FERRISBURGH:
 STA 41+80.00 - STA 43+50.00 LT & RT
 STA 41+80.00 - STA 43+50.00 S - S
 STA 43+50.00 - STA 51+00.00 S - D
 STA 35+10.00 - STA 36+75.00 DOUBLE SOLID RT
 STA 36+75.00 - STA 41+80.00 DOUBLE SOLID MEDIAN LT&RT

TEMPORARY 8 INCH YELLOW LINE, PAINT
 SPECIAL PROVISION (DURABLE 8 INCH YELLOW LINE, POLYUREA)(28 MILS)
 FERRISBURGH:
 STA 36+75.0 - STA 41+80.0 HATCHED MEDIAN LT&RT


TEMPORARY 24 INCH STOP BAR, PAINT
 SPECIAL PROVISION (DURABLE 24 INCH STOP BAR, POLYUREA)(28 MILS) OR DURABLE 24 INCH STOP BAR, THERMOPLASTIC
 FERRISBURGH:
 STA 35+11.0 LT/RT

MILLED RUMBLE STRIPS (CENTERLINE)
 FERRISBURGH:
 STA. 43+85.00 - STA. 51+00.00
 STA. 44+00.00

TEMPORARY LETTER OR SYMBOL, PAINT

FERRISBURGH:
 STA 35+20.3 LT, ARROW (1EA)
 STA 35+20.3 RT, ARROW (1EA)
 STA 36+70.8 LT, ARROW (1EA)
 STA 36+70.8 RT, ARROW (1EA)
 STA 39+89.0 LT, "AHEAD" (5 EA)
 STA 40+21.0 LT, "SIGNAL" (6 EA)

SPECIAL PROVISION (DURABLE RAILROAD CROSSING SYMBOL, POLYUREA)(28 MILS)
 Ferrisburgh STA 36+75 RT
 Ferrisburgh STA 50+00 LT

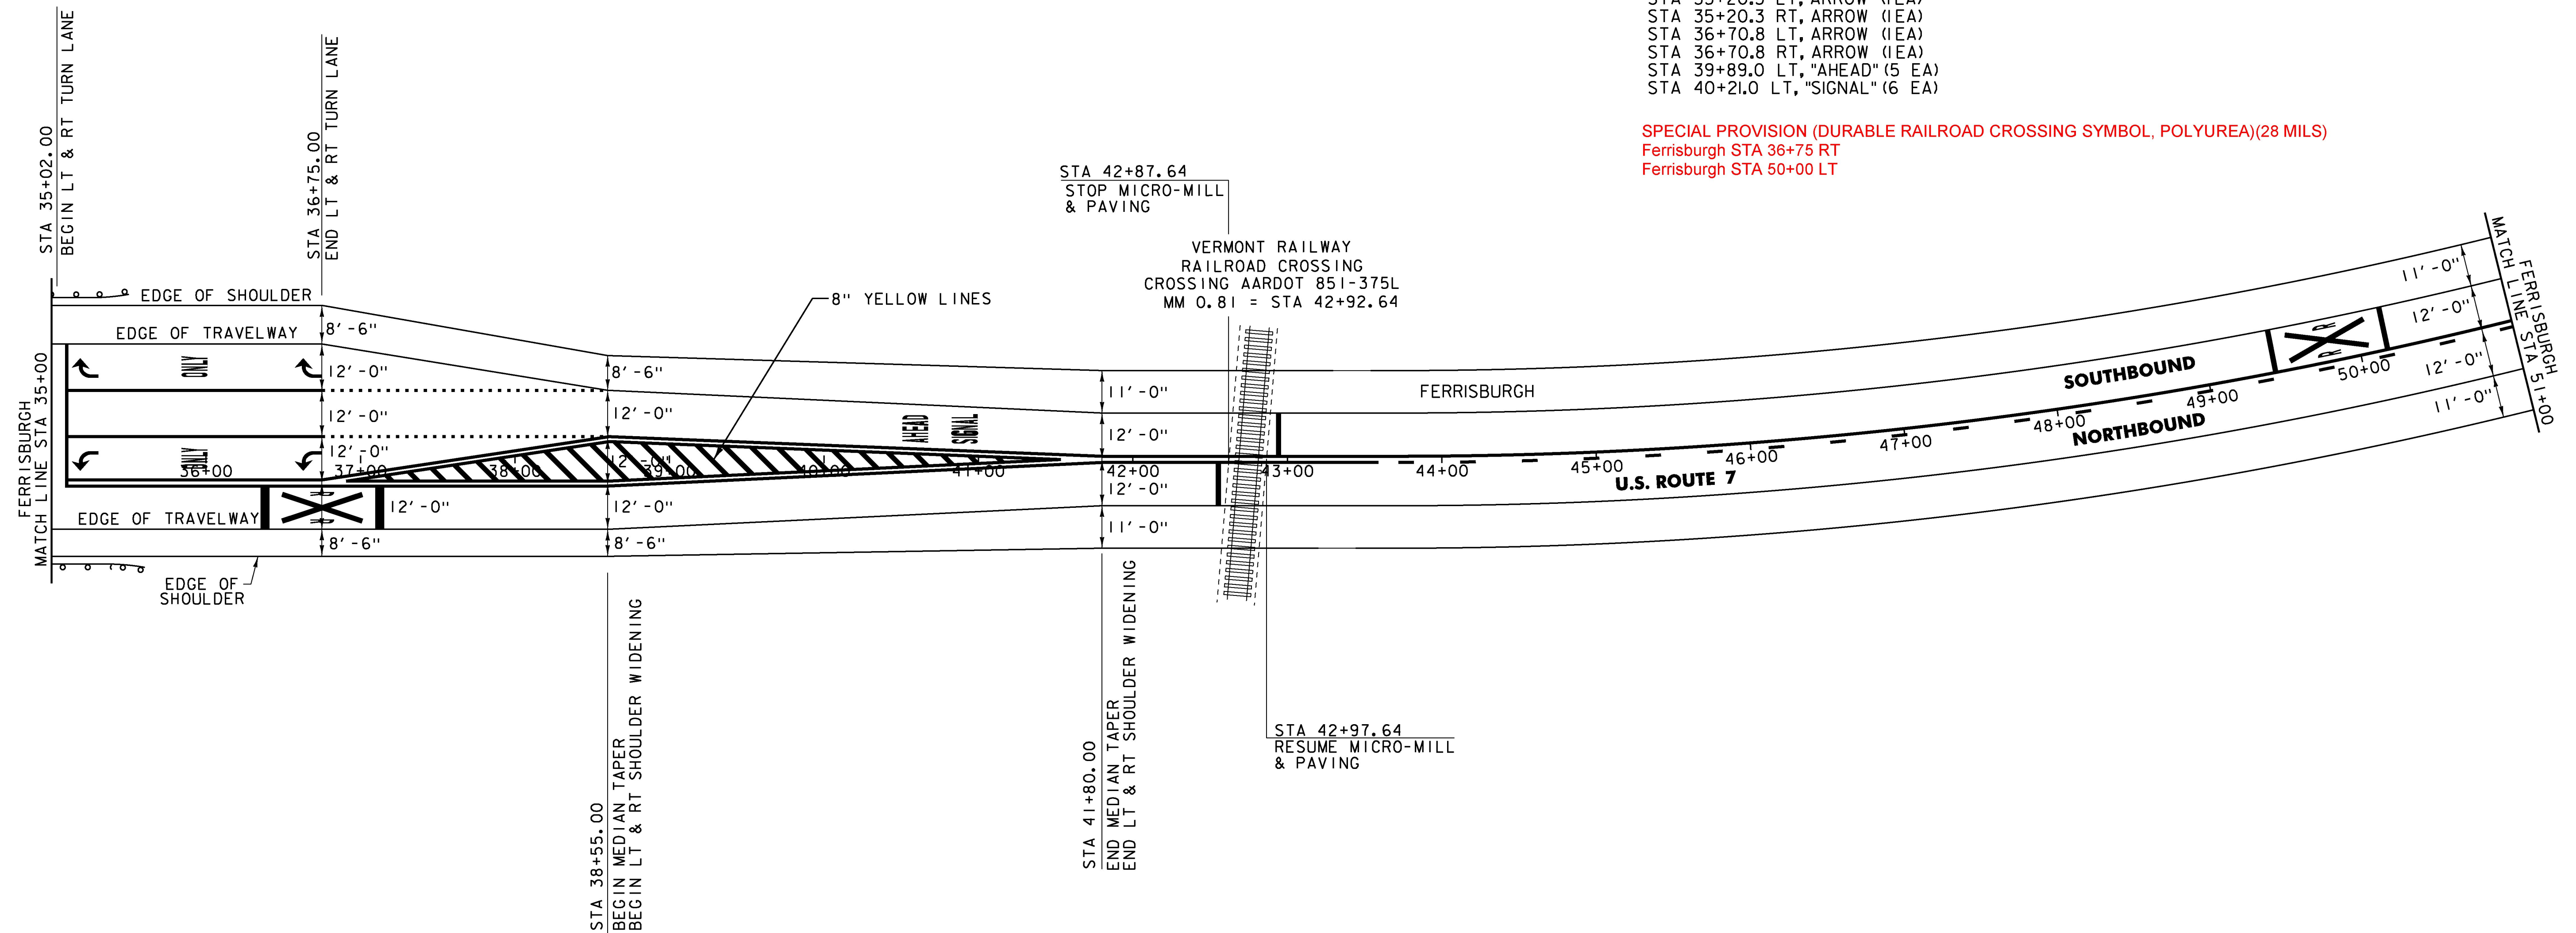

NOTE:

I. FOR RAILROAD PAVEMENT MARKING LAYOUT, SEE SIGNING AND STRIPING, PLAN B.

SPECIAL PROVISION (DURABLE LETTER OR SYMBOL, POLYUREA)(28 MILS) OR DURABLE LETTER OR SYMBO, THERMOPLASTIC

FERRISBURGH:
 STA 35+20.3 LT, ARROW (1EA)
 STA 35+20.3 RT, ARROW (1EA)
 STA 35+95.6 LT, "ONLY" (4 EA)
 STA 35+95.6 RT, "ONLY" (4 EA)
 STA 36+70.8 LT, ARROW (1EA)
 STA 36+70.8 RT, ARROW (1EA)
 STA 39+89.0 LT, "AHEAD" (5 EA)
 STA 40+21.0 LT, "SIGNAL" (6 EA)

NOT TO SCALE

PROJECT NAME: MIDDLEBURY-FERRISBURGH	
PROJECT NUMBER: NH SURF(55)	
FILE NAME: p15v015.dgn	PLOT DATE: 28-MAR-2016
PROJECT LEADER: J. HARRINGTON	DRAWN BY: L. BULLOCK
DESIGNED BY: L. BULLOCK	CHECKED BY: J. HARRINGTON
PLAN SHEET 41	SHEET 55 OF 96