


TEMPORARY 4 INCH WHITE LINE, PAINT
 SPECIAL PROVISION (DURABLE 4 INCH WHITE LINE, POLYUREA)(28 MILS)
 (ALL LINES WILL INCLUDE EDGE LINE BREAKS AND
 RADIUS FOR TOWN HIGHWAYS)
 FERRISBURGH:
 STA 99+00.00 - STA 115+00.00 LT & RT

TEMPORARY 4 INCH YELLOW LINE, PAINT
 SPECIAL PROVISION (DURABLE 4 INCH YELLOW LINE, POLYUREA)(28 MILS)
 (ALL LINES WILL INCLUDE C/L BREAKS FOR
 TOWN HIGHWAYS) S=SOLID, D=DASHED
 FERRISBURGH:
 STA 99+00.00 - STA 111+94.00 LT C RT
 STA 111+94.00 - STA 115+00.00 S - S
 STA 102+11.52 DOUBLE SOLID RT, TH-34 S - D
 STA 106+70.88 DOUBLE SOLID LT, TH-31 S - D

TEMPORARY 24 INCH STOP BAR, PAINT
 SPECIAL PROVISION (DURABLE 24 INCH STOP BAR, POLYUREA)(28 MILS) OR
 DURABLE 24 INCH STOP BAR, THERMOPLASTIC
 FERRISBURGH:
 STA 102+11.52 RT, TH-34
~~STA 106+70.88 LT, TH-31~~

MILLED RUMBLE STRIPS (CENTERLINE)
 FERRISBURGH:
 STA. 102+43.00 - STA. 106+50.88
 STA. 106+90.88 - STA. 115+00.00
 STA. 99+00.00 - STA. 99+84.00
 STA. 102+50.00 - STA. 106+61.00
 STA. 107+00.00 - STA. 115+00.00

TEMPORARY LETTER OR SYMBOL, PAINT
 SPECIAL PROVISION (DURABLE LETTER OR SYMBOL, POLYUREA)(28 MILS) OR
 DURABLE LETTER OR SYMBOL, THERMOPLASTIC
 FERRISBURGH:
 STA 102+11.52 RT, TH-34 "STOP" (4 EA)
 STA 106+70.88 LT, TH-31 "STOP" (4 EA)

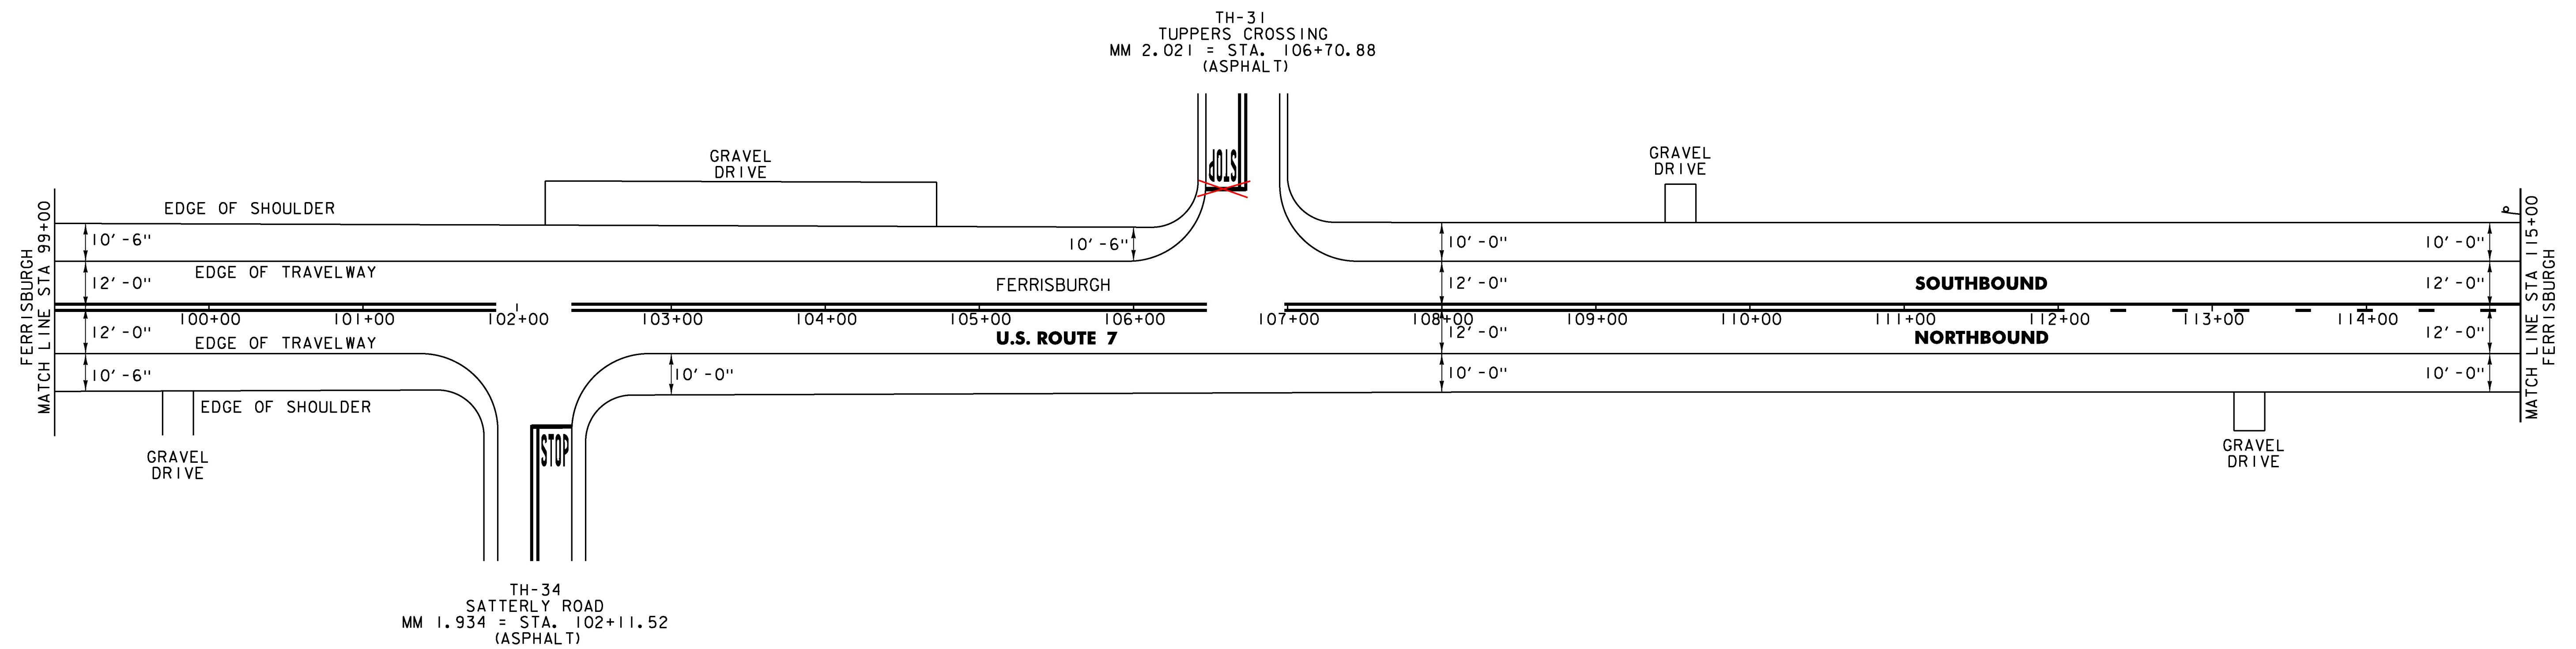

NOT TO SCALE

PROJECT NAME:	MIDDLEBURY-FERRISBURGH
PROJECT NUMBER:	NH SURF(55)
FILE NAME:	p15v015.dgn
PROJECT LEADER:	J. HARRINGTON
DESIGNED BY:	L. BULLOCK
PLAN SHEET 45	
PLOT DATE:	16-MAR-2016
DRAWN BY:	L. BULLOCK
CHECKED BY:	J. HARRINGTON
SHEET	59 OF 96