


TEMPORARY 4 INCH WHITE LINE, PAINT
 SPECIAL PROVISION (DURABLE 4 INCH WHITE LINE, POLYUREA)(28 MILS)
 (ALL LINES WILL INCLUDE EDGE LINE BREAKS AND
 RADIUS FOR TOWN HIGHWAYS)
 FERRISBURGH:
 STA 115+00.00 - STA 131+00.00 LT & RT

TEMPORARY 4 INCH YELLOW LINE, PAINT
 SPECIAL PROVISION (DURABLE 4 INCH YELLOW LINE, POLYUREA)(28 MILS)
 (ALL LINES WILL INCLUDE C/L BREAKS FOR
 TOWN HIGHWAYS) S=SOLID, D=DASHED
 FERRISBURGH:
 STA 115+00.00 - STA 119+85.00 LT C RT
 STA 119+85.00 - STA 126+72.00 S - D -
 STA 126+72.00 - STA 131+00.00 D - S

MILLED RUMBLE STRIPS (CENTERLINE)
 FERRISBURGH:
 STA. 115+00.00 - STA. 131+00.00

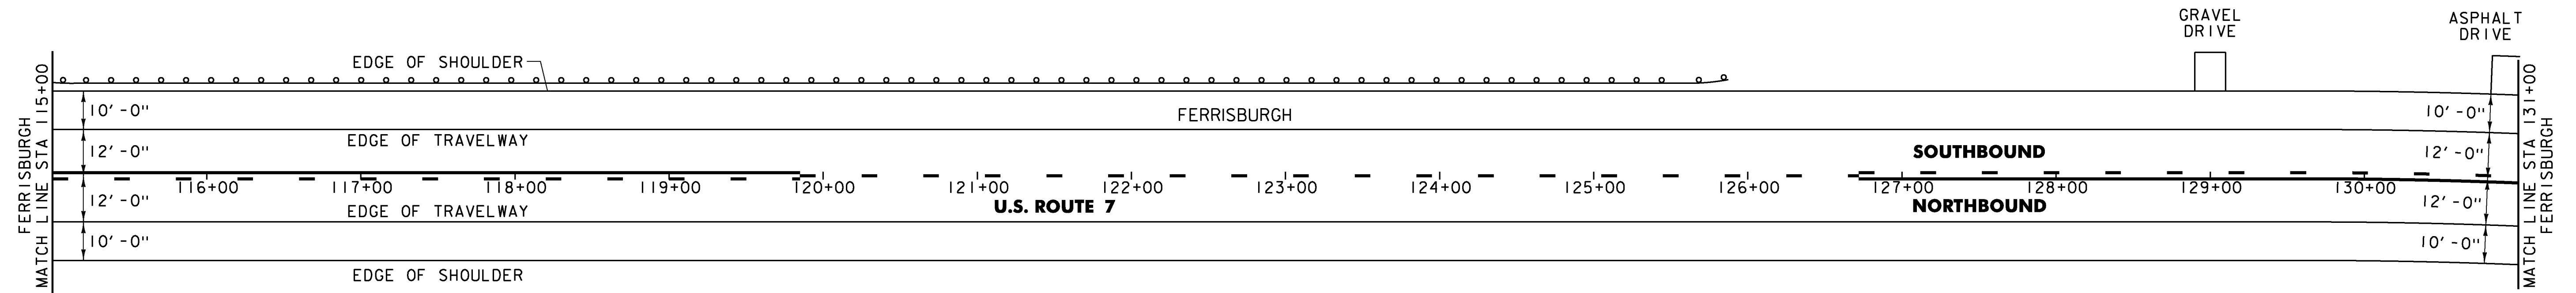

NOT TO SCALE

PROJECT NAME:	MIDDLEBURY-FERRISBURGH
PROJECT NUMBER:	NH SURF(55)
FILE NAME:	p15v015.dgn
PROJECT LEADER:	J. HARRINGTON
DESIGNED BY:	L. BULLOCK
PLAN SHEET	46
PLOT DATE:	16-MAR-2016
DRAWN BY:	L. BULLOCK
CHECKED BY:	J. HARRINGTON
SHEET	60 OF 96