


TEMPORARY 4 INCH WHITE LINE, PAINT  
 SPECIAL PROVISION (DURABLE 4 INCH WHITE LINE, POLYUREA)(28 MILS)  
 (ALL LINES WILL INCLUDE EDGE LINE BREAKS AND RADIUS FOR TOWN HIGHWAYS)  
 FERRISBURGH:  
 STA 131+00.0 - STA 147+00.0 LT & RT  
 STA 146+54.0 - STA 147+00.0 SOLID LT.

TEMPORARY 4 INCH YELLOW LINE, PAINT  
 SPECIAL PROVISION (DURABLE 4 INCH YELLOW LINE, POLYUREA)(28 MILS)  
 (ALL LINES WILL INCLUDE C/L BREAKS FOR TOWN HIGHWAYS) S=SOLID, D=DASHED  
 FERRISBURGH:  
 STA 131+00.0 - STA 135+17.0 LT C RT  
 STA 135+17.0 - STA 143+72.0 D - S  
 STA 146+54.0 - STA 147+00.0 S - S  
 STA 143+72.0 - STA 145+97.0 DOUBLE SOLID MEDIAN LT/RT

MILLED RUMBLE STRIPS (CENTERLINE)  
 FERRISBURGH:  
 STA. 131+00.00 - STA. 132+53.00  
 STA. 134+64.00 - STA. 142+03.00  
 STA. 131+00.00 - STA. 131+63.00  
 STA. 134+00.00 - STA. 142+00.00

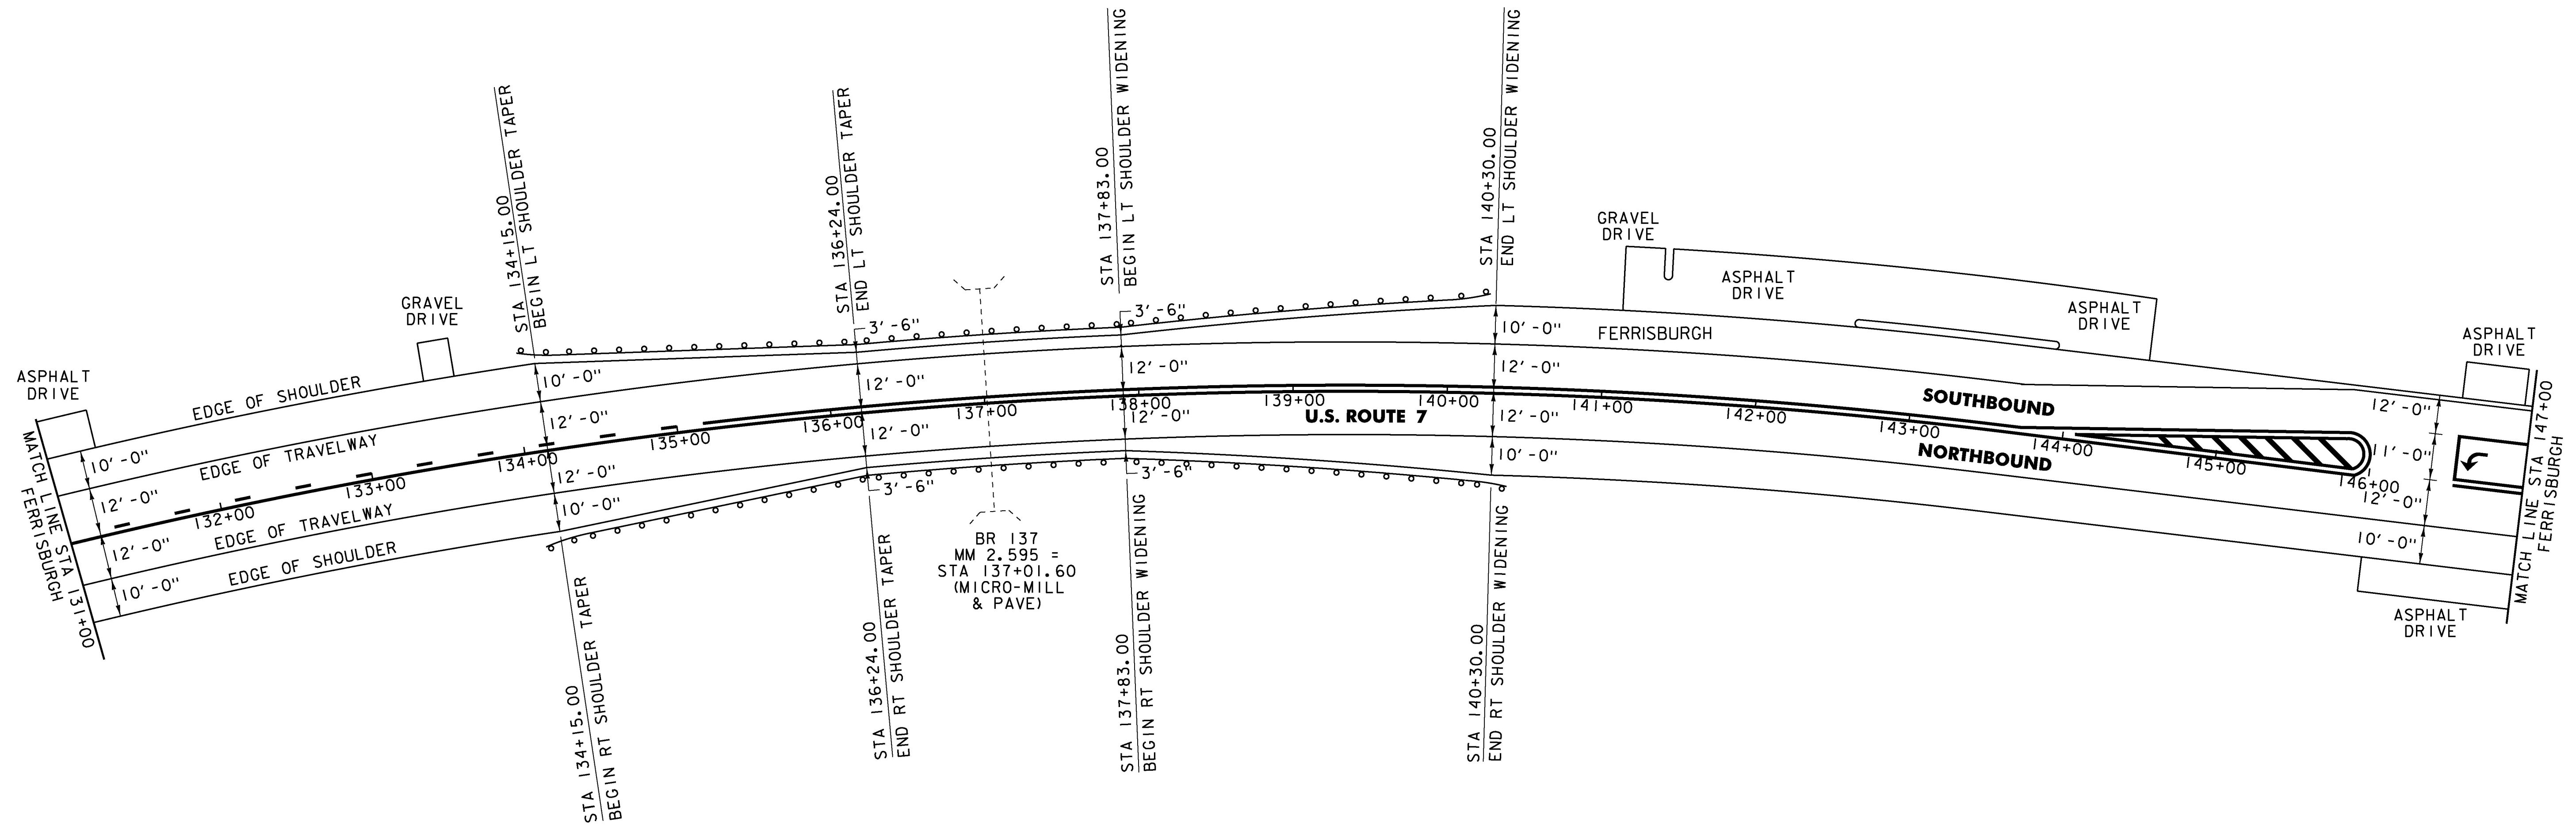

TEMPORARY LETTER OR SYMBOL, PAINT  
 SPECIAL PROVISION (DURABLE LETTER OR SYMBOL, POLYUREA)(28 MILS) OR DURABLE LETTER OR SYMBOL, THERMOPLASTIC  
 FERRISBURGH:  
 STA 146+68.0 LT. ARROW (IEA)

TEMPORARY 24 INCH STOP BAR, PAINT  
 SPECIAL PROVISION (DURABLE 24 INCH STOP BAR, POLYUREA)(28 MILS) OR DURABLE 24 INCH STOP BAR, THERMOPLASTIC  
 FERRISBURGH:  
 STA 146+54.0 LT

TEMPORARY 8 INCH YELLOW LINE, PAINT  
 SPECIAL PROVISION (DURABLE 8 INCH YELLOW LINE, POLYUREA)(28 MILS)  
 FERRISBURGH:  
 STA 143+72.0 - STA 145+97.0 HATCHED MEDIAN LT/RT

NOT TO SCALE

PROJECT NAME: MIDDLEBURY-FERRISBURGH	
PROJECT NUMBER: NH SURF(55)	
FILE NAME: pl5v015.dgn	PLOT DATE: 16-MAR-2016
PROJECT LEADER: J. HARRINGTON	DRAWN BY: L. BULLOCK
DESIGNED BY: L. BULLOCK	CHECKED BY: J. HARRINGTON
PLAN SHEET 47	SHEET 61 OF 96