

SPECIAL PROVISION (DURABLE LETTER OR SYMBOL, POLYUREA)(28 MILS) OR DURABLE LETTER OR SYMBOL, THERMOPLASTIC

FERRISBURGH:
 STA 147+7.00 LT "ONLY" (4 EA)
 STA 147+78.00 LT ARROW (1EA)
 STA 148+40.00 LT "ONLY" (4 EA)
 STA 148+93.00 LT ARROW (1EA)
 STA 149+57.00 LT ARROW (1EA)
 STA 150+18.00 LT "ONLY" (4 EA)
 STA 150+75.00 LT ARROW (1EA)
 STA 159+52.98 RT "SIGNAL" (6 EA)
 STA 159+69.43 RT "AHEAD" (5 EA)
 STA 161+97.49 CL ARROW (1EA)
 STA 162+70.95 CL "ONLY" (4 EA)

SPECIAL PROVISION (DURABLE 4 INCH WHITE LINE, POLYUREA)(28 MILS)

(ALL LINES WILL INCLUDE EDGE LINE BREAKS AND RADIUS FOR TOWN HIGHWAYS)
 FERRISBURGH:
 STA 147+00.00 - STA 163+00.00 EDGE LINE LT & RT
 STA 147+00.00 - STA 149+04.00 SOLID LT
 STA 149+43.00 - STA 150+93.00 SOLID LT
 STA 150+93.00 - STA 152+68.00 DOTTED LT
 STA 160+12.00 - STA 161+92.00 DOTTED RT
 STA 161+92.00 - STA 163+00.00 SOLID RT

SPECIAL PROVISION (DURABLE 4 INCH YELLOW LINE, POLYUREA)(28 MILS)


(ALL LINES WILL INCLUDE C/L BREAKS FOR TOWN HIGHWAYS) S=SOLID, D=DASHED
 FERRISBURGH:
 STA 147+00.00 - STA 149+01.00 LT C RT S - S
 STA 149+42.00 - STA 150+92.00 S - S
 STA 154+93.00 - STA 158+65.00 S - S
 STA 150+92.00 - STA 154+93.00 DOUBLE SOLID MEDIAN LT & RT
 STA 158+65.00 - STA 161+92.00 DOUBLE SOLID MEDIAN LT & RT
 STA 161+92.00 - STA 163+00.00 DOUBLE SOLID LT

CHANGING ELEV. OF DROP INLETS, CATCH BASINS, OR MANHOLES

FERRISBURGH:
 STA 160+73.0 LT (DID NOT ADJUST)
 STA 162+39.0 RT (DID NOT ADJUST)

TEMPORARY 4 INCH YELLOW LINE, PAINT
 (ALL LINES WILL INCLUDE C/L BREAKS FOR TOWN HIGHWAYS) S=SOLID, D=DASHED

FERRISBURGH:
 STA 147+00.00 - STA 149+01.00 LT C RT S - S
 STA 149+42.00 - STA 150+92.00 S - S
 STA 154+93.00 - STA 158+65.00 S - S
 STA 150+92.00 - STA 154+93.00 DOUBLE SOLID MEDIAN LT & RT

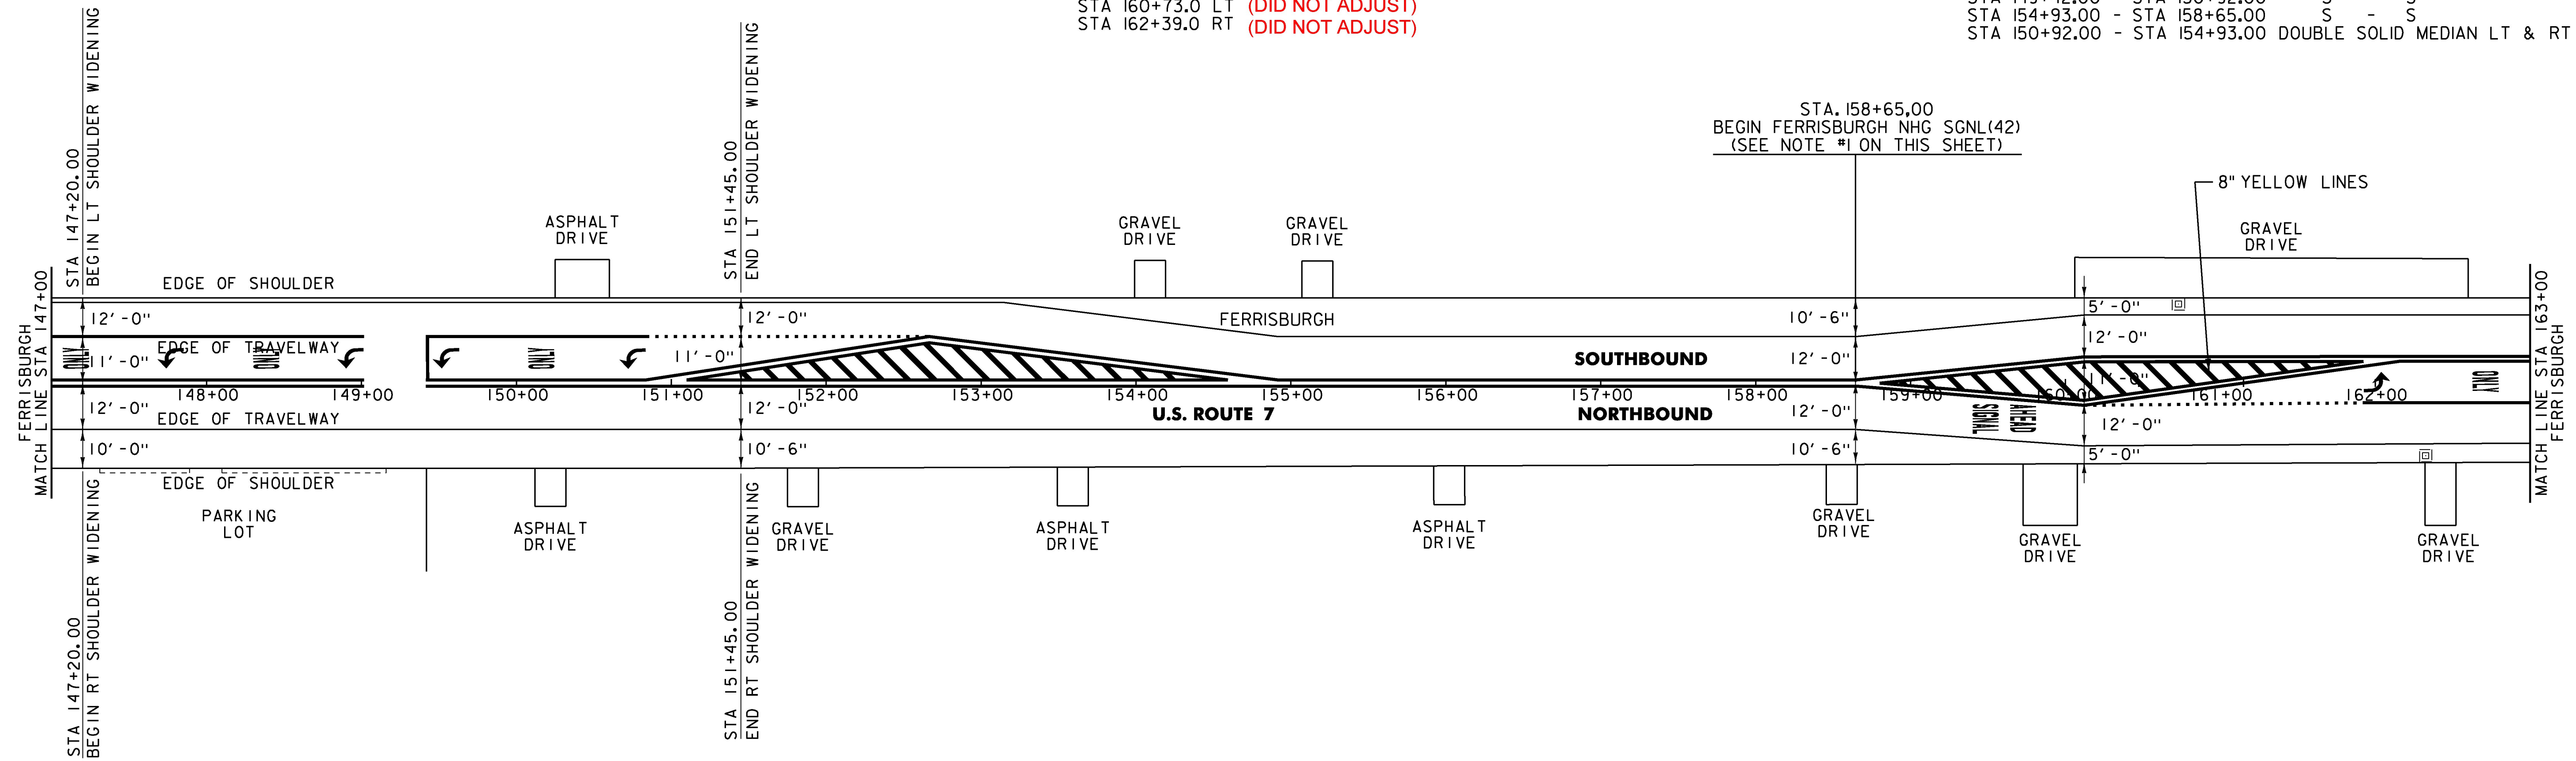

TEMPORARY 4 INCH WHITE LINE, PAINT
 (ALL LINES WILL INCLUDE EDGE LINE BREAKS AND RADIUS FOR TOWN HIGHWAYS)

FERRISBURGH:
 STA 147+00.00 - STA 158+65.00 EDGE LINE LT & RT
 STA 147+00.00 - STA 149+04.00 SOLID LT
 STA 149+43.00 - STA 150+93.00 SOLID LT
 STA 150+93.00 - STA 152+68.00 DOTTED LT

SPECIAL PROVISION (DURABLE 8 INCH YELLOW LINE, POLYUREA)(28 MILS)

FERRISBURGH:
 STA 158+65.00 - STA 161+92.00 HATCHED MEDIAN LT & RT
 STA 150+92.00 - STA 154+93.00 HATCHED MEDIAN LT & RT

TEMPORARY 8 INCH YELLOW LINE, PAINT

FERRISBURGH:
 STA 150+92.00 - STA 154+93.00 HATCHED MEDIAN LT & RT

TEMPORARY LETTER OR SYMBOL, PAINT

FERRISBURGH:
 STA 147+78.0 LT ARROW (1EA)
 STA 148+93.0 LT ARROW (1EA)
 STA 149+57.0 LT ARROW (1EA)
 STA 150+75.0 LT ARROW (1EA)

TEMPORARY 24 INCH STOP BAR, PAINT
 SPECIAL PROVISION (DURABLE 24 INCH STOP BAR, POLYUREA)(28 MILS) OR DURABLE 24 INCH STOP BAR, THERMOPLASTIC

FERRISBURGH:
 STA 149+43.00 LT

NOTE:

- A NEW SIGNAL WILL BE INSTALLED AT THE INTERSECTION OF US RTE. 7 AND LITTLE CHICAGO ROAD/MIDDLE BROOK ROAD AS PART OF THE NHG SGNL(42) PROJECT. TEMPORARY MARKINGS WITHIN THE NHG SGNL(42) PROJECT SHALL BE INSTALLED AS PART OF THAT PROJECT.

NOT TO SCALE

PROJECT NAME: MIDDLEBURY-FERRISBURGH	
PROJECT NUMBER: NH SURF(55)	
FILE NAME: p15v015.dgn	PLOT DATE: 16-MAR-2016
PROJECT LEADER: J. HARRINGTON	DRAWN BY: L. BULLOCK
DESIGNED BY: L. BULLOCK	CHECKED BY: J. HARRINGTON
PLAN SHEET 48	SHEET 62 OF 96