

SPECIAL PROVISION (DURABLE 4 INCH WHITE LINE, POLYUREA)(28 MILS)
 (ALL LINES WILL INCLUDE EDGE LINE BREAKS AND RADIUS FOR TOWN HIGHWAYS)

FERRISBURGH:
 STA 163+00.00 - STA 179+00.00 EDGE LINE LT & RT
 STA 163+00.00 - STA 163+80.00 SOLID RT
 STA 165+59.00 - STA 167+26.00 SOLID LT
 STA 167+26.00 - STA. 169+06.00 DOTTED LT

TEMPORARY 4 INCH WHITE LINE, PAINT
 (ALL LINES WILL INCLUDE EDGE LINE BREAKS AND RADIUS FOR TOWN HIGHWAYS)

FERRISBURGH:
 STA 170+53.00 - STA. 179+00.00 EDGE LINE LT & RT

TEMPORARY 4 INCH YELLOW LINE, PAINT
 (ALL LINES WILL INCLUDE C/L BREAKS FOR TOWN HIGHWAYS) S=SOLID, D=DASHED

FERRISBURGH:
 STA 170+53.00 - STA 179+00.00 LT S - RT S

SPECIAL PROVISION (DURABLE 4 INCH YELLOW LINE, POLYUREA)(28 MILS)
 (ALL LINES WILL INCLUDE C/L BREAKS FOR TOWN HIGHWAYS) S=SOLID, D=DASHED

FERRISBURGH:
 STA 170+53.00 - STA 179+00.00 LT S - RT S
 STA 163+00.00 - STA 163+52.00 DOUBLE SOLID LT
 STA 165+79.00 - STA 167+26.00 DOUBLE SOLID RT
 STA 167+26.00 - STA 170+53.00 DOUBLE SOLID MEDIAN LT & RT
 STA 10+80.00 - STA 11+50.00 DOUBLE SOLID LT (TH-5)
 STA 20+80.00 - STA 20+92.00 DOUBLE SOLID RT (TH-14)

SPECIAL PROVISION (DURABLE 8 INCH YELLOW LINE, POLYUREA)(28 MILS)


FERRISBURGH:
 STA 167+26.00 - STA 170+53.00 HATCHED MEDIAN LT & RT

SPECIAL PROVISION (DURABLE 24 INCH STOP BAR, POLYUREA)(28 MILS) OR DURABLE 24 INCH STOP BAR, THERMOPLASTIC

FERRISBURGH:
 STA 163+52.00 CL
 STA 163+80.00 RT
 STA 10+80.00 LT (TH-5)
 STA 20+80.00 LT (TH-14)
 STA 165+59.00 CL
 STA 165+79.00 LT

SPECIAL PROVISION (DURABLE LETTER OR SYMBOL, POLYUREA)(28 MILS) OR DURABLE LETTER OR SYMBOL, THERMOPLASTIC

FERRISBURGH:
 STA 163+40.79 CL ARROW (1EA)
 STA 165+87.52 CL ARROW (1EA)
 STA 166+52.03 CL "ONLY" (4 EA)
 STA 167+10.27 CL ARROW (1EA)
 STA 169+30.71 LT "AHEAD" (5 EA)
 STA 169+46.79 LT "SIGNAL" (6 EA)

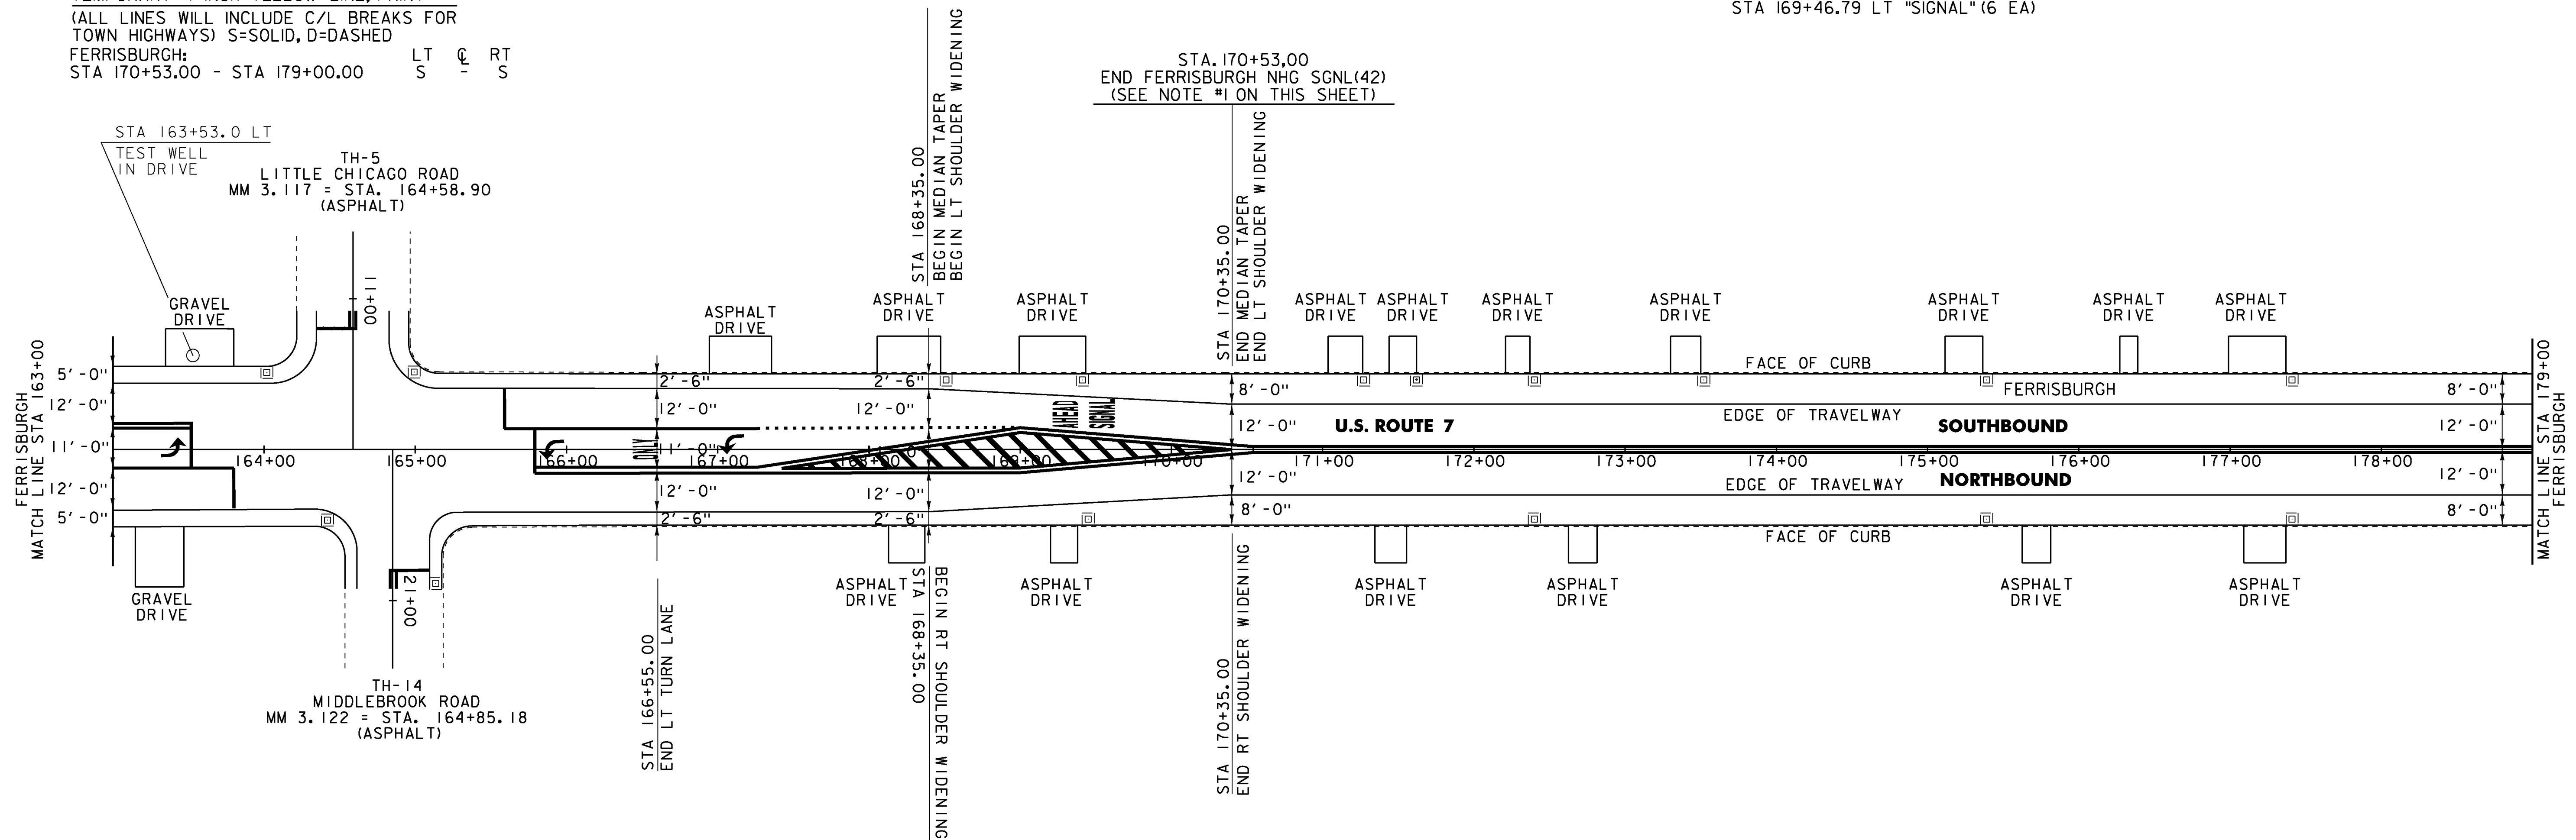

CHANGING ELEV. OF DROP INLETS, CATCH BASINS, OR MANHOLES

FERRISBURGH:
 STA 164+42.0 RT
 STA 164+70.0 LT
 STA 165+67.0 LT
 STA 165+95.0 RT (TH-14)
 STA 168+51.0 LT
 STA 169+41.0 LT
 STA 169+45.0 RT
 STA 171+27.0 LT
 STA 171+62.0 LT
 STA 172+40.0 LT
 STA 172+40.0 RT
 STA 173+52.0 LT
 STA 175+39.0 LT
 STA 175+39.0 RT
 STA 177+41.0 LT
 STA 177+41.0 RT

(DID NOT ADJUST)

NOTE:

1. A NEW SIGNAL WILL BE INSTALLED AT THE INTERSECTION OF US RTE. 7 AND LITTLE CHICAGO ROAD/MIDDLE BROOK ROAD AS PART OF THE NHG SGNL(42) PROJECT. TEMPORARY MARKINGS WITHIN THE NHG SGNL(42) PROJECT SHALL BE INSTALLED AS PART OF THAT PROJECT.

NOT TO SCALE

PROJECT NAME:	MIDDLEBURY-FERRISBURGH
PROJECT NUMBER:	NH SURF(55)
FILE NAME:	pl5v015.dgn
DESIGNED BY:	L. BULLOCK
PROJECT LEADER:	J. HARRINGTON
CHECKED BY:	J. HARRINGTON
PLAN SHEET 49	SHEET 63 OF 96
PLOT DATE:	16-MAR-2016
DRAWN BY:	L. BULLOCK