


TEMPORARY 4 INCH WHITE LINE, PAINT
 SPECIAL PROVISION (DURABLE 4 INCH WHITE LINE, POLYUREA)(28 MILS)
 (ALL LINES WILL INCLUDE EDGE LINE BREAKS AND
 RADIUS FOR TOWN HIGHWAYS)
 FERRISBURGH:
 STA 179+00.00 - STA.195+00.00 LT & RT

TEMPORARY 4 INCH YELLOW LINE, PAINT
 SPECIAL PROVISION (DURABLE 4 INCH YELLOW LINE, POLYUREA)(28 MILS)
 (ALL LINES WILL INCLUDE C/L BREAKS FOR
 TOWN HIGHWAYS) S=SOLID, D=DASHED
 FERRISBURGH:
 STA 179+00.00 - STA 195+00.00 LT C RT
 S - S

TEMPORARY 8 INCH WHITE LINE, PAINT
 SPECIAL PROVISION (DURABLE 8 INCH WHITE LINE, POLYUREA)(28 MILS)
 FERRISBURGH:
 STA 182+64.00 - STA 182+76.00 RT. NO PARKING FIRE HYDRANT

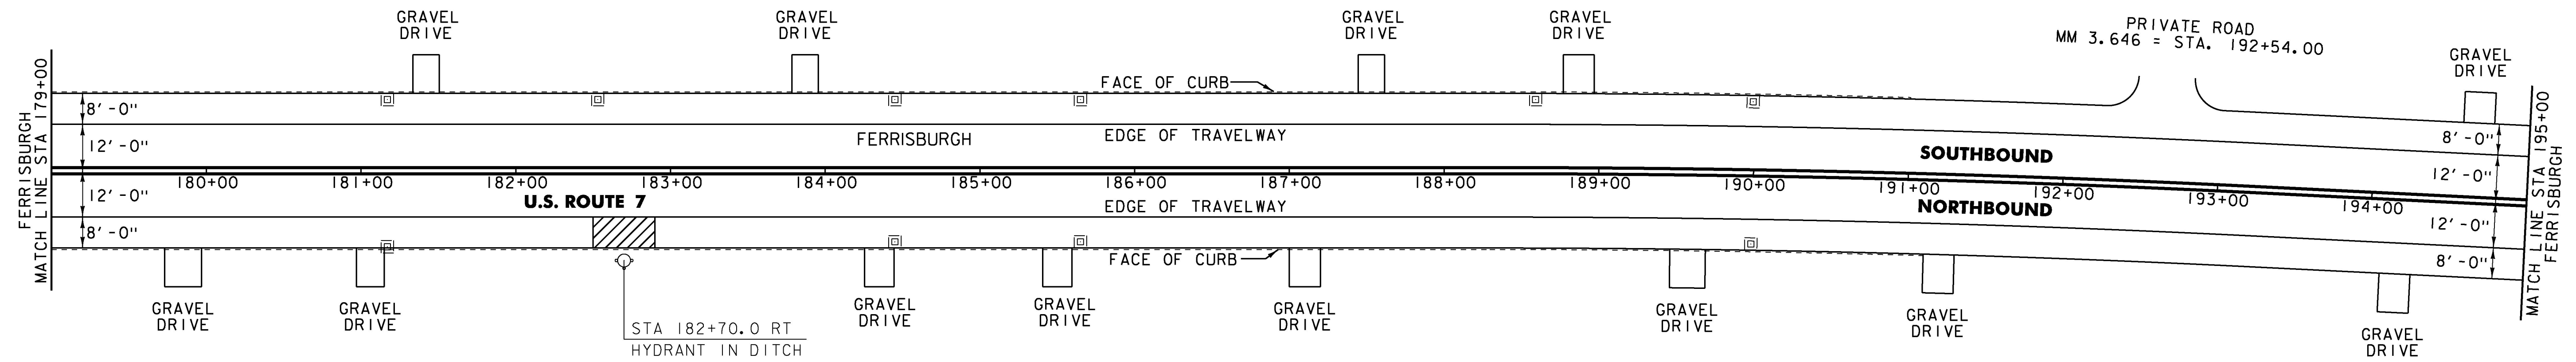

CHANGING ELEV. OF DROP INLETS, CATCH BASINS, OR MANHOLES

FERRISBURGH:
 STA 181+17.0 LT
 STA 181+17.0 RT
 STA 182+53.0 LT
 STA 184+45.0 LT
 STA 184+45.0 RT
 STA 185+65.0 LT
 STA 185+65.0 RT
 STA 188+59.0 LT
 STA 190+99.0 LT
 STA 190+99.0 RT

(DID NOT ADJUST)

NOT TO SCALE

PROJECT NAME:	MIDDLEBURY-FERRISBURGH
PROJECT NUMBER:	NH SURF(55)
FILE NAME: p15v015.dgn	PLOT DATE: 16-MAR-2016
PROJECT LEADER: J. HARRINGTON	DRAWN BY: L. BULLOCK
DESIGNED BY: L. BULLOCK	CHECKED BY: J. HARRINGTON
PLAN SHEET 50	SHEET 64 OF 96