


TEMPORARY 4 INCH WHITE LINE, PAINT
 SPECIAL PROVISION (DURABLE 4 INCH WHITE LINE, POLYUREA)(28 MILS)
 (ALL LINES WILL INCLUDE EDGE LINE BREAKS AND
 RADIUS FOR TOWN HIGHWAYS)
 FERRISBURGH:
 STA 195+00.00 - STA. 211+00.00 LT & RT

TEMPORARY 4 INCH YELLOW LINE, PAINT
 SPECIAL PROVISION (DURABLE 4 INCH YELLOW LINE, POLYUREA)(28 MILS)
 (ALL LINES WILL INCLUDE C/L BREAKS FOR
 TOWN HIGHWAYS) S=SOLID, D=DASHED
 FERRISBURGH:
 STA 195+00.00 - STA 206+44.00 LT C RT
 STA 195+00.00 - STA 206+44.00 S - S
 STA 206+44.00 - STA 210+44.00 S - D
 STA 210+44.00 - STA 211+00.00 - D -

~~MILLED RUMBLE STRIPS (CENTERLINE)~~
 FERRISBURGH:
 STA. 206+45.00 - STA. 211+00.00

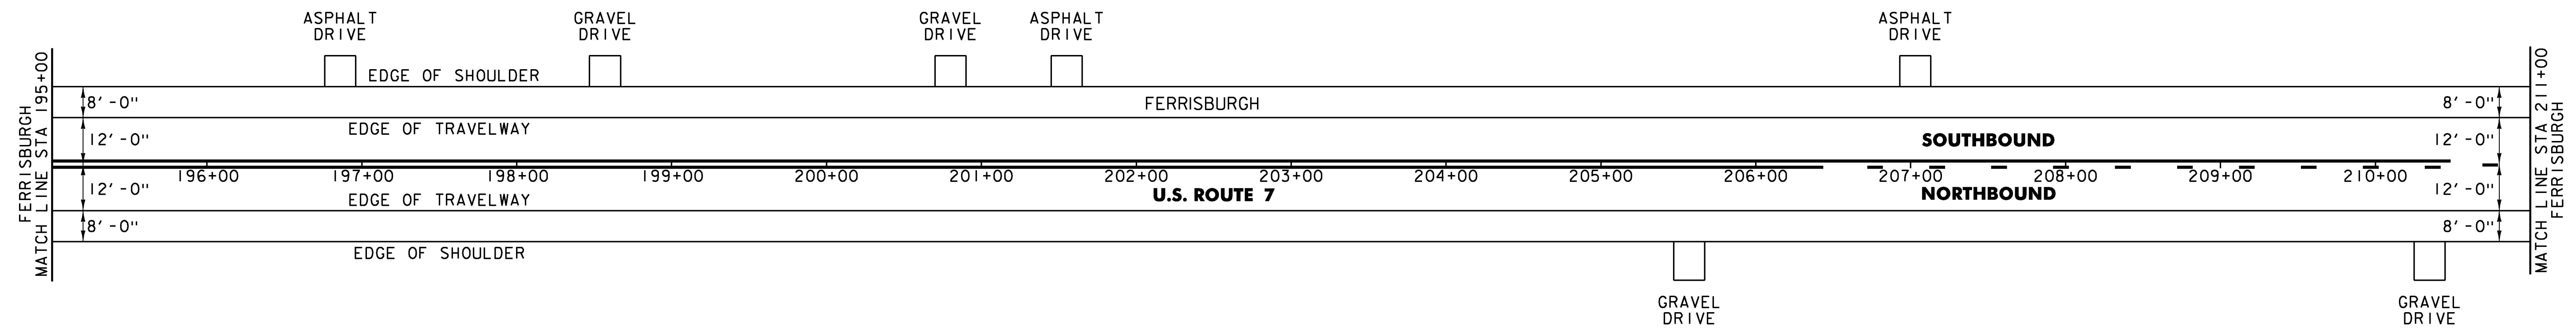

NOT TO SCALE

PROJECT NAME:	MIDDLEBURY-FERRISBURGH
PROJECT NUMBER:	NH SURF(55)
FILE NAME:	p15v015.dgn
PROJECT LEADER:	J. HARRINGTON
DESIGNED BY:	L. BULLOCK
PLAN SHEET 51	
PLOT DATE:	16-MAR-2016
DRAWN BY:	L. BULLOCK
CHECKED BY:	J. HARRINGTON
SHEET	65 OF 96