


TEMPORARY 4 INCH WHITE LINE, PAINT  
 SPECIAL PROVISION (DURABLE 4 INCH WHITE LINE, POLYUREA)(28 MILS)  
 (ALL LINES WILL INCLUDE EDGE LINE BREAKS AND  
 RADIUS FOR TOWN HIGHWAYS)  
 FERRISBURGH:  
 STA 243+00.00 - STA. 259+00.00 LT & RT

TEMPORARY 4 INCH YELLOW LINE, PAINT  
 SPECIAL PROVISION (DURABLE 4 INCH YELLOW LINE, POLYUREA)  
 (ALL LINES WILL INCLUDE C/L BREAKS FOR  
 TOWN HIGHWAYS) S=SOLID, D=DASHED  
 FERRISBURGH:  
 STA 243+00.00 - STA 247+63.00 S - S  
 STA 247+63.00 - STA 251+85.00 S - D  
 STA 251+85.00 - STA 255+55.00 - D -  
 STA 255+55.00 - STA 259+00.00 D - S

MILLED RUMBLE STRIPS (CENTERLINE)  
 FERRISBURGH:  
 STA. 244+46.00 - STA. 259+00.00  
 STA. 245+00.00

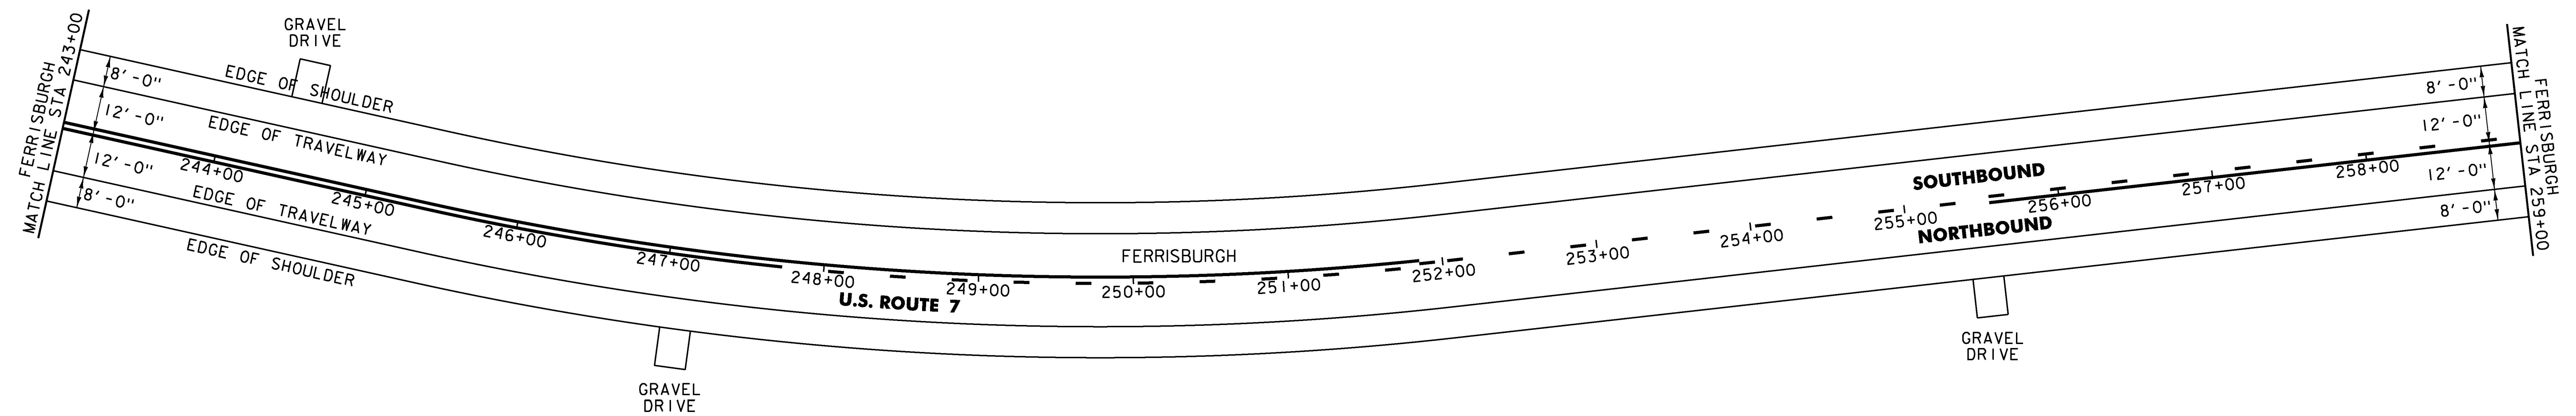

NOT TO SCALE

PROJECT NAME: MIDDLEBURY-FERRISBURGH	
PROJECT NUMBER: NH SURF(55)	
FILE NAME: pl5v015.dgn	PLOT DATE: 16-MAR-2016
PROJECT LEADER: J. HARRINGTON	DRAWN BY: L. BULLOCK
DESIGNED BY: L. BULLOCK	CHECKED BY: J. HARRINGTON
PLAN SHEET 54	SHEET 68 OF 96