


TEMPORARY 4 INCH WHITE LINE, PAINT  
 SPECIAL PROVISION (DURABLE 4 INCH WHITE LINE, POLYUREA)(28 MILS)  
 (ALL LINES WILL INCLUDE EDGE LINE BREAKS AND  
 RADIUS FOR TOWN HIGHWAYS)  
 FERRISBURGH:  
 STA 259+00.00 - STA. 275+00.00 LT & RT

TEMPORARY 4 INCH YELLOW LINE, PAINT  
 SPECIAL PROVISION (DURABLE 4 INCH YELLOW LINE, POLYUREA)(28 MILS)  
 (ALL LINES WILL INCLUDE C/L BREAKS FOR  
 TOWN HIGHWAYS) S=SOLID, D=DASHED  
 FERRISBURGH:  
 STA 259+00.00 - STA 264+80.00 D - S  
 STA 264+80.00 - STA 272+98.00 S - S  
 STA 272+98.00 - STA 275+00.00 S - D

MILLED RUMBLE STRIPS (CENTERLINE)  
 FERRISBURGH:  
~~STA. 259+00.00 - STA. 264+00.00~~  
~~STA. 269+28.00 - STA. 274+56.00~~  
 STA. 259+00.00 - STA. 264+43.00  
 STA. 269+80.00 - STA. 275+00.00

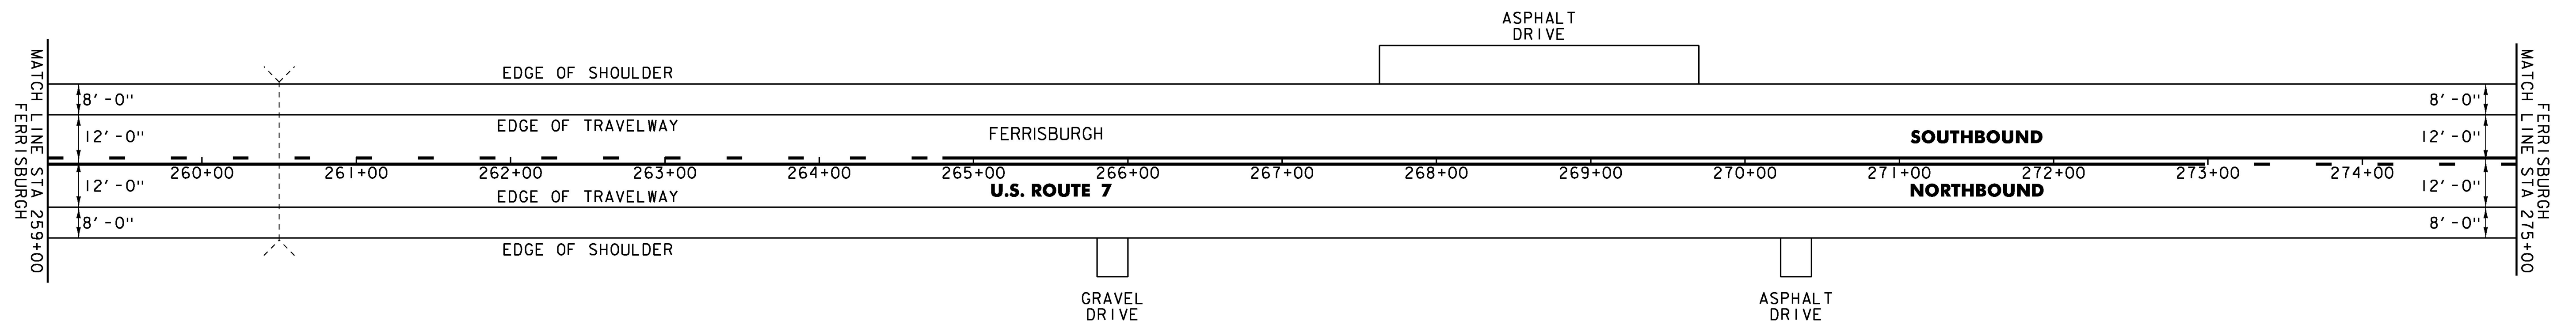

NOT TO SCALE

PROJECT NAME: MIDDLEBURY-FERRISBURGH	
PROJECT NUMBER: NH SURF(55)	
FILE NAME: p15v015.dgn	PLOT DATE: 16-MAR-2016
PROJECT LEADER: J. HARRINGTON	DRAWN BY: L. BULLOCK
DESIGNED BY: L. BULLOCK	CHECKED BY: J. HARRINGTON
PLAN SHEET 55	SHEET 69 OF 96