


TEMPORARY 4 INCH WHITE LINE, PAINT
 SPECIAL PROVISION (DURABLE 4 INCH WHITE LINE, POLYUREA)(28 MILS)
 (ALL LINES WILL INCLUDE EDGE LINE BREAKS AND
 RADIUS FOR TOWN HIGHWAYS)
 FERRISBURGH:
 STA 275+00.00 - STA. 291+00.00 LT & RT

TEMPORARY 4 INCH YELLOW LINE, PAINT
 SPECIAL PROVISION (DURABLE 4 INCH YELLOW LINE, POLYUREA)(28 MILS)
 (ALL LINES WILL INCLUDE C/L BREAKS FOR
 TOWN HIGHWAYS) S=SOLID, D=DASHED
 FERRISBURGH:
 STA 275+00.00 - STA 275+10.00 LT C RT
 STA 275+10.00 - STA 290+40.00 S - D -
 STA 290+40.00 - STA 291+00.00 D - S

MILLED RUMBLE STRIPS (CENTERLINE)
 FERRISBURGH:
 STA. 275+00.00 - STA. 275+30.00

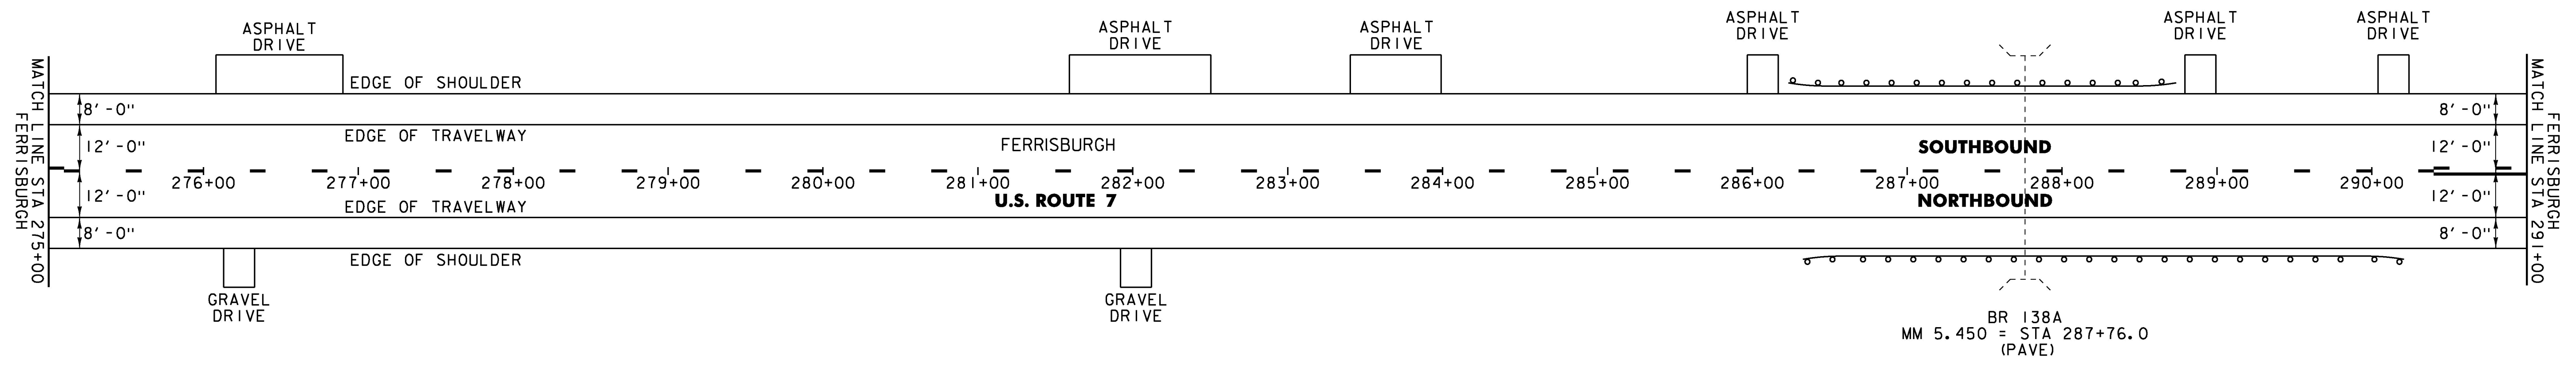

NOT TO SCALE

PROJECT NAME: MIDDLEBURY-FERRISBURGH	
PROJECT NUMBER: NH SURF(55)	
FILE NAME: p15v015.dgn	PLOT DATE: 16-MAR-2016
PROJECT LEADER: J. HARRINGTON	DRAWN BY: L. BULLOCK
DESIGNED BY: L. BULLOCK	CHECKED BY: J. HARRINGTON
PLAN SHEET 56	SHEET 70 OF 96