


TEMPORARY 4 INCH WHITE LINE, PAINT
 SPECIAL PROVISION (DURABLE 4 INCH WHITE LINE, POLYUREA)(28 MILS)
 (ALL LINES WILL INCLUDE EDGE LINE BREAKS AND
 RADIUS FOR TOWN HIGHWAYS)
 FERRISBURGH:
 STA 291+00.00 - STA. 307+00.00 LT & RT

TEMPORARY 4 INCH YELLOW LINE, PAINT
 SPECIAL PROVISION (DURABLE 4 INCH YELLOW LINE, POLYUREA)(28 MILS)
 (ALL LINES WILL INCLUDE C/L BREAKS FOR
 TOWN HIGHWAYS) S=SOLID, D=DASHED
 FERRISBURGH:
 STA 291+00.00 - STA 298+32.00 LT C RT
 STA 291+00.00 - STA 298+32.00 D - S
 STA 298+32.00 - STA 307+00.00 S - S
 STA 299+85.12 DOUBLE SOLID RT, TH-15

TEMPORARY 24 INCH STOP BAR, PAINT
 SPECIAL PROVISION (DURABLE 24 INCH STOP BAR, POLYUREA)(28 MILS) OR
 DURABLE 24 INCH STOP BAR, THERMOPLASTIC
 FERRISBURGH:
 STA 299+85.12 RT, TH-15

MILLED RUMBLE STRIPS (CENTERLINE)
 FERRISBURGH:
 STA. 299+38.00 - STA. 299+65.00
 STA. 300+05.00 - STA. 303+29.44
 STA. 303+69.44 - STA. 305+71.00
 STA. 300+10.00 - STA. 303+30.00
 STA. 303+70.00 - STA. 306+50.00

TEMPORARY LETTER OR SYMBOL, PAINT
 SPECIAL PROVISION (DURABLE LETTER OR SYMBOL, POLYUREA)(28 MILS) OR
 DURABLE LETTER OR SYMBOL, THERMOPLASTIC
 FERRISBURGH:
 STA 299+85.12 RT, TH-15 "STOP" (4 EA)
 STA. 303+49.44 LT, TH-18 "STOP" (4 EA)

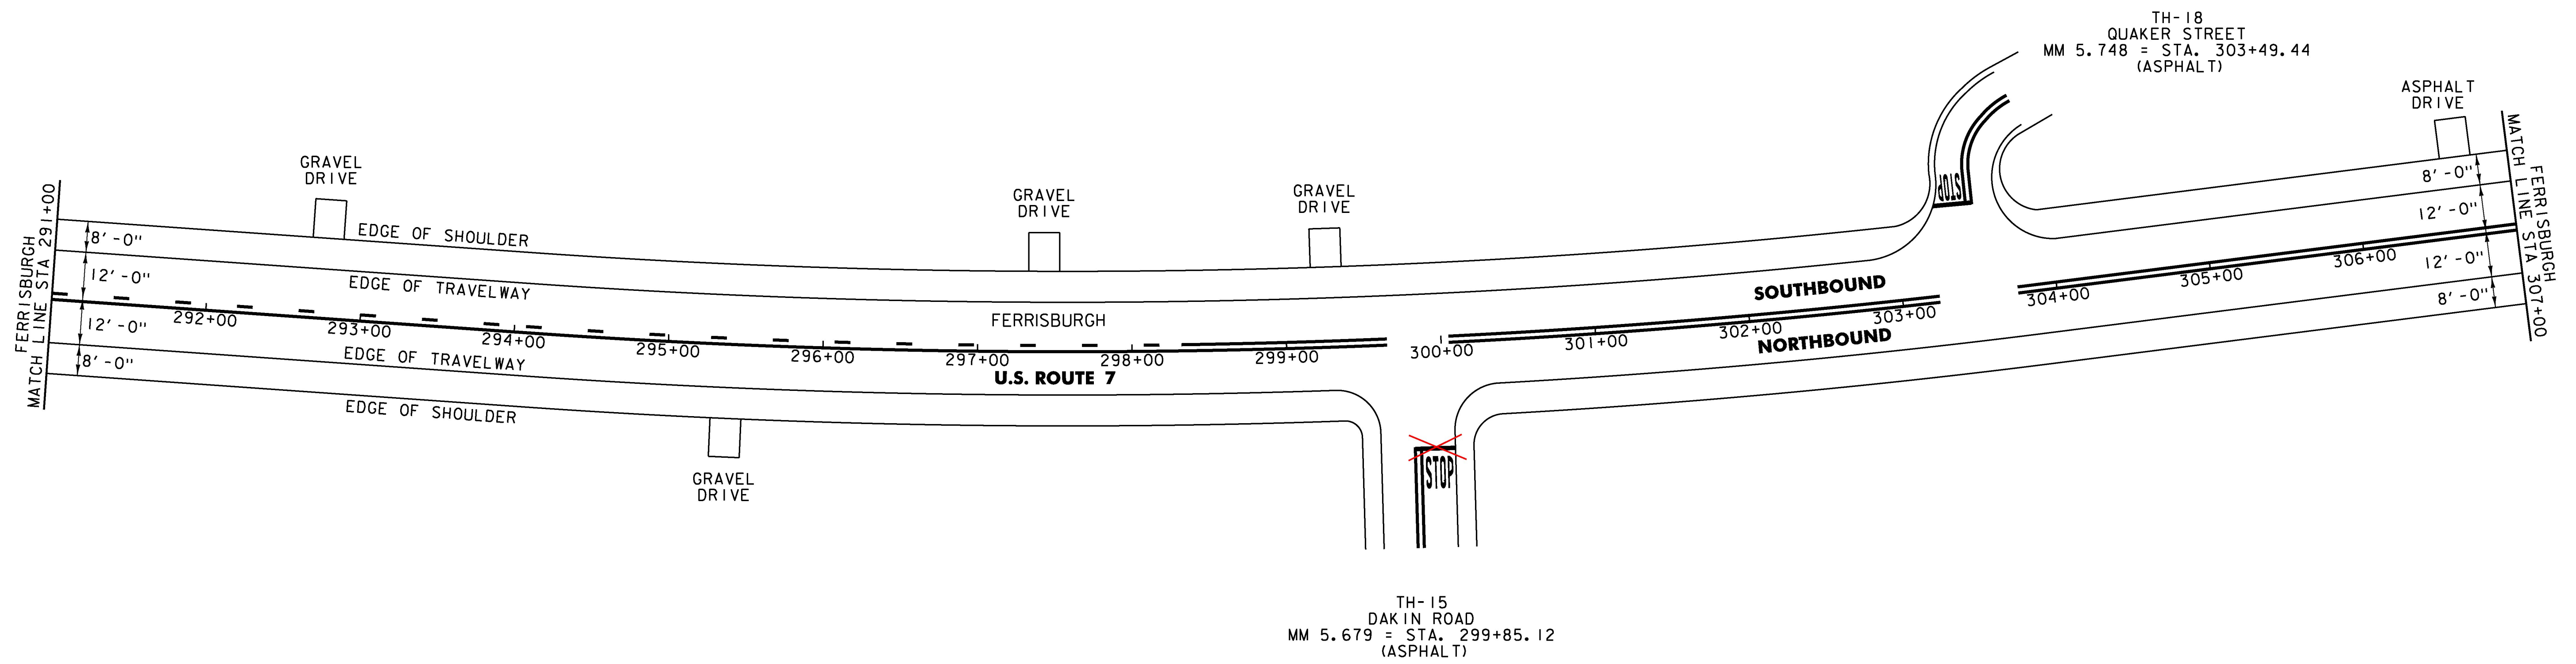

NOT TO SCALE

PROJECT NAME:	MIDDLEBURY-FERRISBURGH
PROJECT NUMBER:	NH SURF(55)
FILE NAME:	p15v015.dgn
PROJECT LEADER:	J. HARRINGTON
DESIGNED BY:	L. BULLOCK
PLAN SHEET 57	
PLOT DATE:	16-MAR-2016
DRAWN BY:	L. BULLOCK
CHECKED BY:	J. HARRINGTON
SHEET	71 OF 96