


TEMPORARY 4 INCH WHITE LINE, PAINT
 SPECIAL PROVISION (DURABLE 4 INCH WHITE LINE, POLYUREA)(28 MILS)
 (ALL LINES WILL INCLUDE EDGE LINE BREAKS AND
 RADIUS FOR TOWN HIGHWAYS)
 FERRISBURGH:
 STA 323+00.00 - STA. 339+00.00 LT & RT

TEMPORARY 4 INCH YELLOW LINE, PAINT
 SPECIAL PROVISION (DURABLE 4 INCH YELLOW LINE, POLYUREA)(28 MILS)
 (ALL LINES WILL INCLUDE C/L BREAKS FOR
 TOWN HIGHWAYS) S=SOLID, D=DASHED
 FERRISBURGH:
 STA 323+00.00 - STA 325+25.00 LT - D @ RT -
 STA 325+25.00 - STA 331+05.00 D - - S S
 STA 331+05.00 - STA 339+00.00 S - - S S

TEMPORARY 24 INCH STOP BAR, PAINT
~~SPECIAL PROVISION (DURABLE 24 INCH STOP BAR, POLYUREA)(28 MILS) OR~~
~~DURABLE 24 INCH STOP BAR, THERMOPLASTIC~~
 FERRISBURGH:
~~STA 332+69.28 LT, TH-18~~

MILLED RUMBLE STRIPS (CENTERLINE)
 FERRISBURGH:
~~STA. 323+00.00 - STA. 332+49.00~~
~~STA. 332+89.00 - STA. 339+00.00~~
 STA. 323+00.00 - STA. 326+98.00
 STA. 327+02.00 - STA. 329+98.00
 STA. 330+02.00 - STA. 332+47.00
 STA. 332+90.00 - STA. 339+00.00

TEMPORARY LETTER OR SYMBOL, PAINT
 SPECIAL PROVISION (DURABLE LETTER OR SYMBOL, POLYUREA)(28 MILS) OR
 DURABLE LETTER OR SYMBOL, THERMOPLASTIC
 FERRISBURGH:
 STA 332+69.28 LT, TH-18 "STOP" (4 EA)

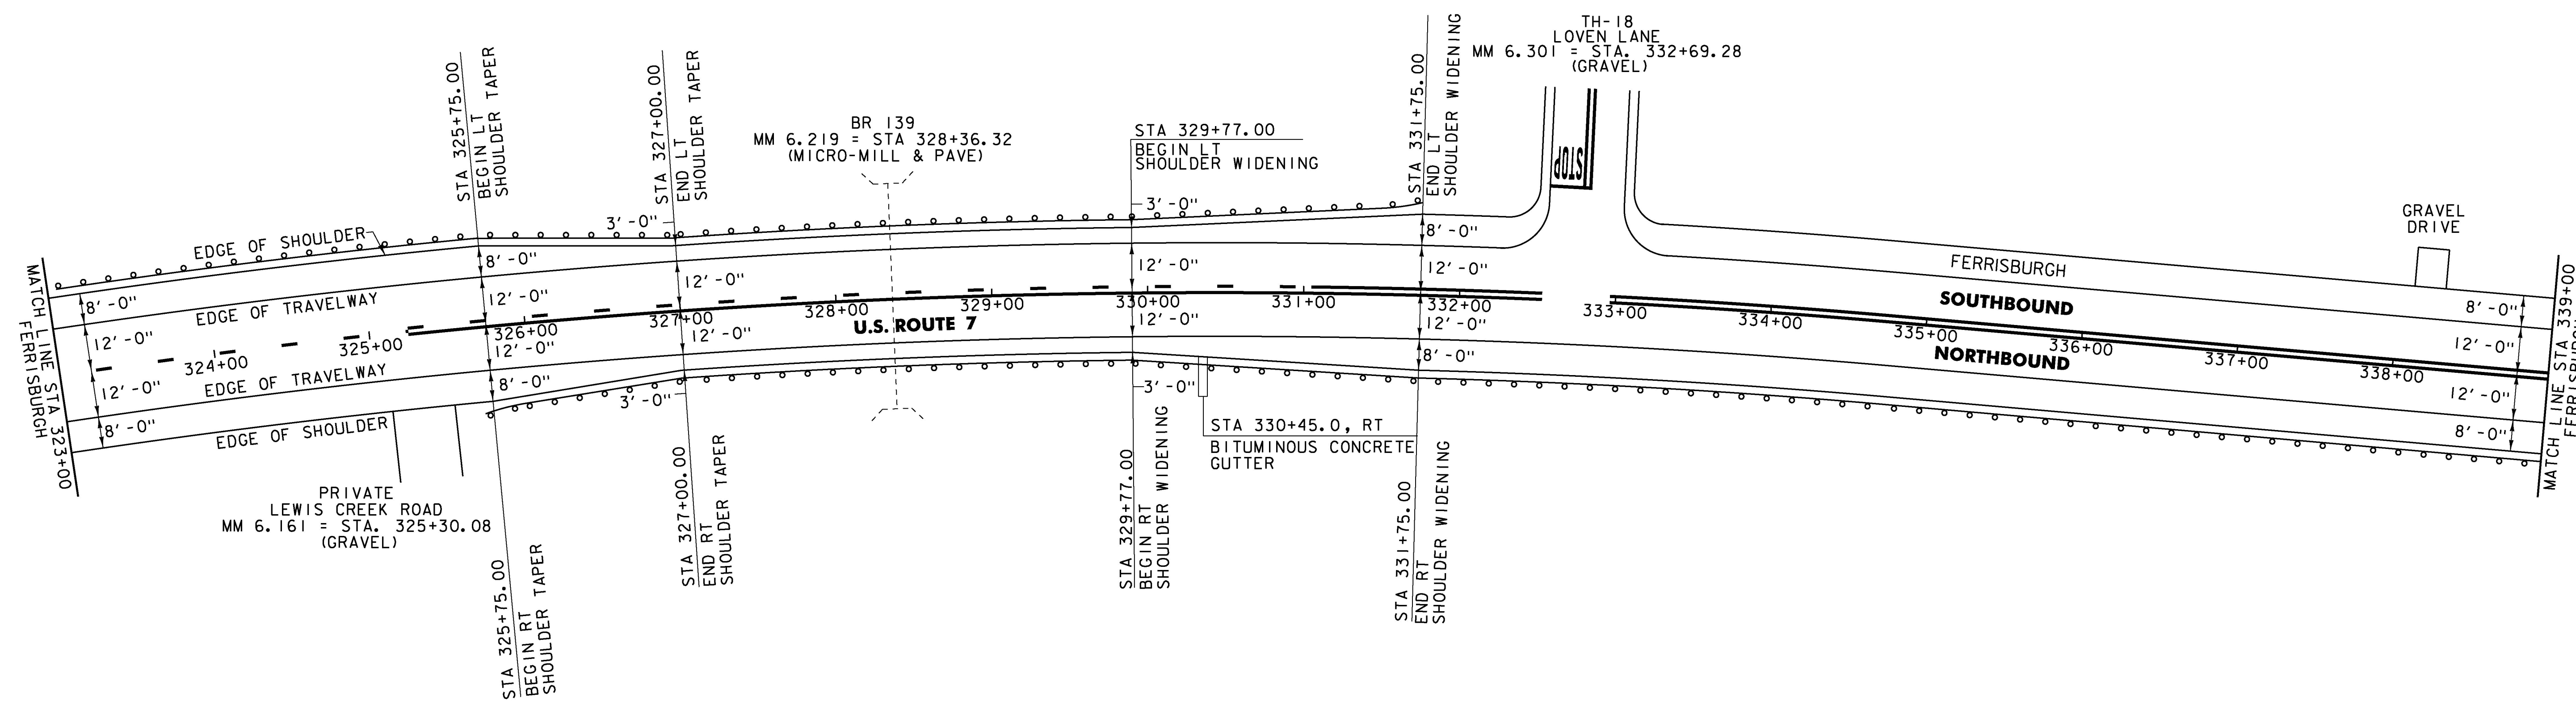

NOT TO SCALE

PROJECT NAME: MIDDLEBURY-FERRISBURGH	
PROJECT NUMBER: NH SURF(55)	
FILE NAME: p15v015.dgn	PLOT DATE: 16-MAR-2016
PROJECT LEADER: J. HARRINGTON	DRAWN BY: L. BULLOCK
DESIGNED BY: L. BULLOCK	CHECKED BY: J. HARRINGTON
PLAN SHEET 59	SHEET 73 OF 96