

TEMPORARY 4 INCH WHITE LINE, PAINT
 SPECIAL PROVISION (DURABLE 4 INCH WHITE LINE, POLYUREA)(28 MILS)
 (ALL LINES WILL INCLUDE EDGE LINE BREAKS AND RADIUS FOR TOWN HIGHWAYS)

FERRISBURGH:
 STA 355+00.00 - STA 371+00.00 LT & RT
 STA 364+85.00 - STA 366+65.00 DOTTED RT
 STA 366+65.00 - STA 367+40.00 SOLID LANE LINE RT
 STA 367+80.00 - STA 368+55.00 SOLID LANE LINE LT
 STA 368+55.00 - STA 370+35.00 DOTTED LT

TEMPORARY 4 INCH YELLOW LINE, PAINT
 SPECIAL PROVISION (DURABLE 4 INCH YELLOW LINE, POLYUREA)(28 MILS)
 (ALL LINES WILL INCLUDE C/L BREAKS FOR TOWN HIGHWAYS) S=SOLID, D=DASHED

FERRISBURGH:
 STA 355+00.00 - STA 362+85.00 LT @ RT S - S
 STA 362+85.00 - STA 366+65.00 DOUBLE SOLID MEDIAN LT & RT
 STA 366+65.00 - STA 368+55.00 DOUBLE SOLID CENTERLINE
 STA 368+55.00 - STA 371+00.00 DOUBLE SOLID MEDIAN LT & RT
 STA 367+59.36 DOUBLE SOLID LT, TH-1
 STA 367+59.36 DOUBLE SOLID RT, TH-1

TEMPORARY 8 INCH YELLOW LINE, PAINT
 SPECIAL PROVISION (DURABLE 8 INCH YELLOW LINE, POLYUREA)(28 MILS)


FERRISBURGH:
 STA 362+85.00 - STA 366+65.00 HATCHED MEDIAN LT & RT
 STA 368+55.00 - STA 371+00.00 HATCHED MEDIAN LT & RT

SPECIAL PROVISION (DURABLE 24 INCH STOP BAR, POLYUREA)(28 MILS)

Ferrisburgh STA 367+59 LT = Stage Road
 Ferrisburgh STA 367+59 RT = Old Hollow Road

SPECIAL PROVISION (DURABLE LETTER OR SYMBOL, POLYUREA)(28 MILS) OR DURABLE LETTER OR SYMBOL, THERMOPLASTIC

FERRISBURGH:
 STA 366+75.3 LT/RT ARROW (IEA)
 STA 367+32 LT/RT ARROW (IEA)
 STA 367+87 LT/RT ARROW (IEA)
 STA 367+59.36 RT "STOP" (4 EA)
 STA 367+59.36 LT "STOP" (4 EA)
 STA 368+47 LT/RT ARROW (IEA)

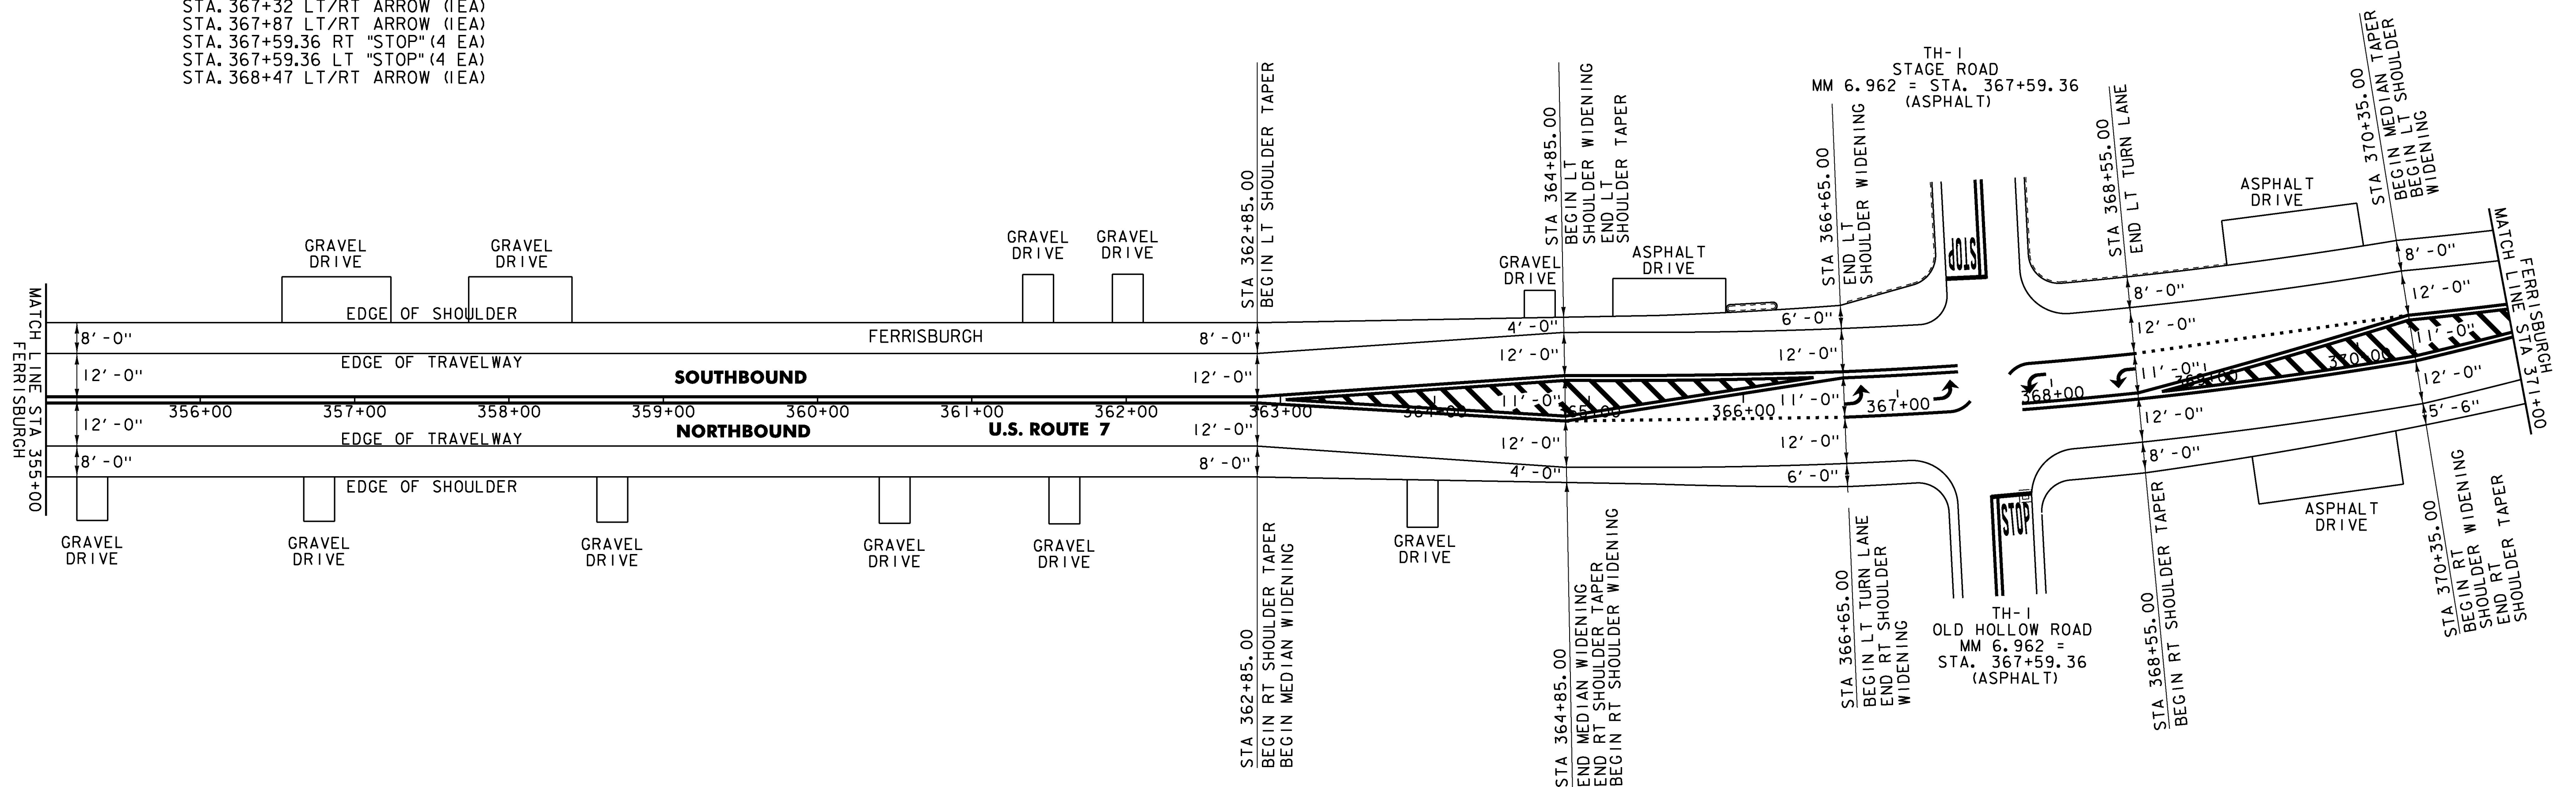

TEMPORARY LETTER OR SYMBOL, PAINT

FERRISBURGH:
 STA 366+75.3 LT/RT ARROW (IEA)
 STA 367+32 LT/RT ARROW (IEA)
 STA 367+87 LT/RT ARROW (IEA)
 STA 367+59.36 RT "STOP" (4 EA)
 STA 367+59.36 LT "STOP" (4 EA)
 STA 368+47 LT/RT ARROW (IEA)

CHANGING ELEV. OF DROP INLETS, CATCH BASINS, OR MANHOLES

FERRISBURGH:
 STA 367+65 RT (DID NOT ADJUST)

NOT TO SCALE

| | |
|-----------------|---------------------------|
| PROJECT NAME: | MIDDLEBURY-FERRISBURGH |
| PROJECT NUMBER: | NH SURF(55) |
| FILE NAME: | pl5v015.dgn |
| PROJECT LEADER: | J. HARRINGTON |
| DESIGNED BY: | L. BULLOCK |
| PLAN SHEET 61 | CHECKED BY: J. HARRINGTON |
| | PLOT DATE: 16-MAR-2016 |
| | DRAWN BY: L. BULLOCK |
| | SHEET 75 OF 96 |