
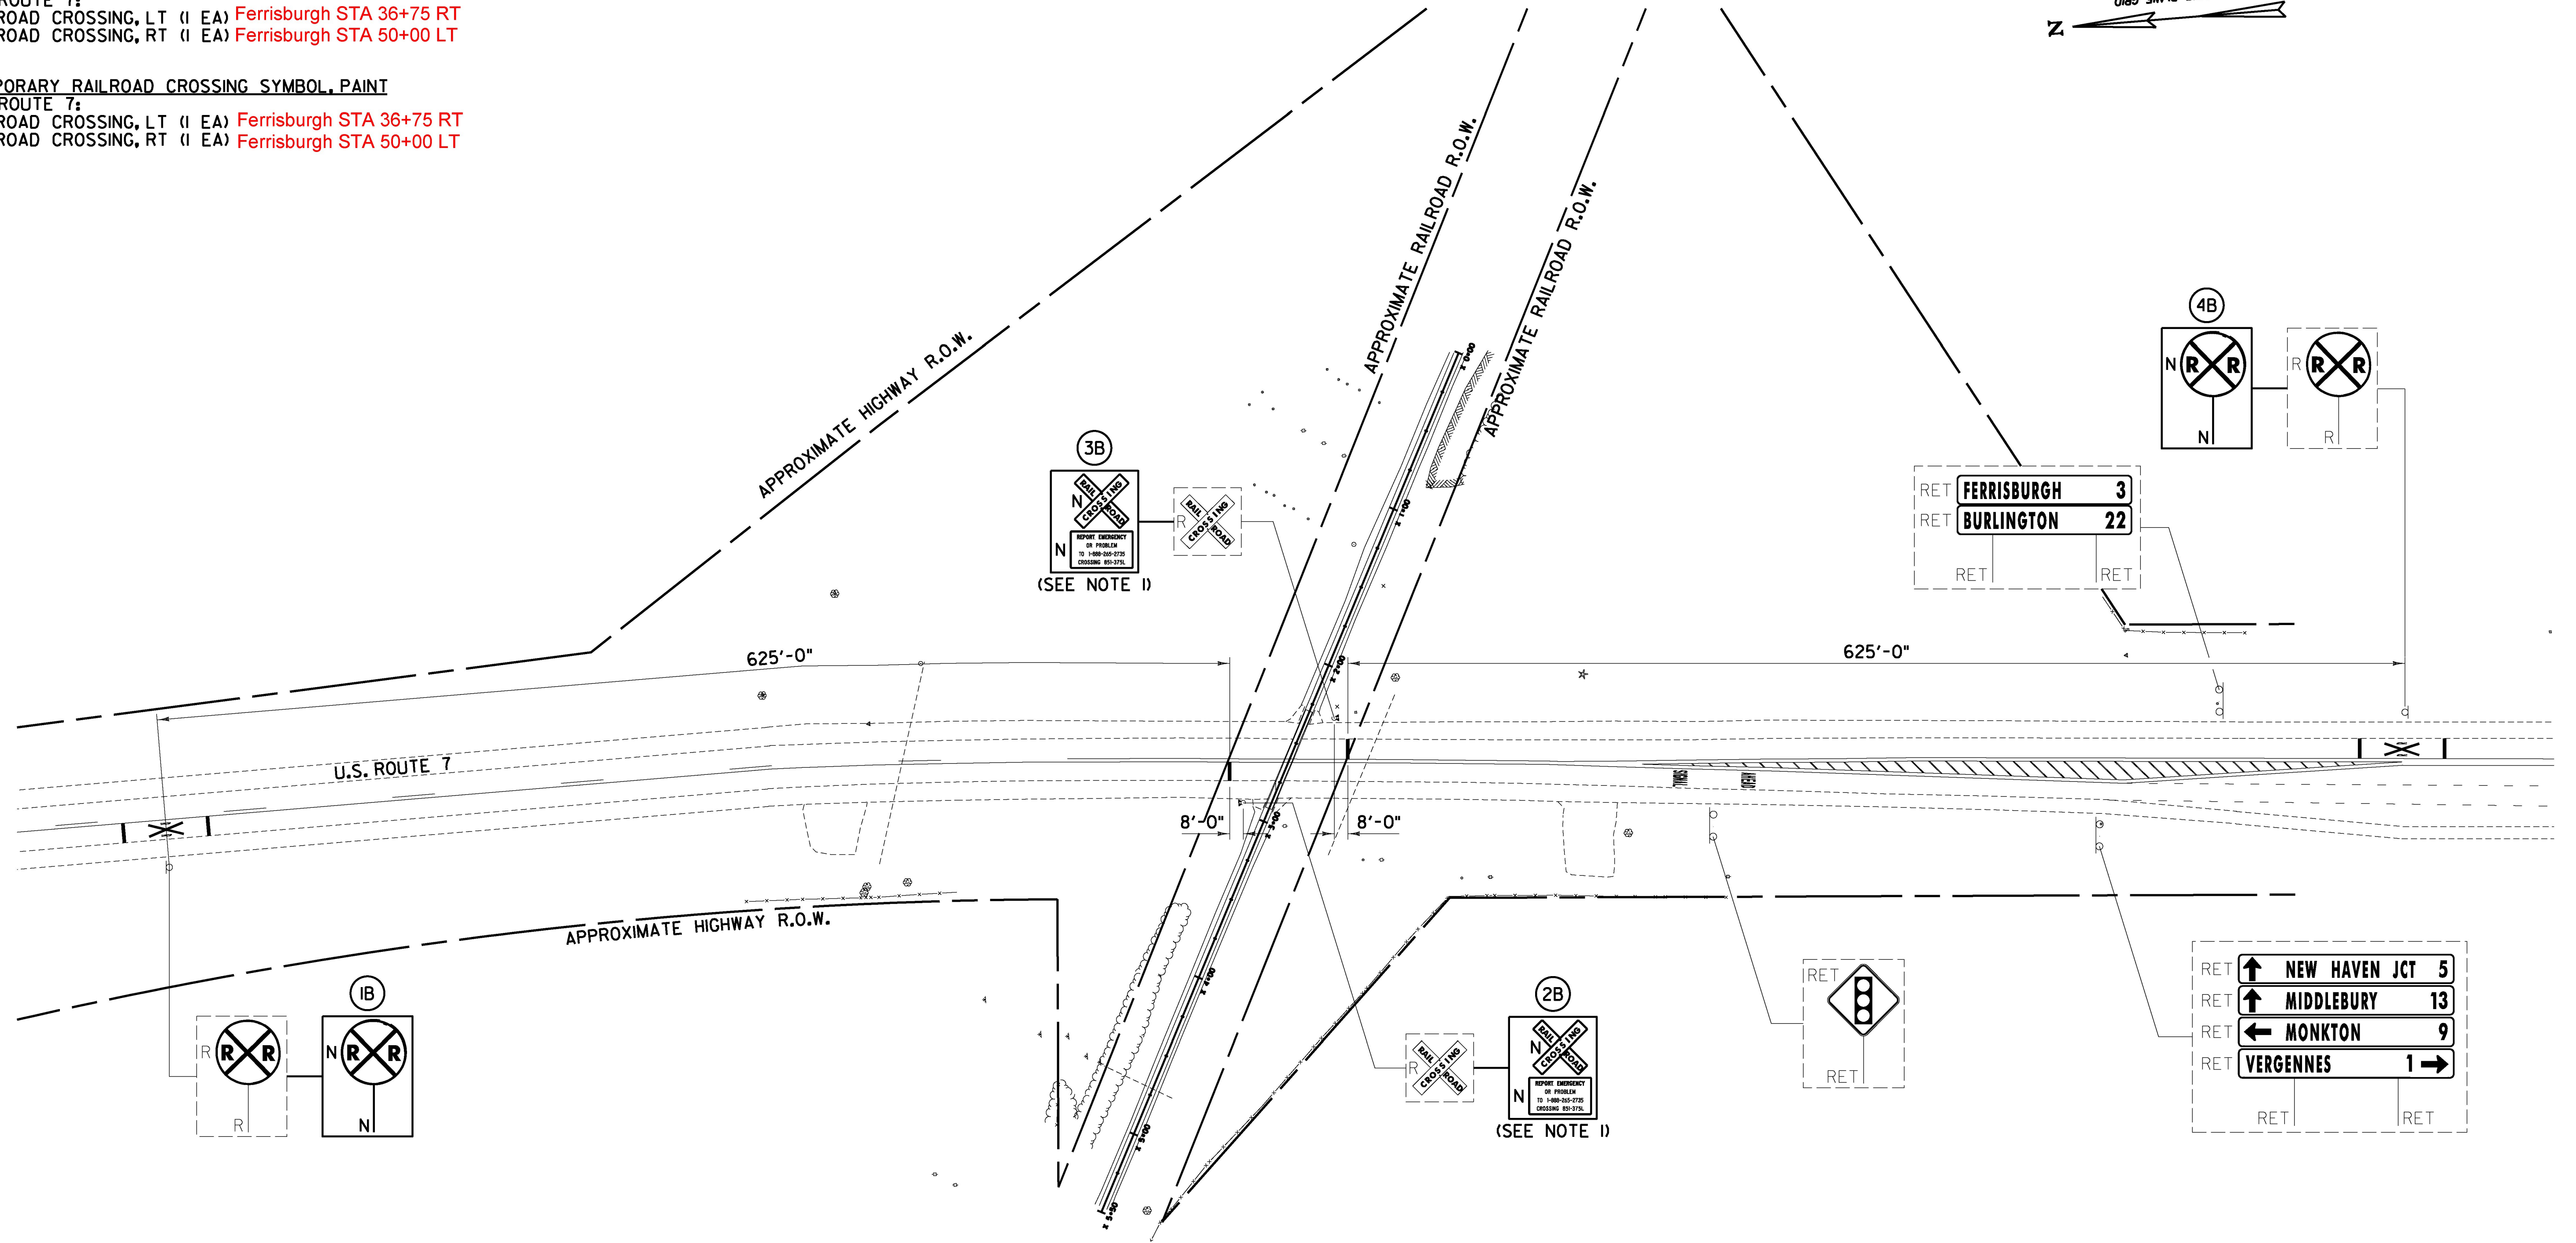


DURABLE RAILROAD CROSSING SYMBOL, THERMOPLASTIC
 OR SPECIAL PROVISION (DURABLE RAILROAD CROSSING SYMBOL, POLYUREA) (28 MIL.S)
 U.S. ROUTE 7:
 RAILROAD CROSSING, LT (I EA) Ferrisburgh STA 36+75 RT
 RAILROAD CROSSING, RT (I EA) Ferrisburgh STA 50+00 LT

TEMPORARY RAILROAD CROSSING SYMBOL, PAINT
 U.S. ROUTE 7:
 RAILROAD CROSSING, LT (I EA) Ferrisburgh STA 36+75 RT
 RAILROAD CROSSING, RT (I EA) Ferrisburgh STA 50+00 LT

REMOVING SIGNS
 AS SHOWN - 4

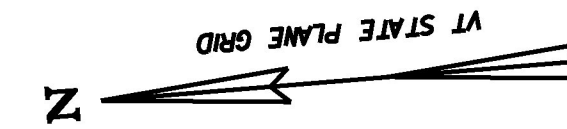

**SIGNING & STRIPING PLAN
 TOWN OF FERRISBURGH
 U.S. ROUTE 7
 MM 0.81
 AARDOT 851-375L
 VERMONT RAILWAY
 NORTHERN SUBDIVISION
 MP 100.04
 HIGHWAY CROSSING**

NOTE:

I. PROPOSED SIGN ASSEMBLY TO BE MOUNTED
 ON PROPOSED SIGNAL MAST/CANTILEVER.

NOT TO SCALE

PROJECT NAME: MIDDLEBURY - FERRISBURGH
 PROJECT NUMBER: NH SURF (55)

FILE NAME: z15v015rrssp.dgn
 PROJECT LEADER: D.E.G.
 DESIGNED BY: M.J.M.
 SIGNING & STRIPING PLAN B

PLOT DATE: 3/29/2016
 DRAWN BY: C.A.K.
 CHECKED BY: D.W.E.
 SHEET 88 OF 96



FILE NAME = W:\Projects\2016\NH\15\015\Consult\plans\Rail\15v015rrssp.dgn
 DATE/TIME = 3/29/2016 1:45:59
 USER =