

**INDEX OF SHEETS**

- 1 TITLE SHEET
- 2 CRACK SEALING TYPICAL
- 3 QUANTITY SHEET
- 4 LOCATION LAYOUT
- 5-6 CRACK SEALING LOCATION DETAIL SHEETS
- 7-19 INTERCHANGE DETAIL SHEETS
- 20 TRAFFIC CONTROL NOTES

**VAOT STANDARDS**


- T-1 04/25/16
- T-10 08/06/12
- T-11 08/06/12
- T-12 08/06/12
- T-16 08/06/12
- T-17 08/06/12
- T-20 08/06/12
- T-28 08/06/12
- T-29 08/06/12
- T-30 08/06/12
- T-31 08/06/12

# STATE OF VERMONT AGENCY OF TRANSPORTATION




## PROPOSED IMPROVEMENT STATEWIDE CRACK SEALING

WORK TO BE PERFORMED UNDER THIS PROJECT INCLUDES THE ROUTING AND SEALING OF CRACKS IN BITUMINOUS CONCRETE PAVEMENT ON EXISTING STATE, U.S., AND INTERSTATE HIGHWAYS AND THE APPROPRIATE TRAFFIC CONTROL.

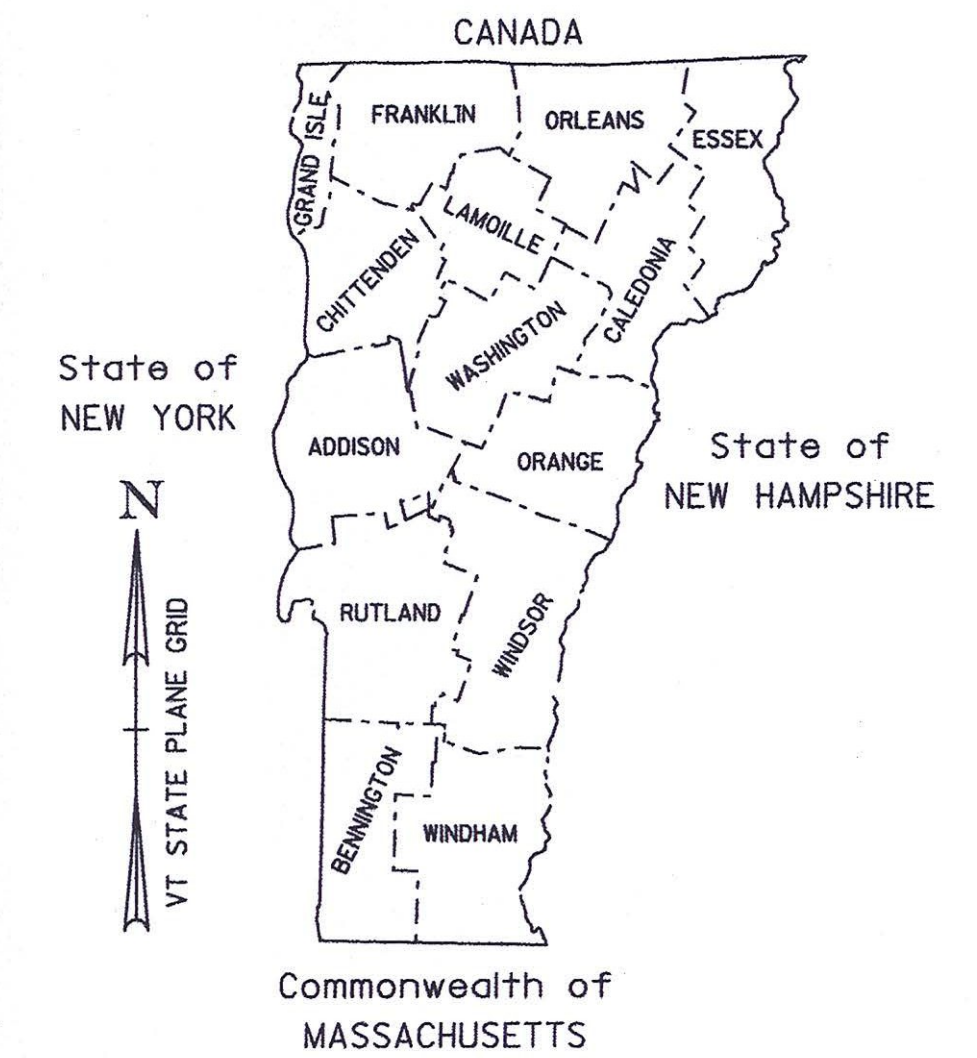

RECORD PLANS	
CONTRACTOR:	NICOM COATINGS CORP- BERLIN, VT
RESIDENT ENGINEER:	JOHN SLADYK
CONSTRUCTION BEGAN:	AUGUST 7, 2016
CONSTRUCTION COMPLETE:	OCTOBER 8, 2016
RECORD PLANS BY:	JOHN SLADYK & JESSE IVES
I HEREBY CERTIFY THAT ALL THE CONSTRUCTION REQUIRED BY THIS SET OF DRAWINGS HAS BEEN ACCOMPLISHED AS INDICATED HEREIN.	
BY _____	RESIDENT ENGINEER
DATE <u>12-11-17</u>	
NOTE: Any further information concerning final quantities, amounts or other details relative to this project may be found at Central Files in the electronic archives.	

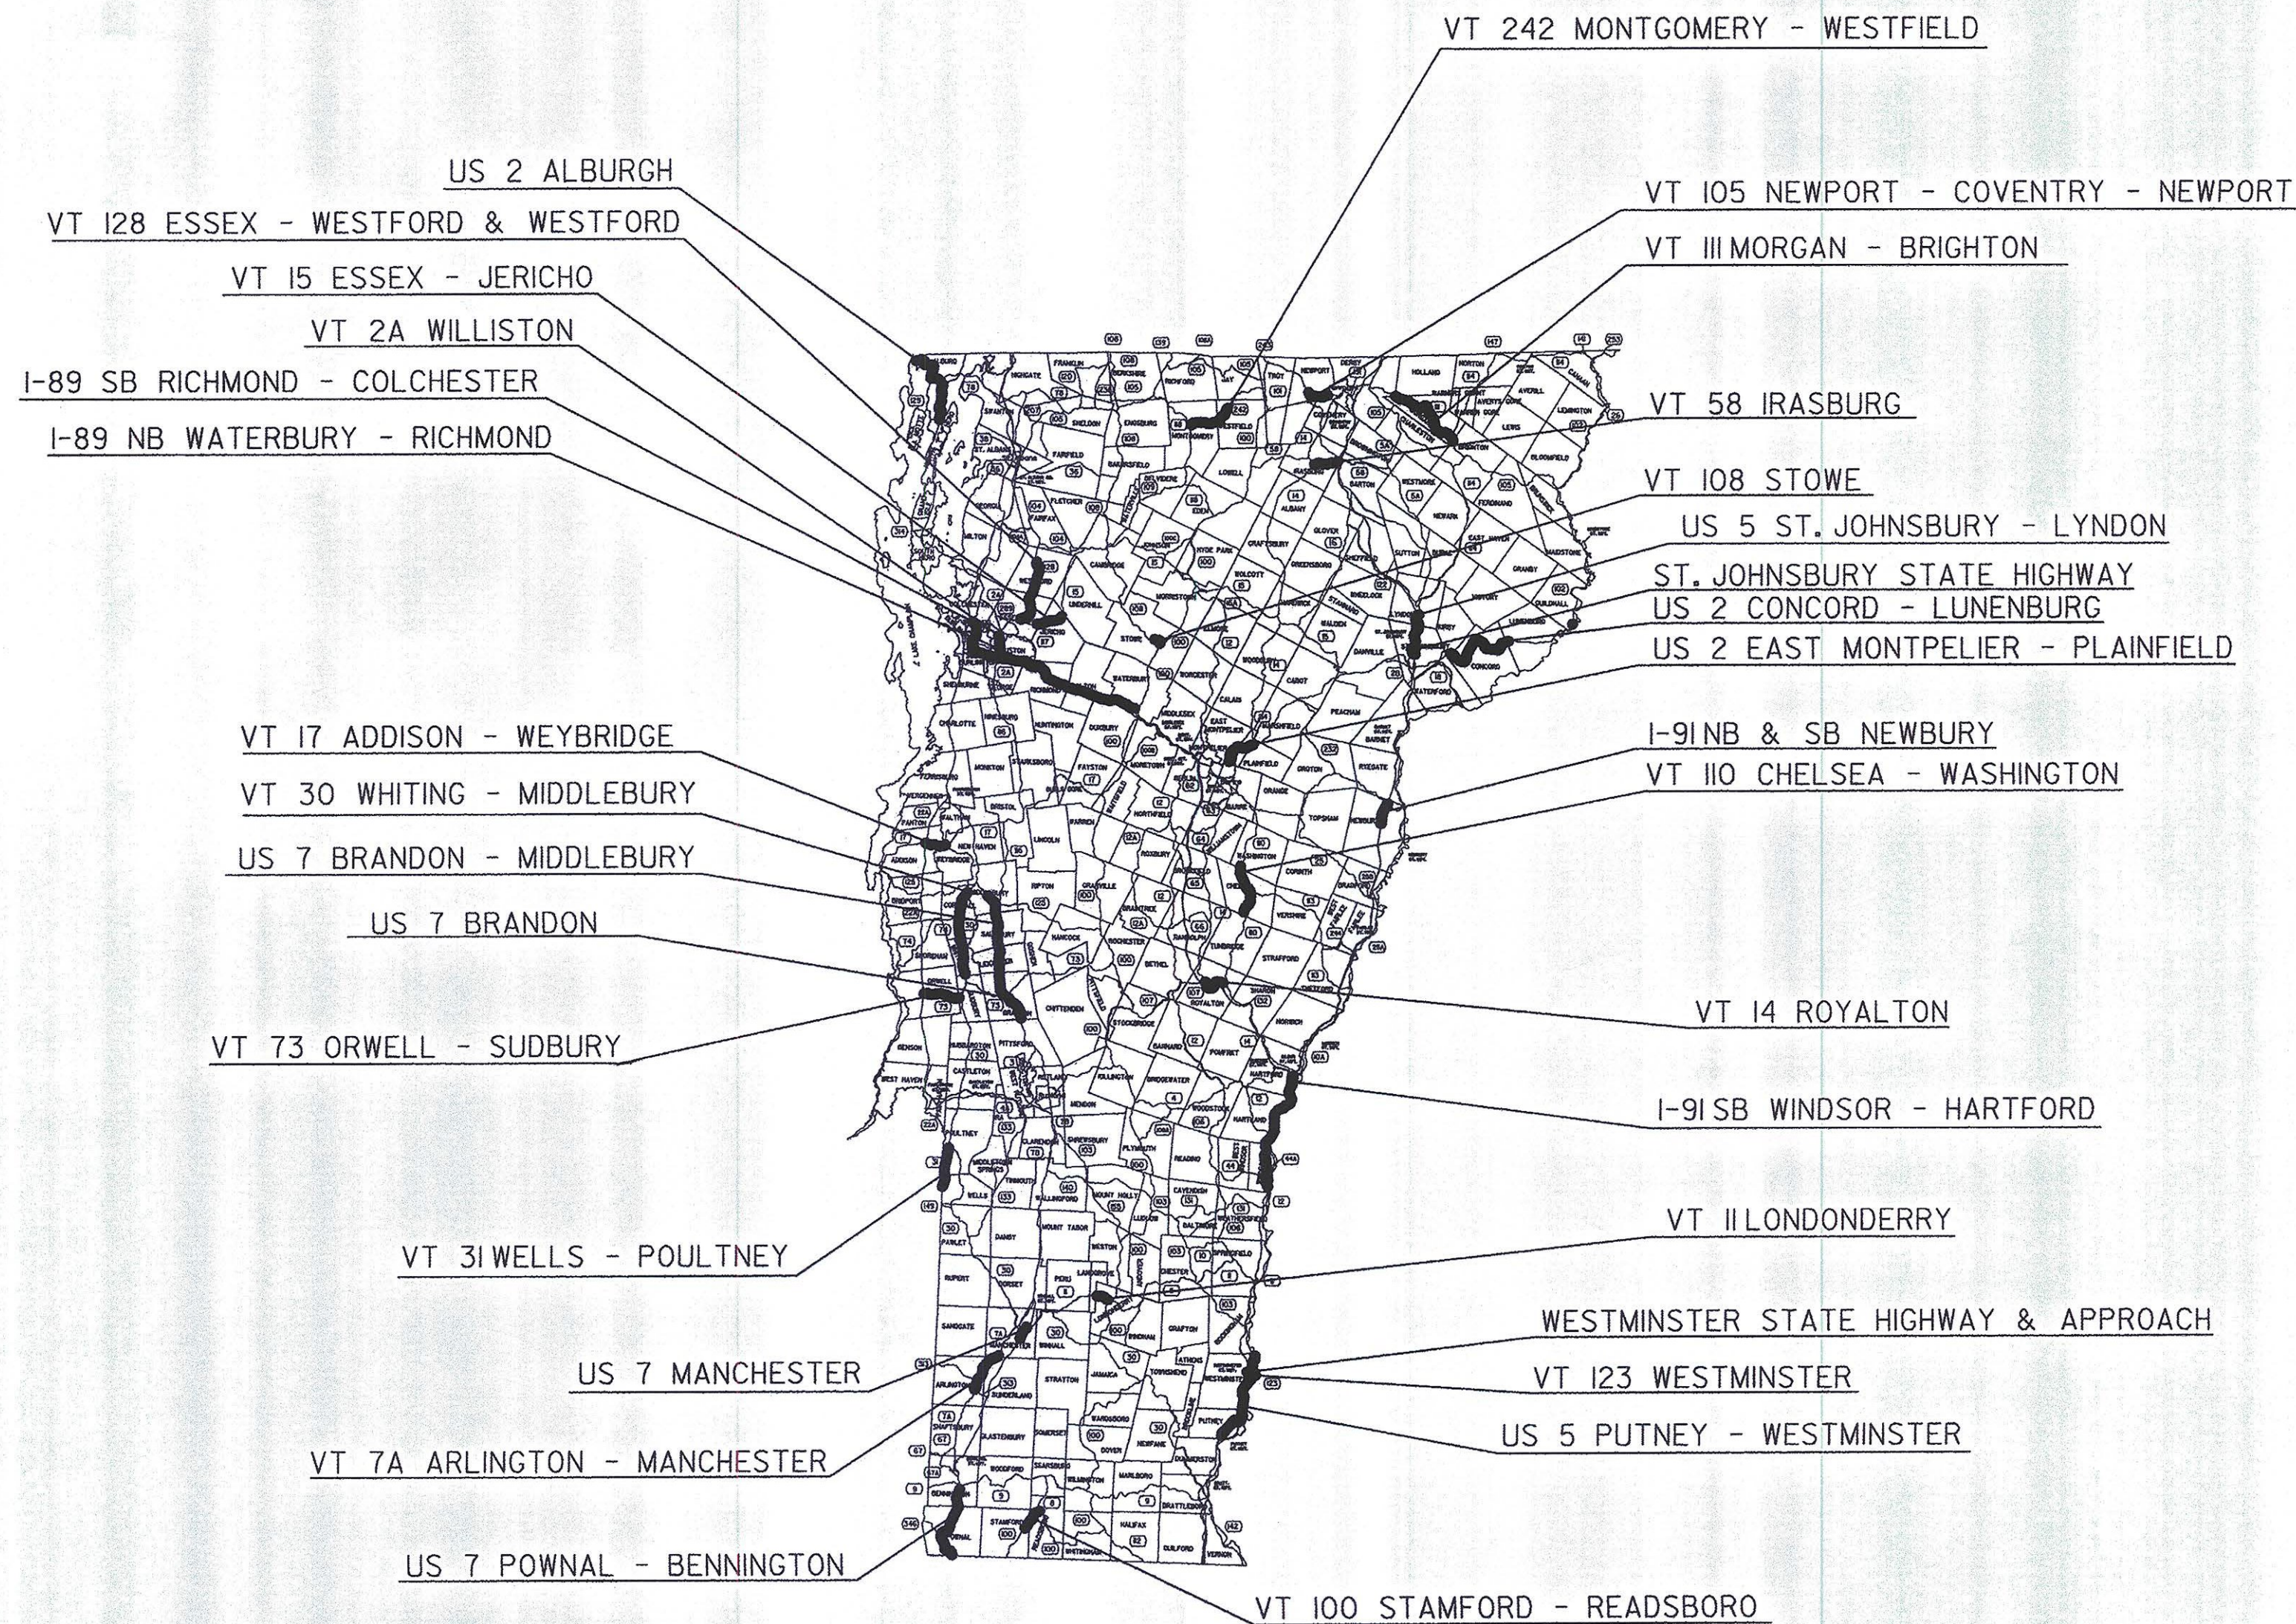

CONSTRUCTION IS TO BE CARRIED ON IN ACCORDANCE WITH THESE PLANS AND THE STANDARD SPECIFICATIONS FOR CONSTRUCTION DATED 2014, AS APPROVED BY THE FEDERAL HIGHWAY ADMINISTRATION ON JULY 20, 2011 FOR USE ON THIS PROJECT, INCLUDING ALL SUBSEQUENT REVISIONS AND SUCH REVISED SPECIFICATIONS AND SPECIAL PROVISIONS AS ARE INCORPORATED IN THESE PLANS.



QUALITY ASSURANCE PROGRAM : LEVEL I
SURVEYED BY : N/A
SURVEYED DATE : N/A
DATUM
VERTICAL : N/A
HORIZONTAL : N/A

BUILT AS DESIGNED

DIRECTOR OF PROJECT DELIVERY
APPROVED <u>[Signature]</u> DATE <u>5/23/2016</u>
PROJECT MANAGER : MICHAEL J. FOWLER, P.E.
PROJECT NAME : STATEWIDE
PROJECT NUMBER : STP CRAK (34)
SHEET 1 OF 20 SHEETS

NOT TO SCALE