


SHELBURNE INTERCHANGE # 13
I-89

RAMPS REQUIRING CRACK SEALING

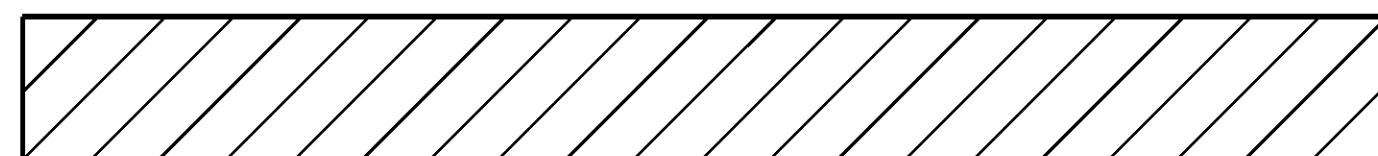

NOT TO SCALE

INTERCHANGE DETAIL SHEET # 3	PROJECT NAME: STATEWIDE	PLOT DATE: 19-MAY-2016
	PROJECT NUMBER: STP CRAK(34)	DRAWN BY: LOCKE
	FILE NAME: p15v188.dgn	CHECKED BY: FOWLER
	DESIGNED BY: LOCKE	SHEET 9 OF 20