


**WINOOSKI NORTH INTERCHANGE # 16**  
**I-89**

NOT TO SCALE

RAMPS REQUIRING CRACK SEALING

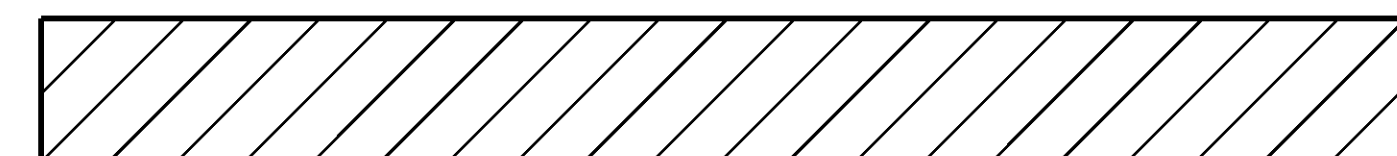

<b>INTERCHANGE DETAIL SHEET # 7</b>	PROJECT NAME: STATEWIDE	PLOT DATE: 19-MAY-2016
	PROJECT NUMBER: STP CRAK(34)	DRAWN BY: LOCKE
	FILE NAME: p15v188.dgn	CHECKED BY: FOWLER
	DESIGNED BY: LOCKE	SHEET 13 OF 20