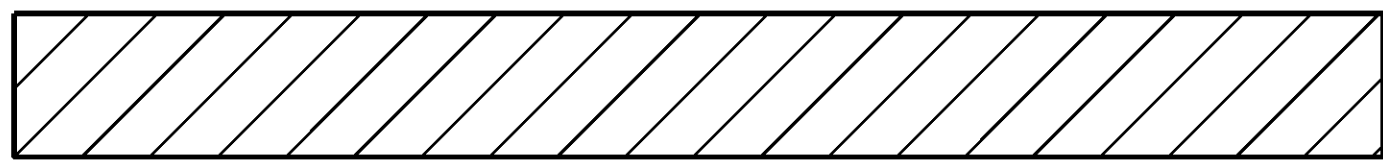


WELLS RIVER INTERCHANGE # 17
I-91

NOT TO SCALE

RAMPS REQUIRING CRACK SEALING


INTERCHANGE DETAIL SHEET # 8	PROJECT NAME: STATEWIDE	PLOT DATE: 19-MAY-2016
	PROJECT NUMBER: STP CRAK(34)	DRAWN BY: LOCKE
	FILE NAME: p15v188.dgn	CHECKED BY: FOWLER
	DESIGNED BY: LOCKE	SHEET 14 OF 20