


HARTLAND INTERCHANGE # 9
I-91

RAMPS REQUIRING CRACK SEALING

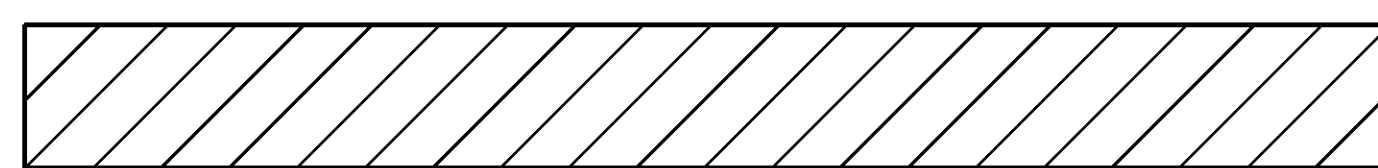

NOT TO SCALE

INTERCHANGE
DETAIL
SHEET # 9

PROJECT NAME: STATEWIDE	PLOT DATE: 19-MAY-2016
PROJECT NUMBER: STP CRAK(34)	DRAWN BY: LOCKE
FILE NAME: p15v188.dgn	CHECKED BY: FOWLER
PROJECT LEADER: FOWLER	SHEET 15 OF 20
DESIGNED BY: LOCKE	
p15v188_15.1	