


LIST OF SHEETS

SHEET NO.	TITLE
1 OF 4	TITLE SHEET
2 OF 4	PAY ITEMS AND QUANTITIES
3 OF 4	WORK PACKAGE 1--MECHANICAL
4 OF 4	WORK PACKAGE 1--ELECTRICAL

STATE OF VERMONT AGENCY OF TRANSPORTATION

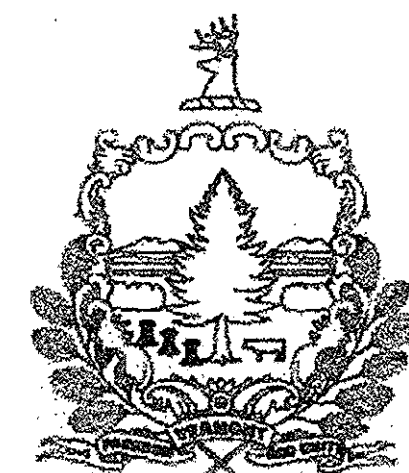

PROPOSED IMPROVEMENT BRIDGE PROJECT



TOWN OF NORTH HERO – GRAND ISLE
COUNTY OF GRAND ISLE

ROUTE NO : US ROUTE 2 BRIDGE NO : 8


PROJECT LOCATION : LOCATED ON US ROUTE 2, APPROXIMATELY 2,000 FEET NORTH OF THE
INTERSECTION OF US ROUTE 2 AND EAST SHORE NORTH OVER LAKE CHAMPLAIN.

PROJECT DESCRIPTION : INTERIM DRAWBRIDGE REPAIRS – WORK PACKAGE 1

LENGTH OF STRUCTURE : 258.80 FEET.

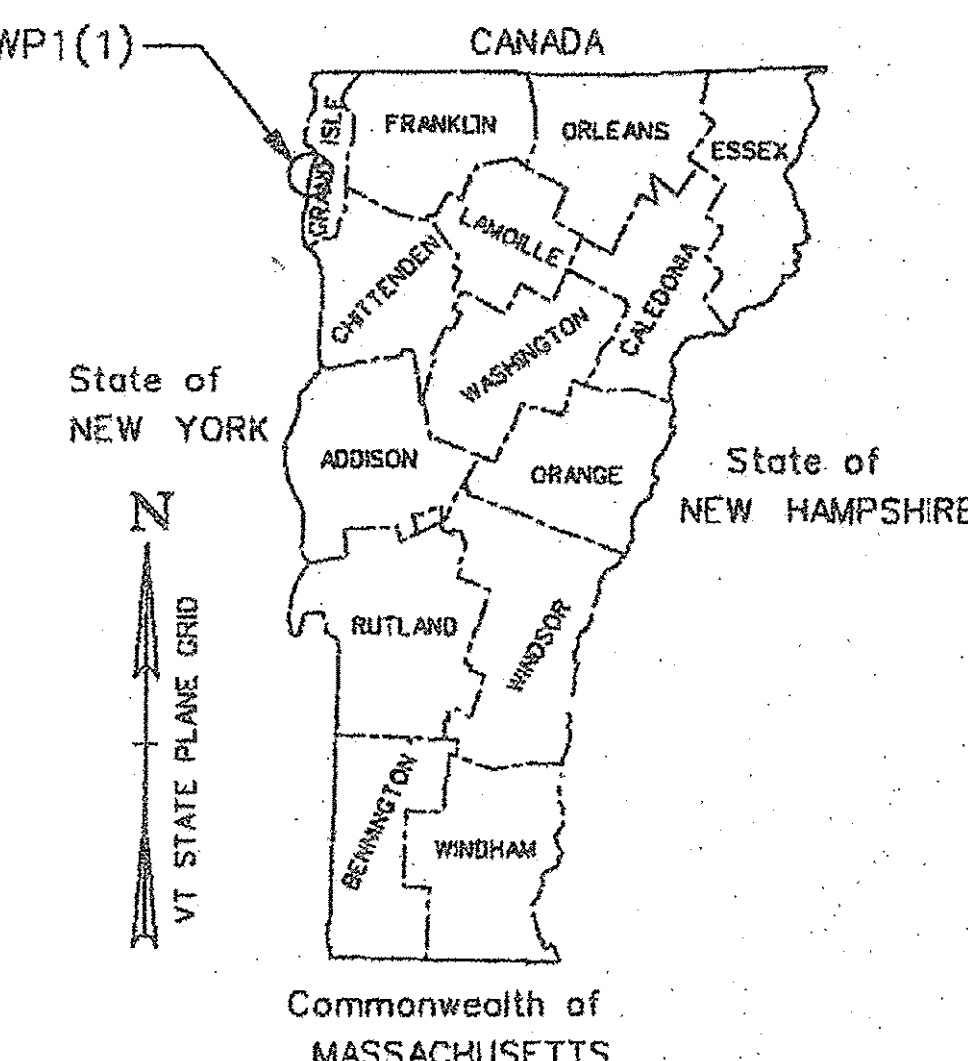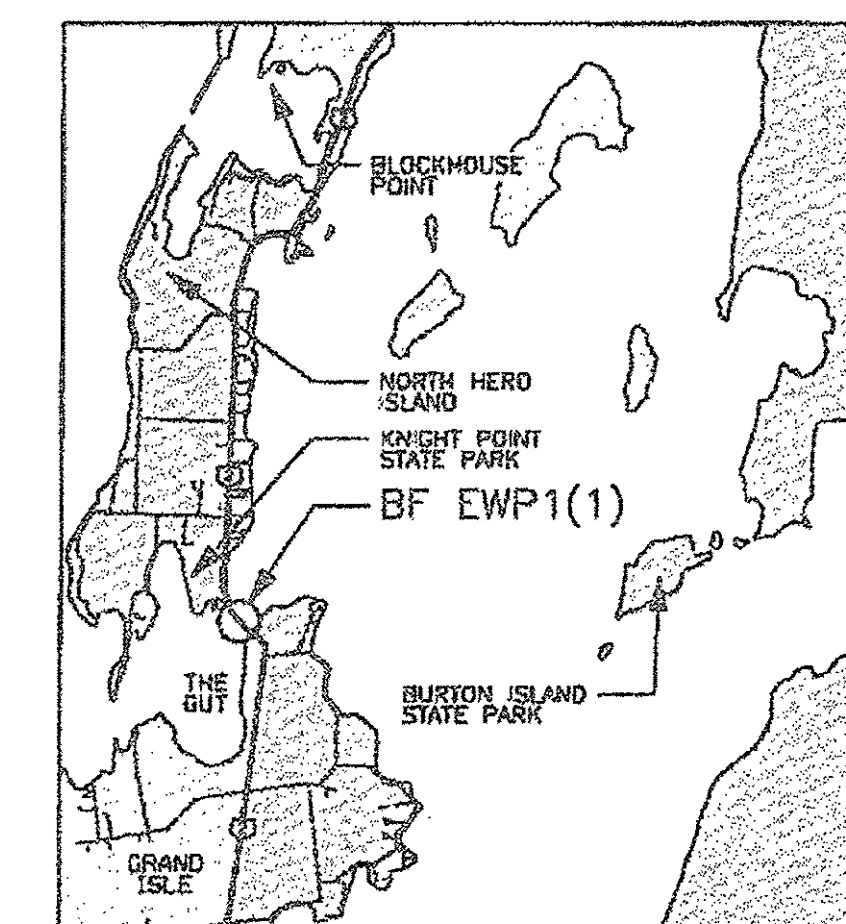


RECORD PLANS	
CONTRACTOR:	CIANBRO CORP. – PITTSFIELD, ME
RESIDENT ENGINEER:	GREG WILCOX
CONSTRUCTION BEGAN:	FEBRUARY 8, 2016
CONSTRUCTION COMPLETE:	MARCH 21, 2016
RECORD PLANS BY:	GREG WILCOX & AARON JAMES
I HEREBY CERTIFY THAT ALL THE CONSTRUCTION REQUIRED BY THIS SET OF DRAWINGS HAS BEEN ACCOMPLISHED AS INDICATED HEREIN.	
BY	RESIDENT ENGINEER
DATE	2/17/16
NOTE: Any further information concerning final quantities, amounts or other details relative to this project may be found at Central Files in the electronic archives.	

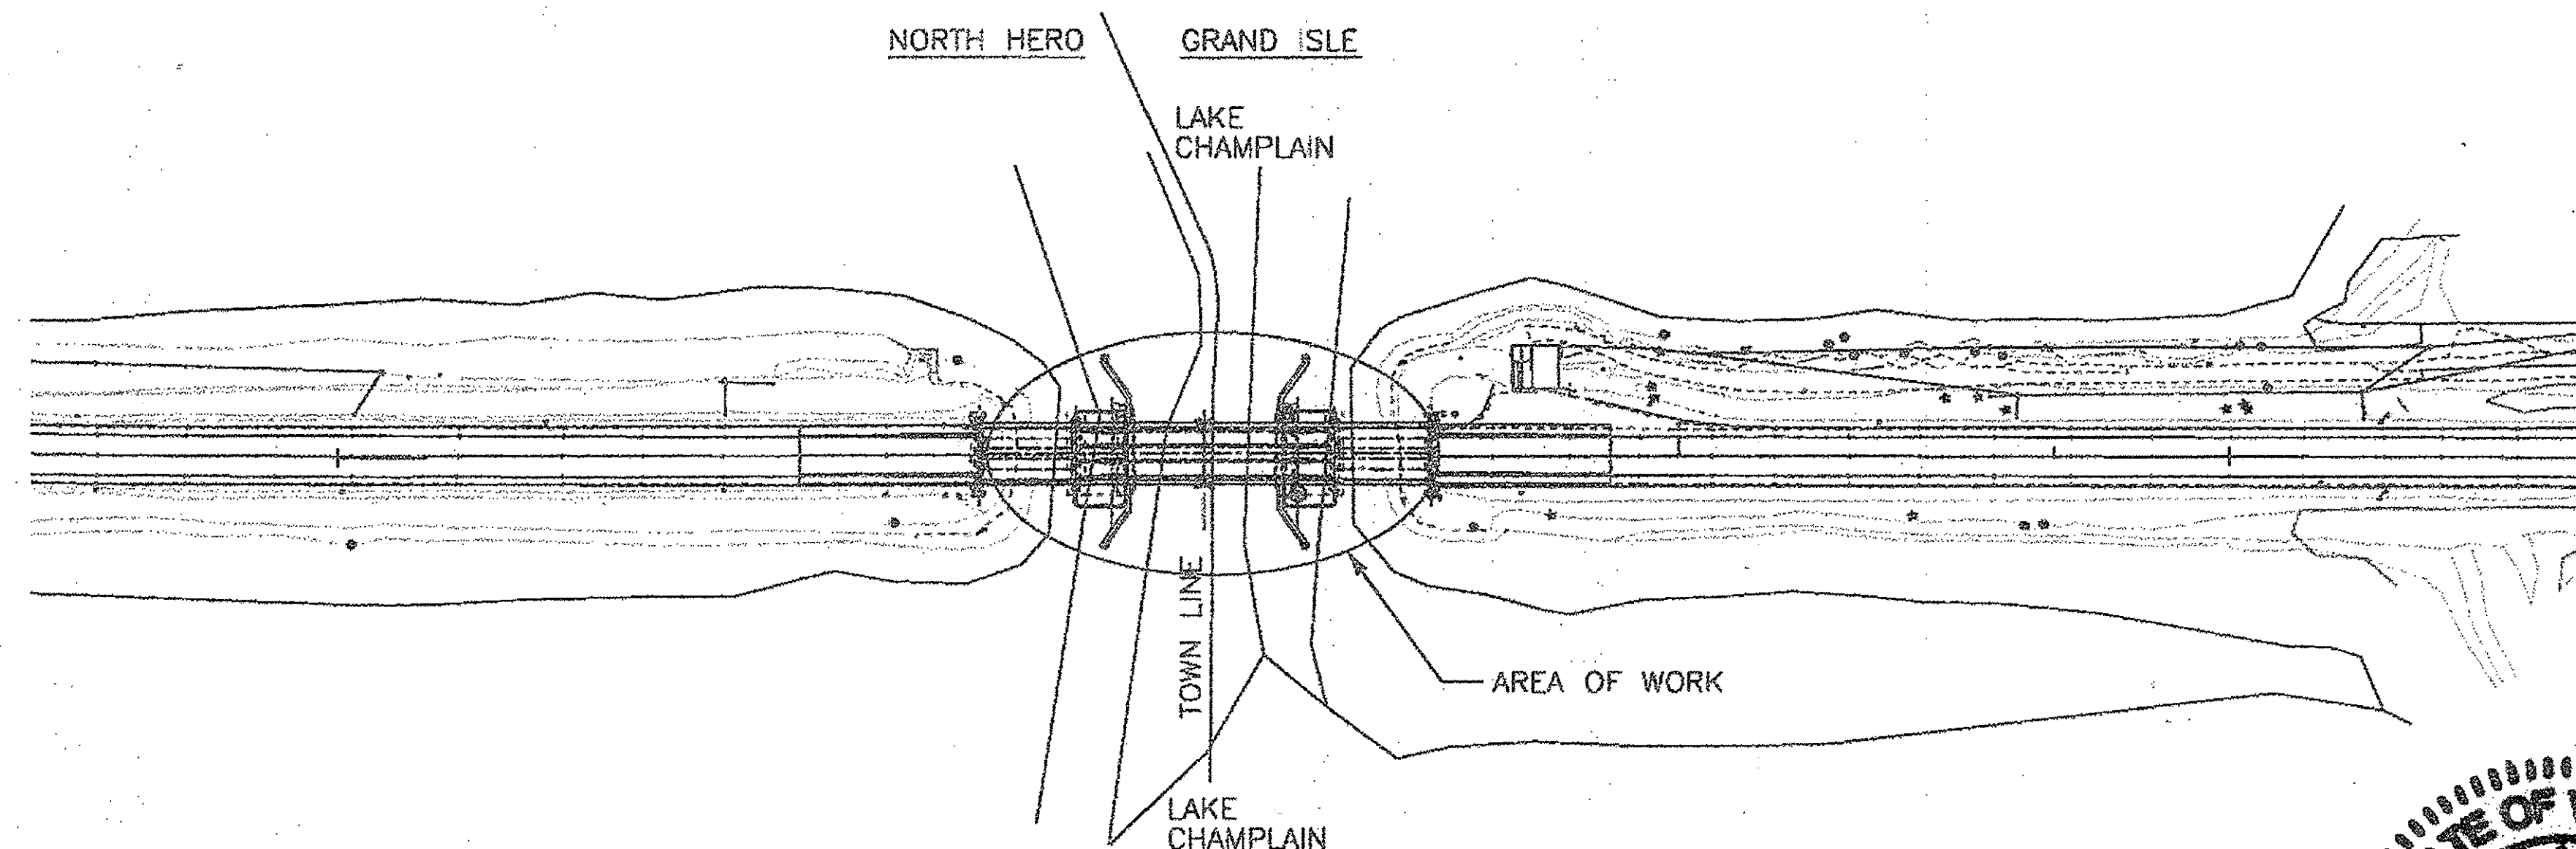

THESE PLANS ARE SUBJECT TO SUCH ENGINEERING CHANGES AS MAY BE REQUIRED BY THE FEDERAL HIGHWAY ADMINISTRATION OR THE DIRECTOR OF PROGRAM DEVELOPMENT. CONSTRUCTION IS TO BE CARRIED ON IN ACCORDANCE WITH THESE PLANS AND THE STANDARD SPECIFICATIONS FOR CONSTRUCTION DATED 2011, AS APPROVED BY THE FEDERAL HIGHWAY ADMINISTRATION ON JULY 20, 2011 FOR USE ON THIS PROJECT, INCLUDING ALL SUBSEQUENT REVISIONS AND SUCH REVISED SPECIFICATIONS AND SPECIAL PROVISIONS AS ARE INCORPORATED IN THESE PLANS.

QUALITY ASSURANCE PROGRAM : LEVEL
SURVEYED BY :
SURVEYED DATE :
DATUM
VERTICAL: N/A
HORIZONTAL: N/A

SCALE 1" = 80'-0"
80 0 80

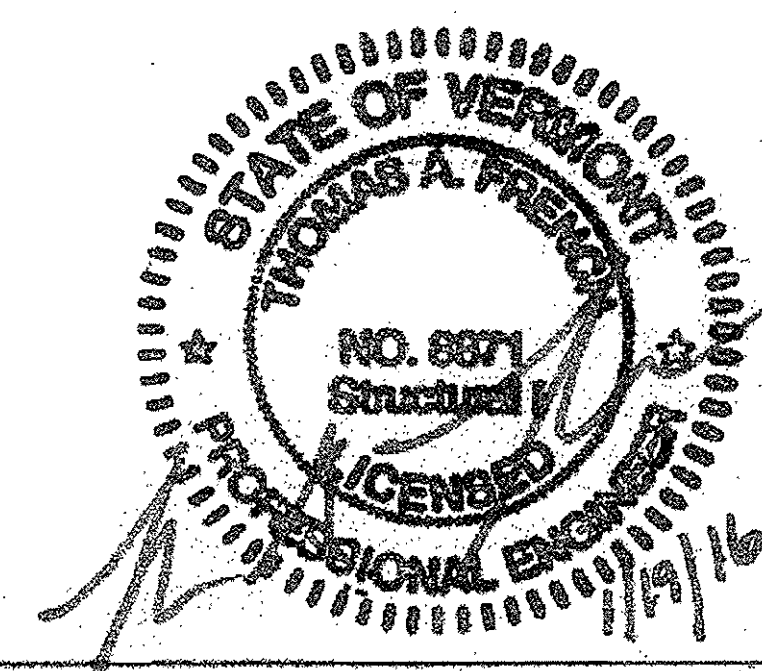

DEPARTMENT OF TRANSPORTATION FEDERAL HIGHWAY ADMINISTRATOR	
APPROVED	DATE 01/20/16
DIRECTOR OF PROGRAM DEVELOPMENT	
APPROVED	DATE 01/19/2016
PROJECT MANAGER : T. FRENCH	
PROJECT NAME : NORTH HERO INTERIM REPAIRS	
PROJECT NUMBER : BF EWP1(1)	
SHEET 1 OF 4 SHEETS	