
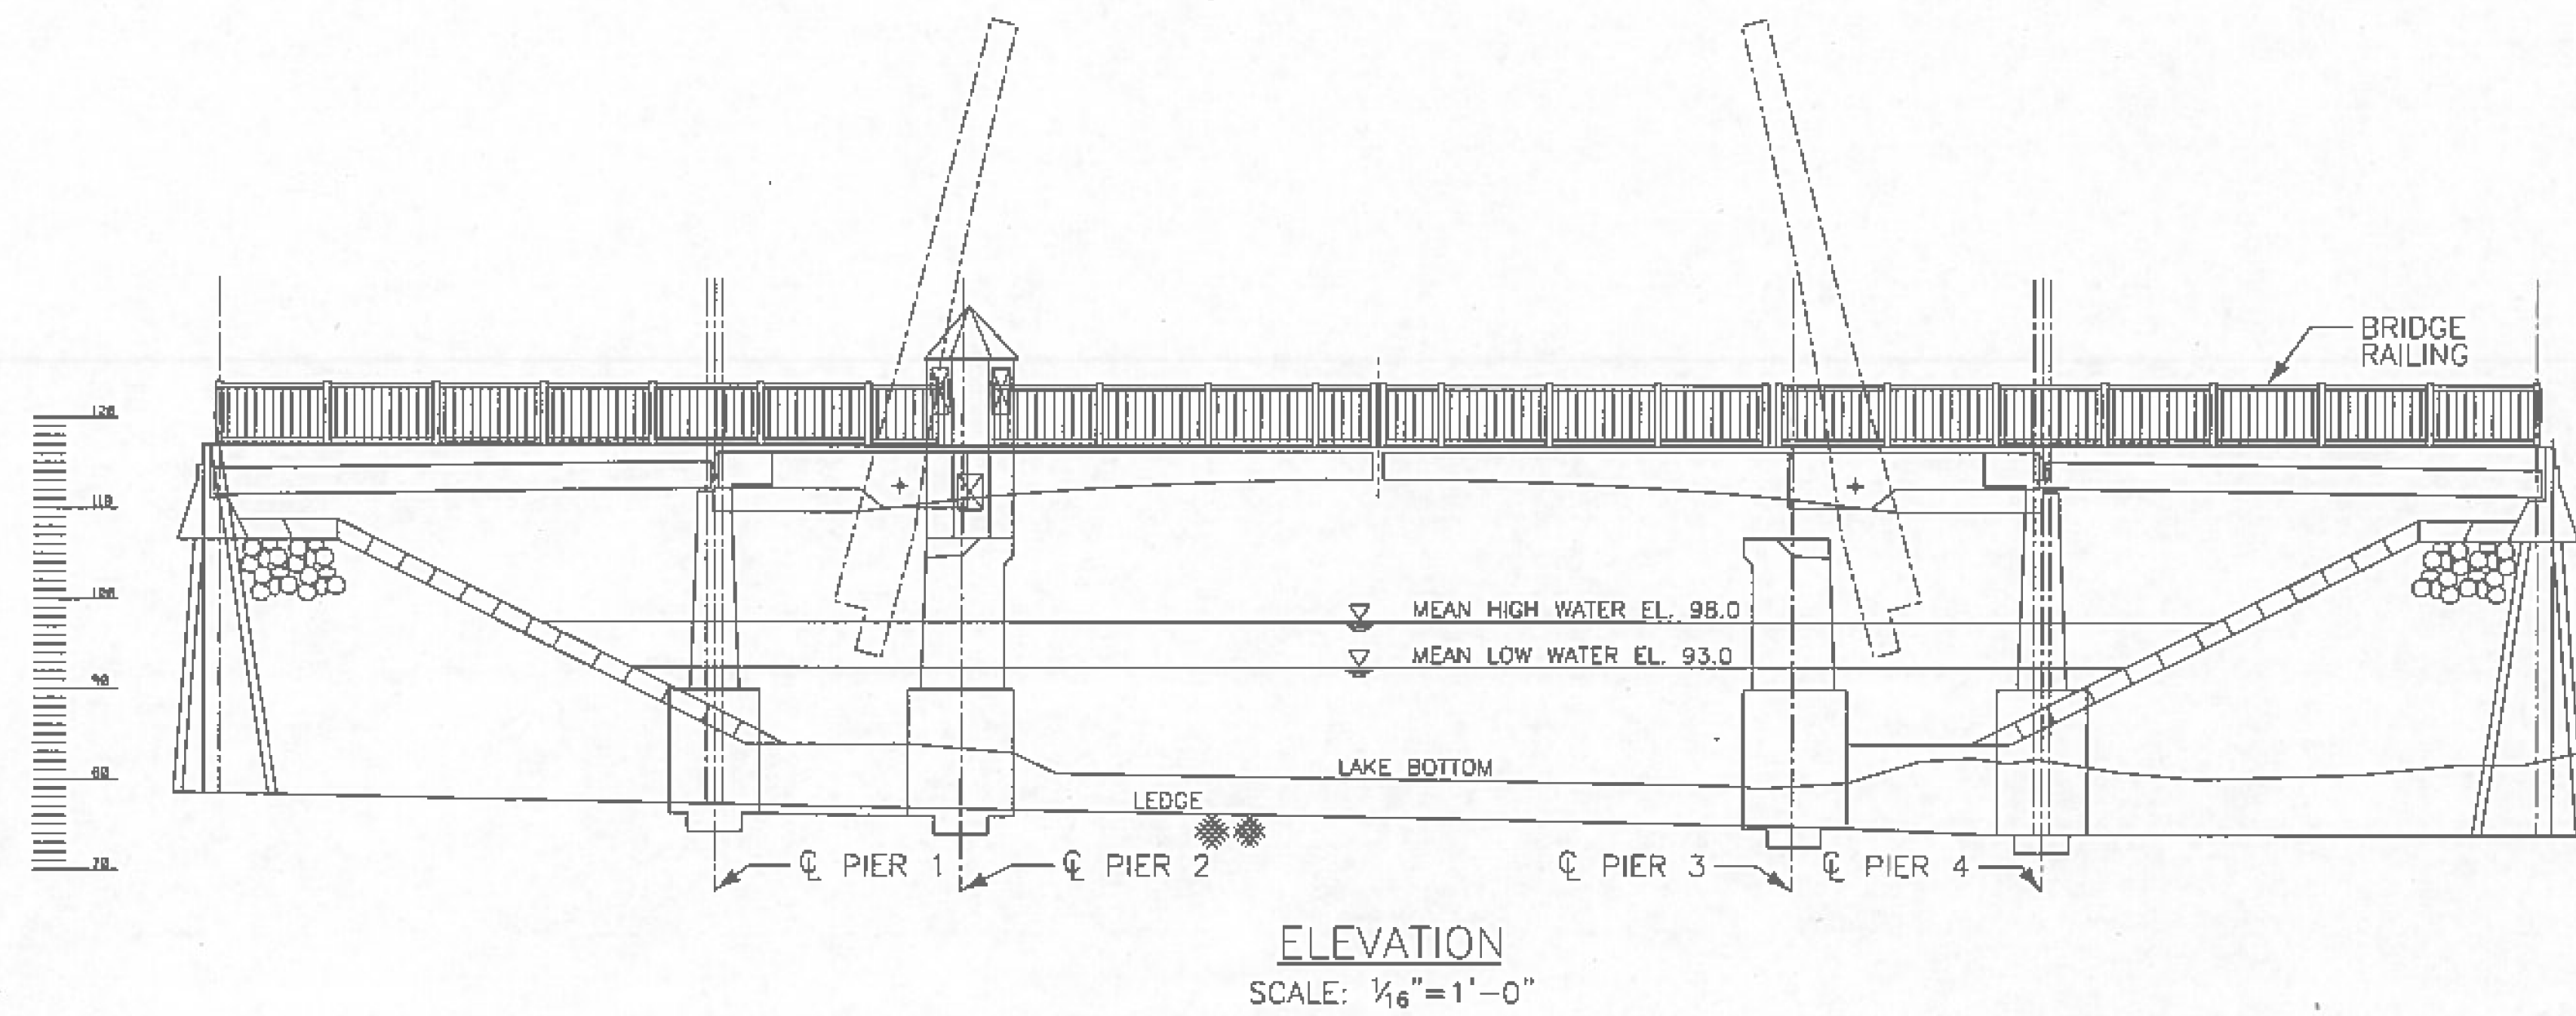


NOTES:

1. ALL MATERIAL AND CONSTRUCTION SHALL CONFORM TO THE STATE OF VERMONT AGENCY OF TRANSPORTATION'S "STANDARD SPECIFICATIONS FOR CONSTRUCTION," DATED 2011.
2. SEE MECHANICAL WORK ITEMS ON SHEET NO. 3.
3. SEE SHEET 2 OF 4 FOR PAY ITEMS AND QUANTITIES.

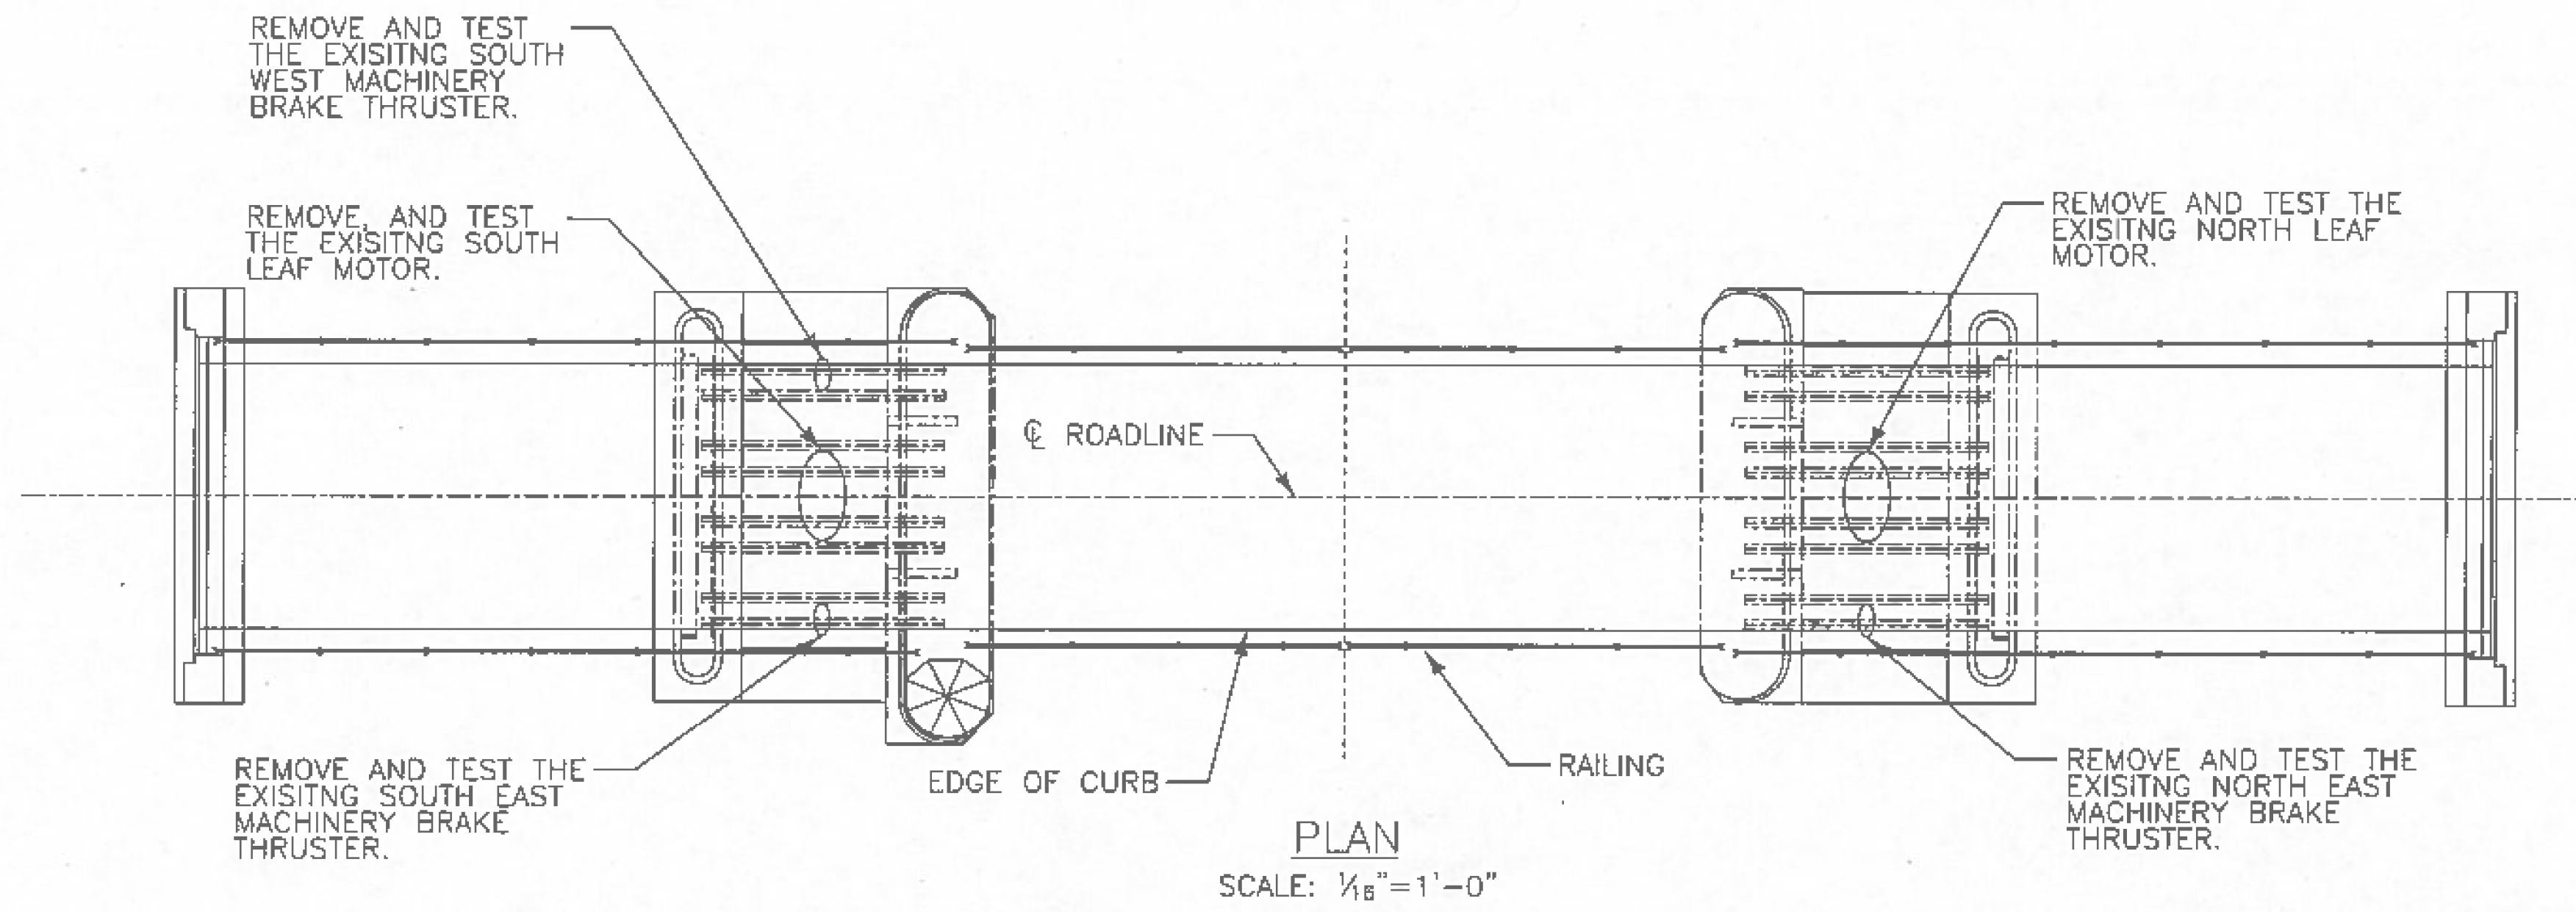

PROJECT NAME: NORTH HERO INTERIM REPAIRS	PLOT DATE: 01/19/2016
PROJECT NUMBER: BF EWP1(1)	DRAWN BY: S. YEARWOOD
FILE NAME: z12b142bdr_ewp1.dgn	CHECKED BY: K. HAJJEH
PROJECT LEADER: T. FRENCH	SHEET 4 OF 4
DESIGNED BY: Y. ADELEKAN	
WORK PACKAGE 1 - ELECTRICAL	