


STEEL BEAM GUARDRAIL, GALVANIZED (WITH 8 FOOT POSTS)
 STA 55+50.00 - 56+76.31, LT
 STA 55+50.00 - 56+88.02, RT

ANCHOR FOR STEEL BEAM RAIL
 STA 56+65.00, LT
 STA 56+75.00, RT

CURVE (3)
 DELTA = 14° 27' 42"
 D = 19° 05' 55"
 R = 300.00'
 T = 38.06'
 L = 75.72'
 E = 2.40'

CURVE (4)
 DELTA = 44° 57' 39.38"
 D = 19° 05' 55"
 R = 300.00'
 T = 112.05'
 L = 214.47'
 E = 20.24'

TEMPORARY ROADWAY LAYOUT 2

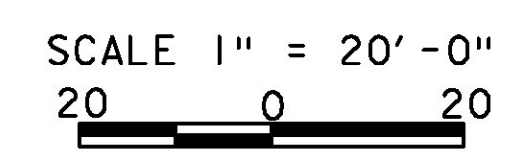

LIMITS OF STRUCTURE

NOTE: ITEM DESCRIPTIONS AND STATION RANGES PROVIDED ARE TO AID IN THE LAYOUT AND CONSTRUCTION OF THE TEMPORARY ROADWAY. ALL ITEMS ARE INCIDENTAL TO ITEM 528.11, "TWO-WAY TEMPORARY BRIDGE."

TYLIN INTERNATIONAL	PROJECT NAME: DUXBURY	PLOT DATE: 5/23/2016
	PROJECT NUMBER: BF 013-4(47)	DRAWN BY: T. KELLEY
	FILE NAME: z16b001r.dwg	CHECKED BY: D. BRYANT
	DESIGNED BY: T. KELLEY	SHEET 17 OF 69
	TEMPORARY ROADWAY LAYOUT 2	