




54+00

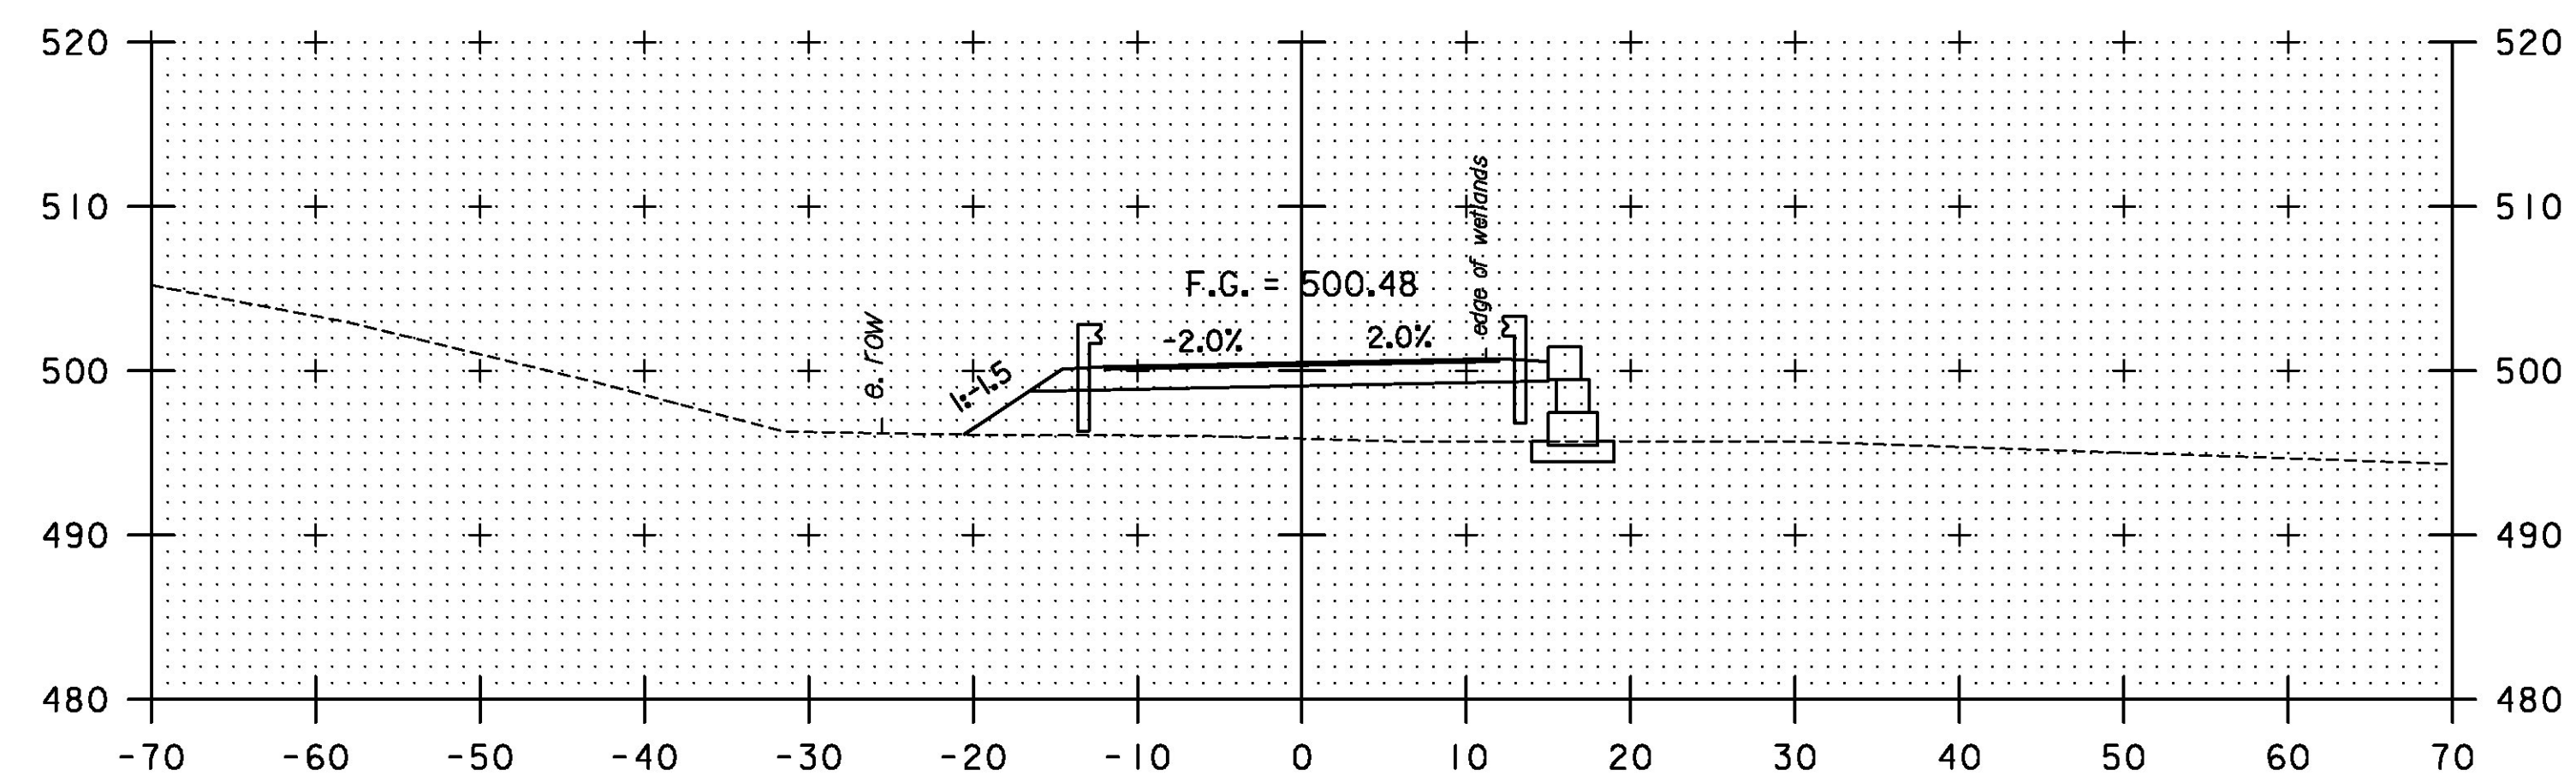


53+75

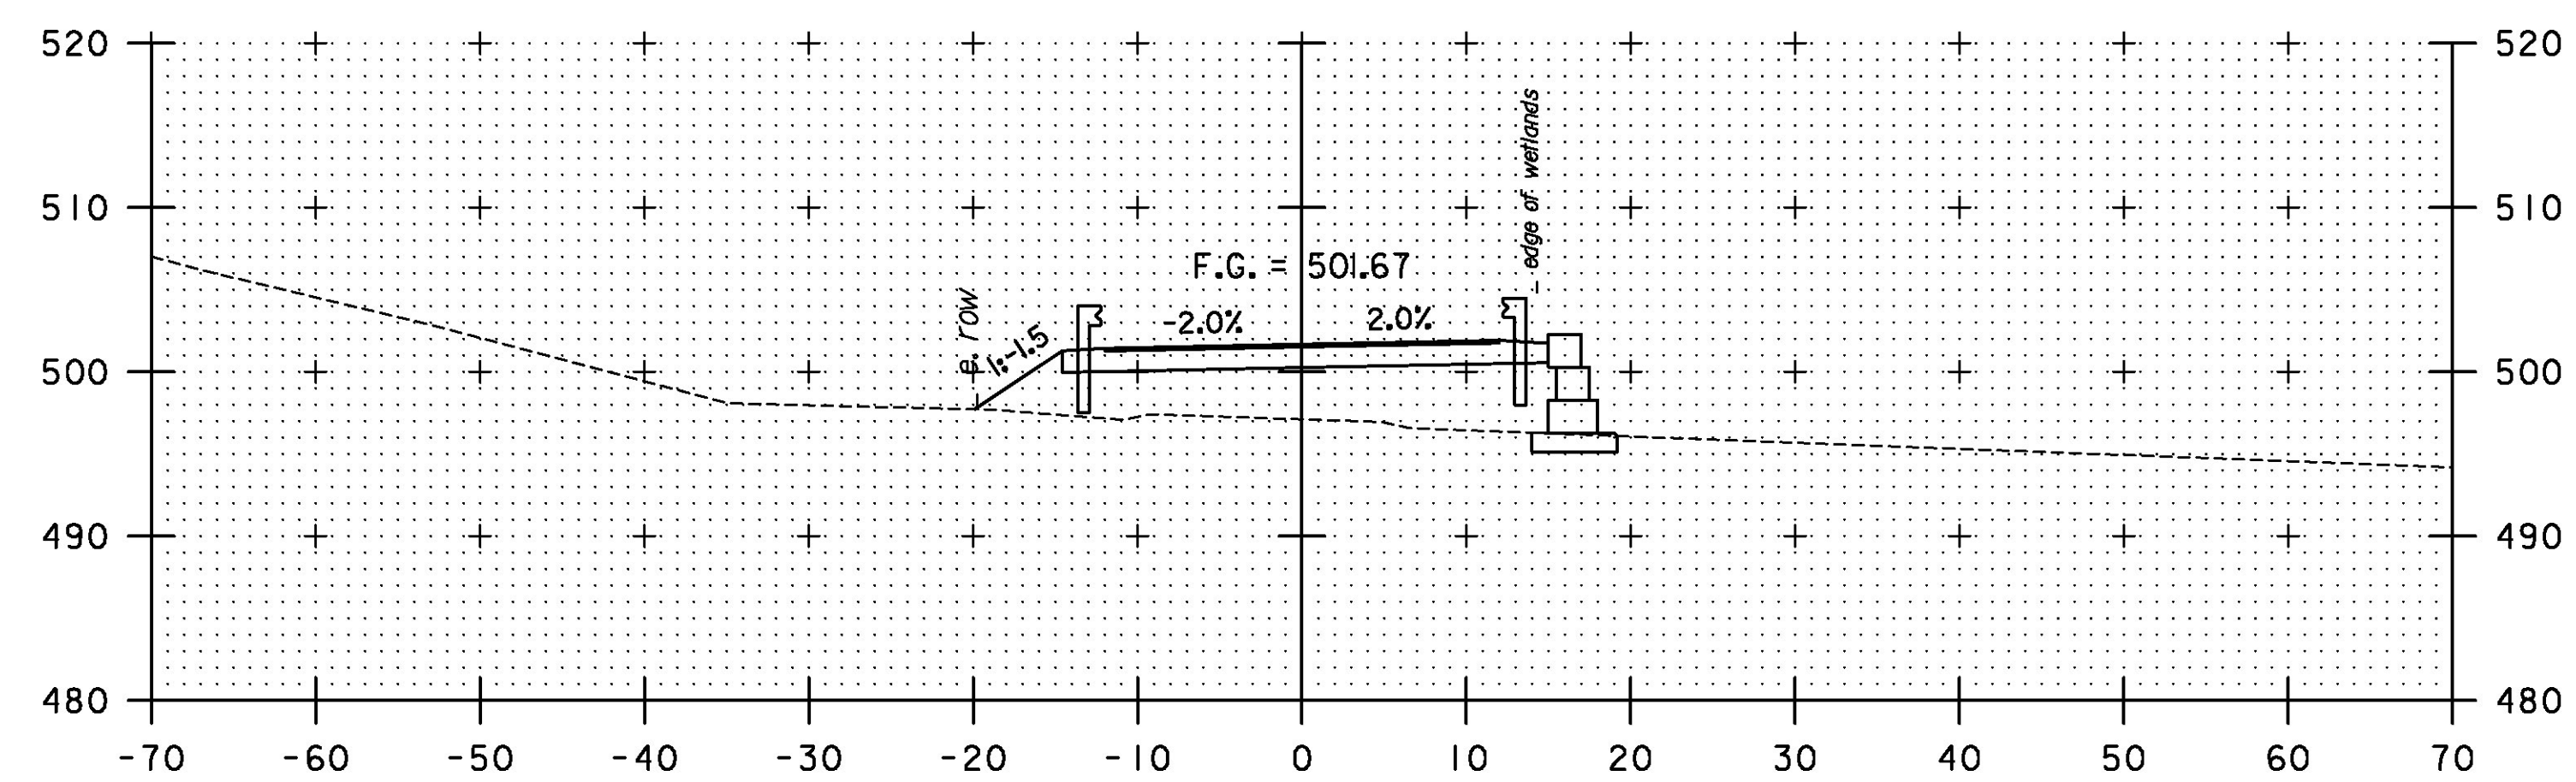

53+50

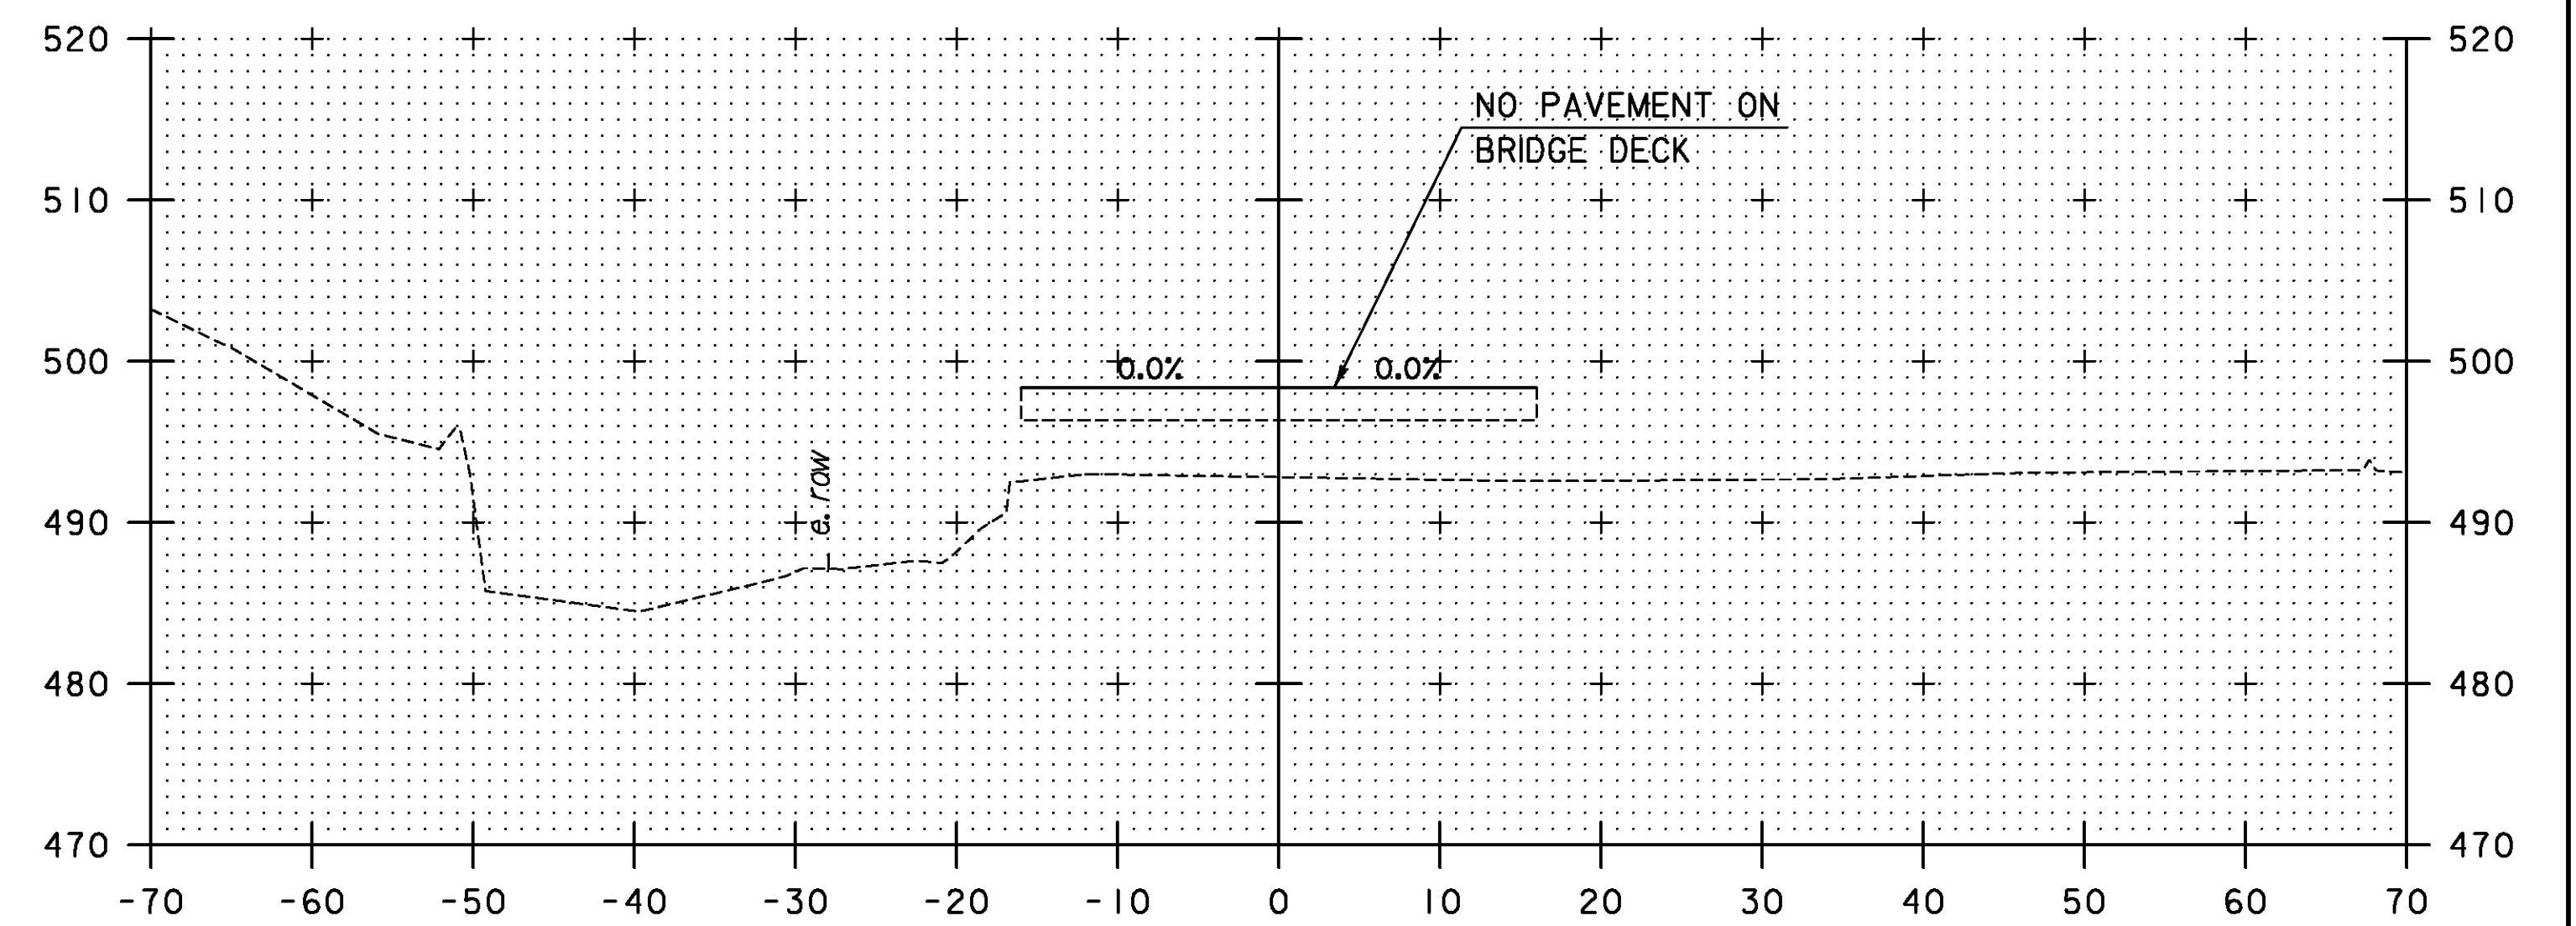

54+50
BEGIN BRIDGE 54+40.00

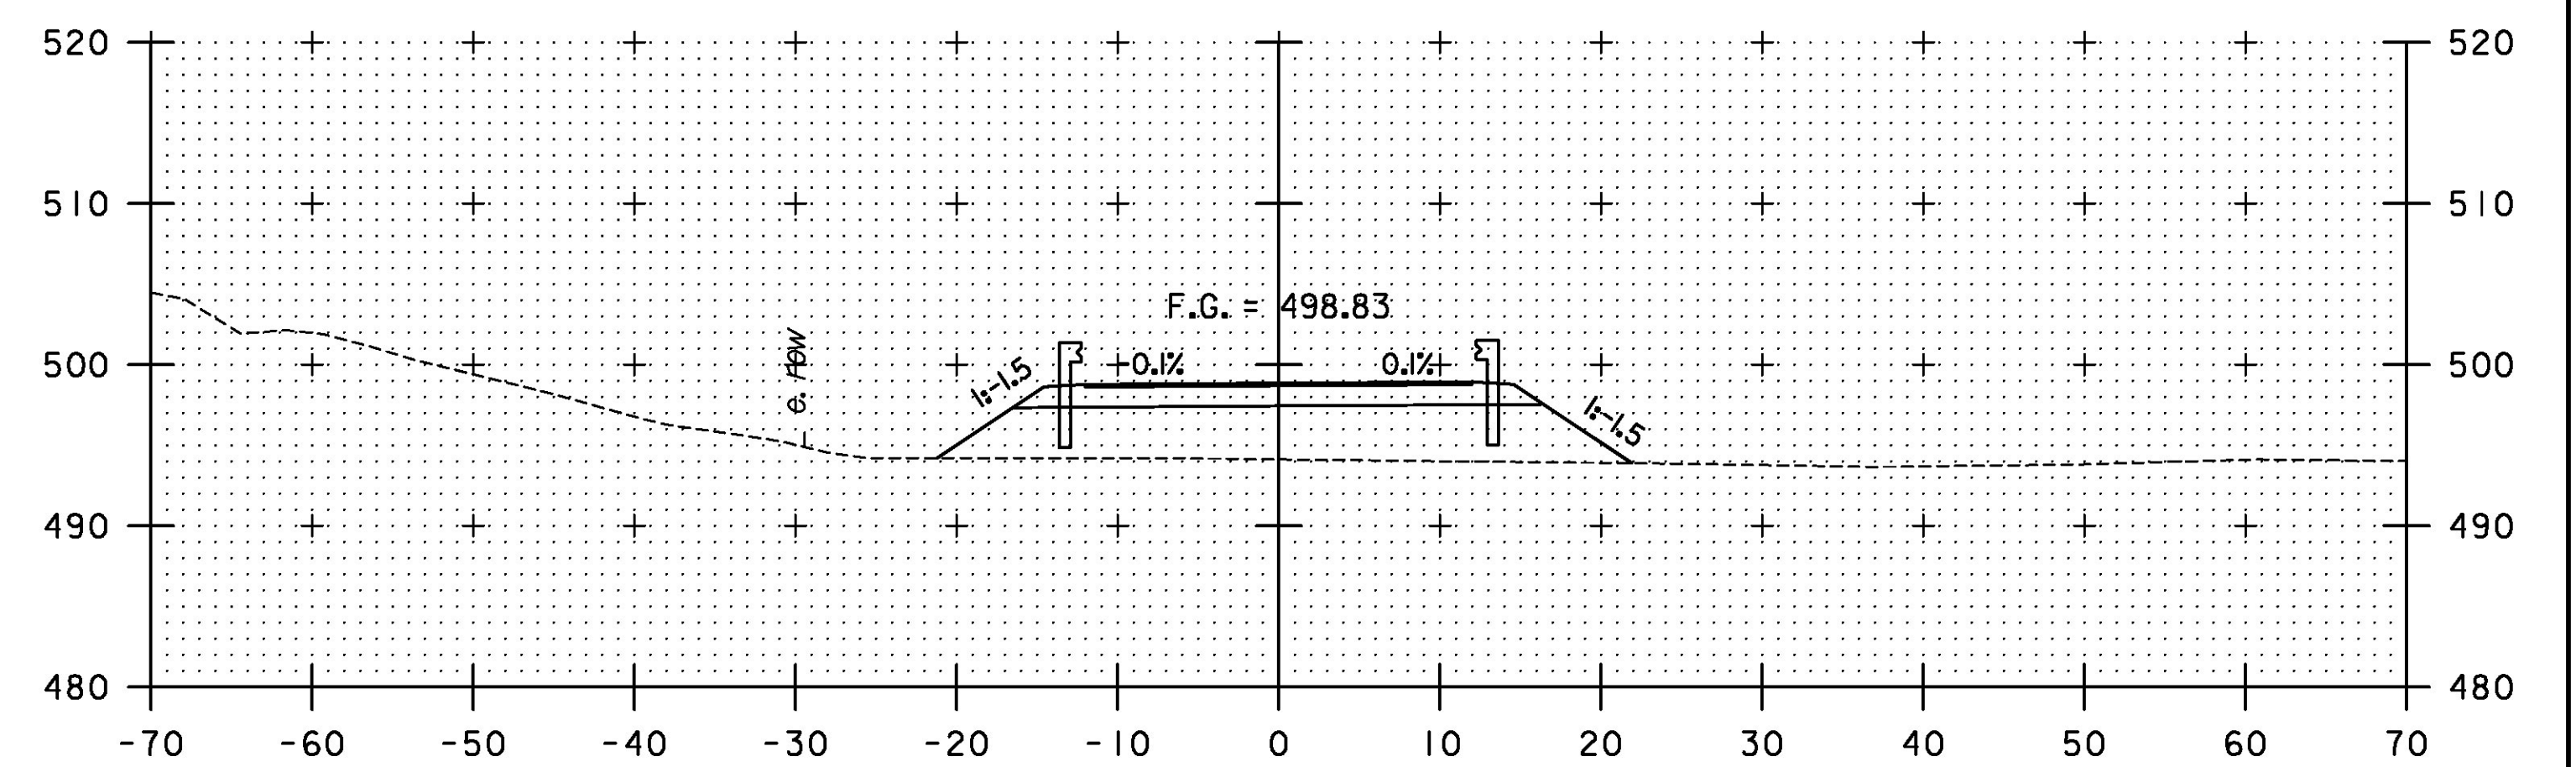

54+25

STA. 53+50 TO STA. 54+50

TYLIN INTERNATIONAL

PROJECT NAME:	DUXBURY	PLOT DATE:	5/23/2016
PROJECT NUMBER:	BF 013-4(47)	DRAWN BY:	T. KELLEY
FILE NAME:	z16b001trdwy_xs.dgn	CHECKED BY:	J. HOWE
PROJECT LEADER:	J. OLUND	TEMPORARY ROADWAY CROSS SECTIONS 3	SHEET 23 OF 69
DESIGNED BY:	T. KELLEY		