




55+00

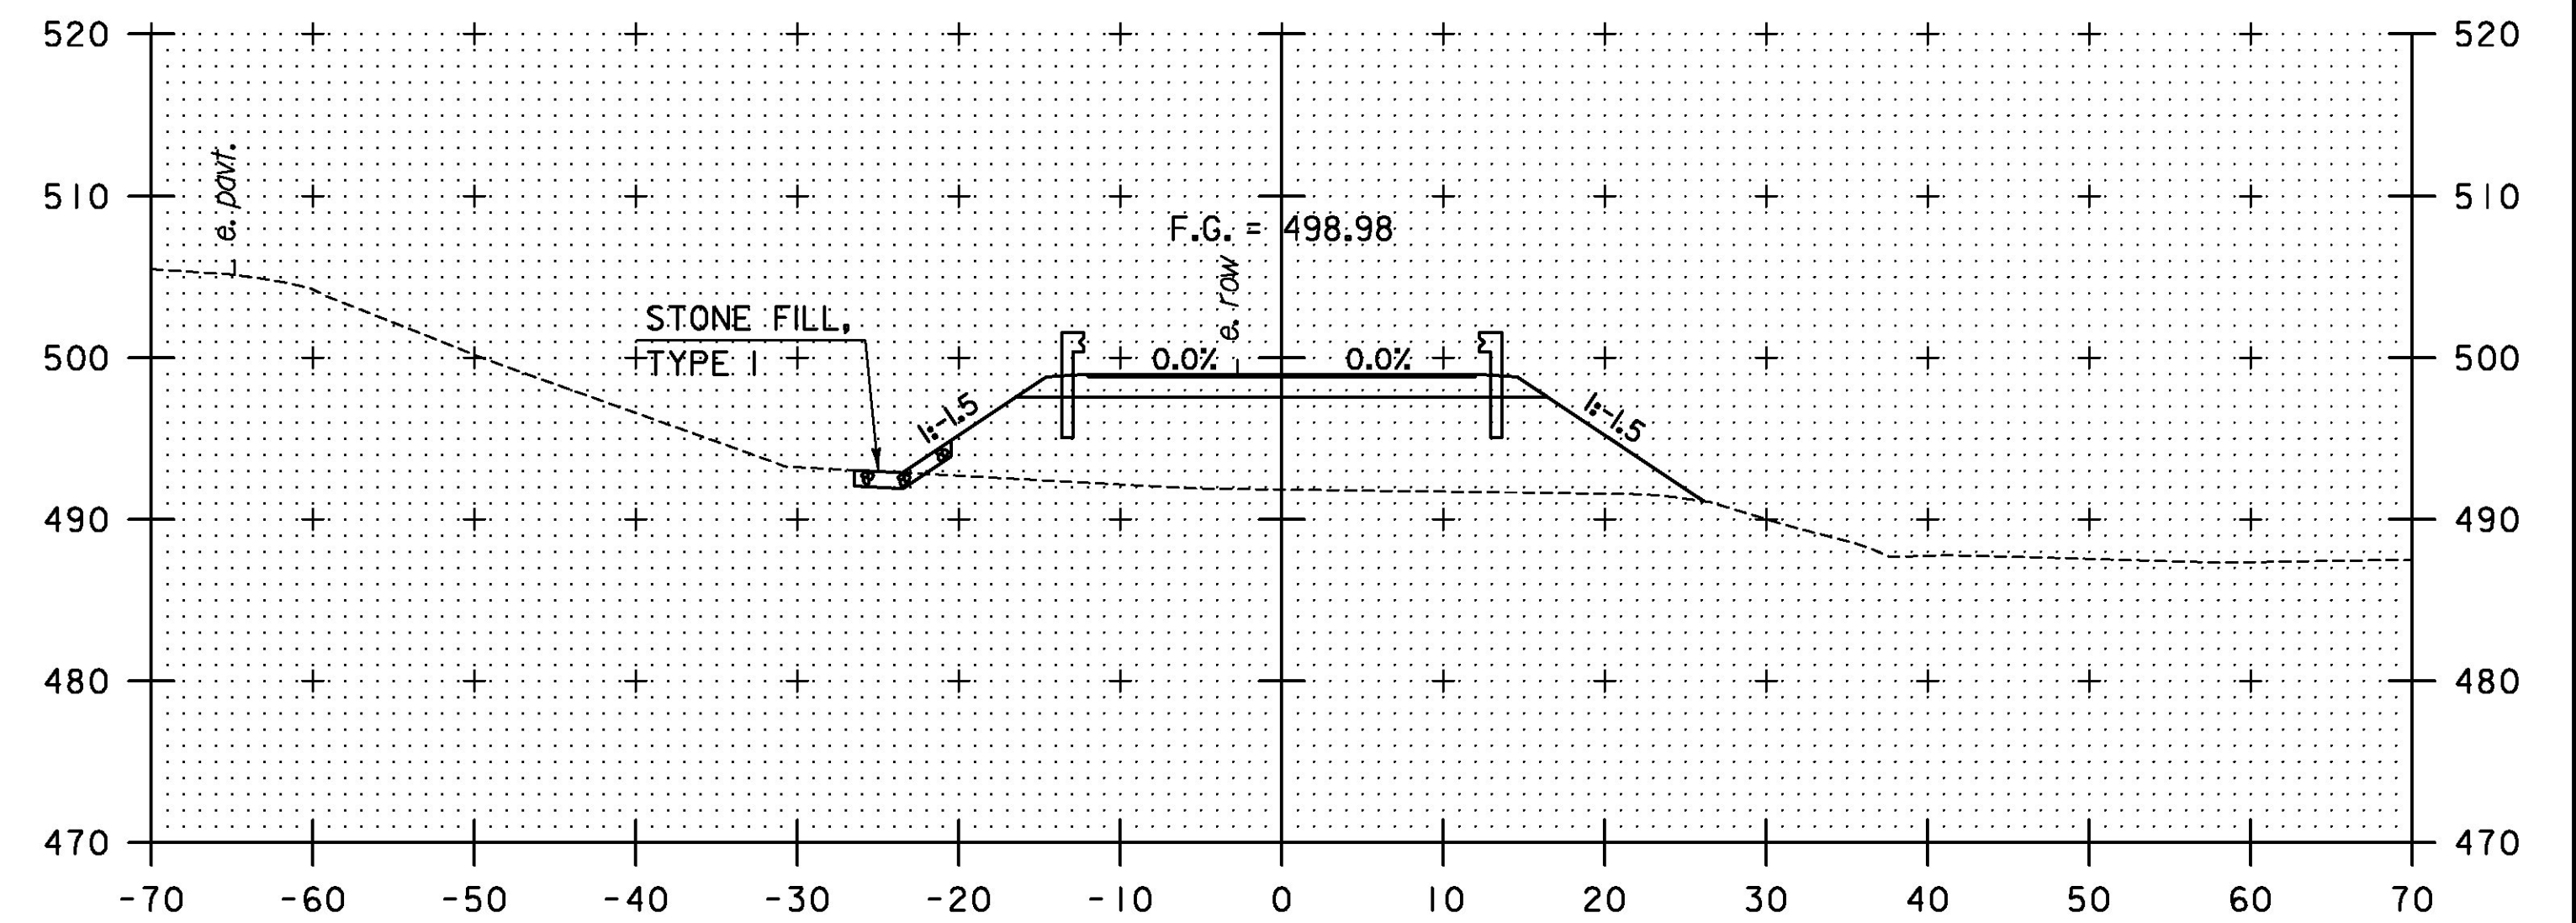

55+50  
END BRIDGE 55+50.00

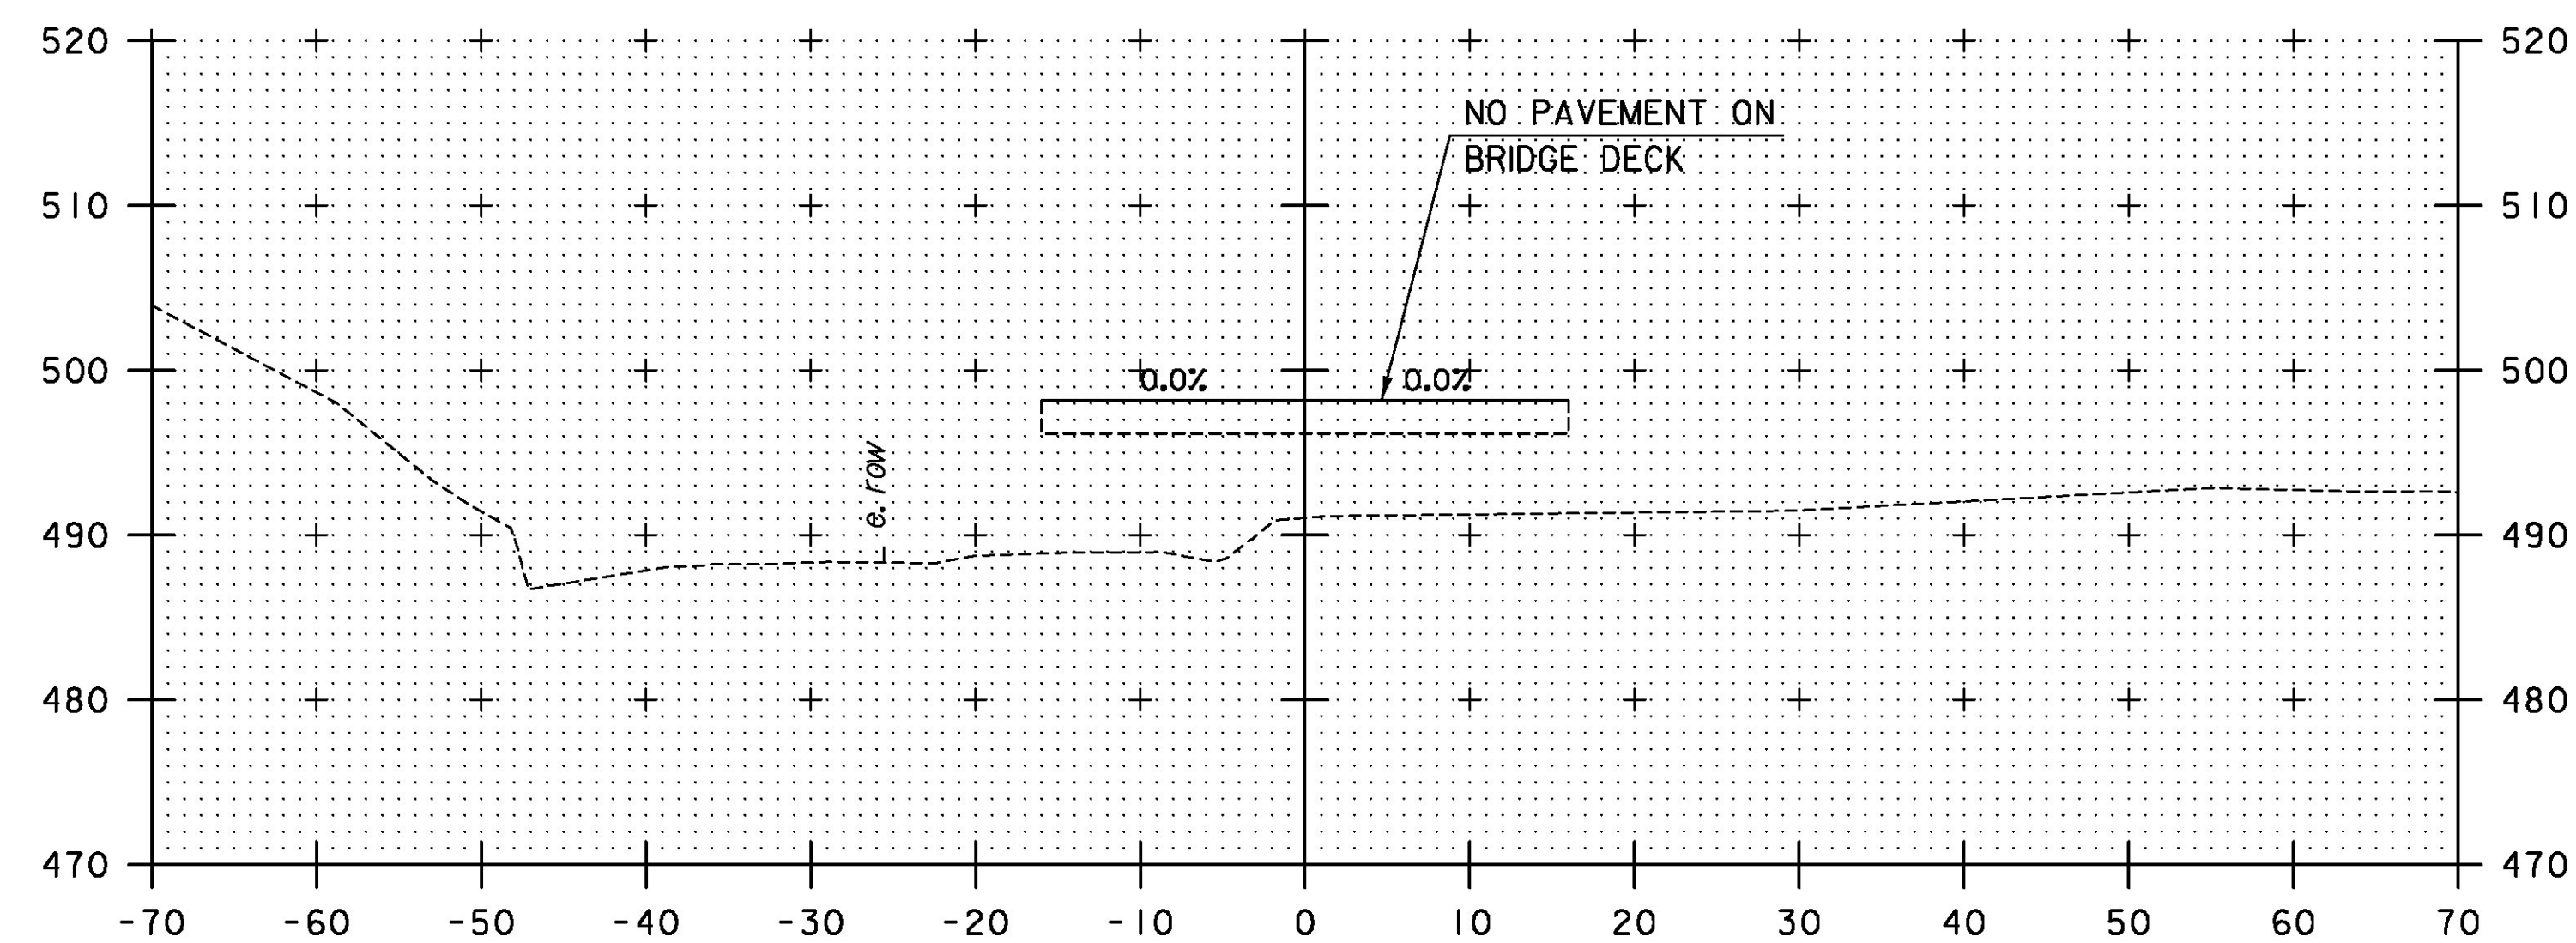

54+75

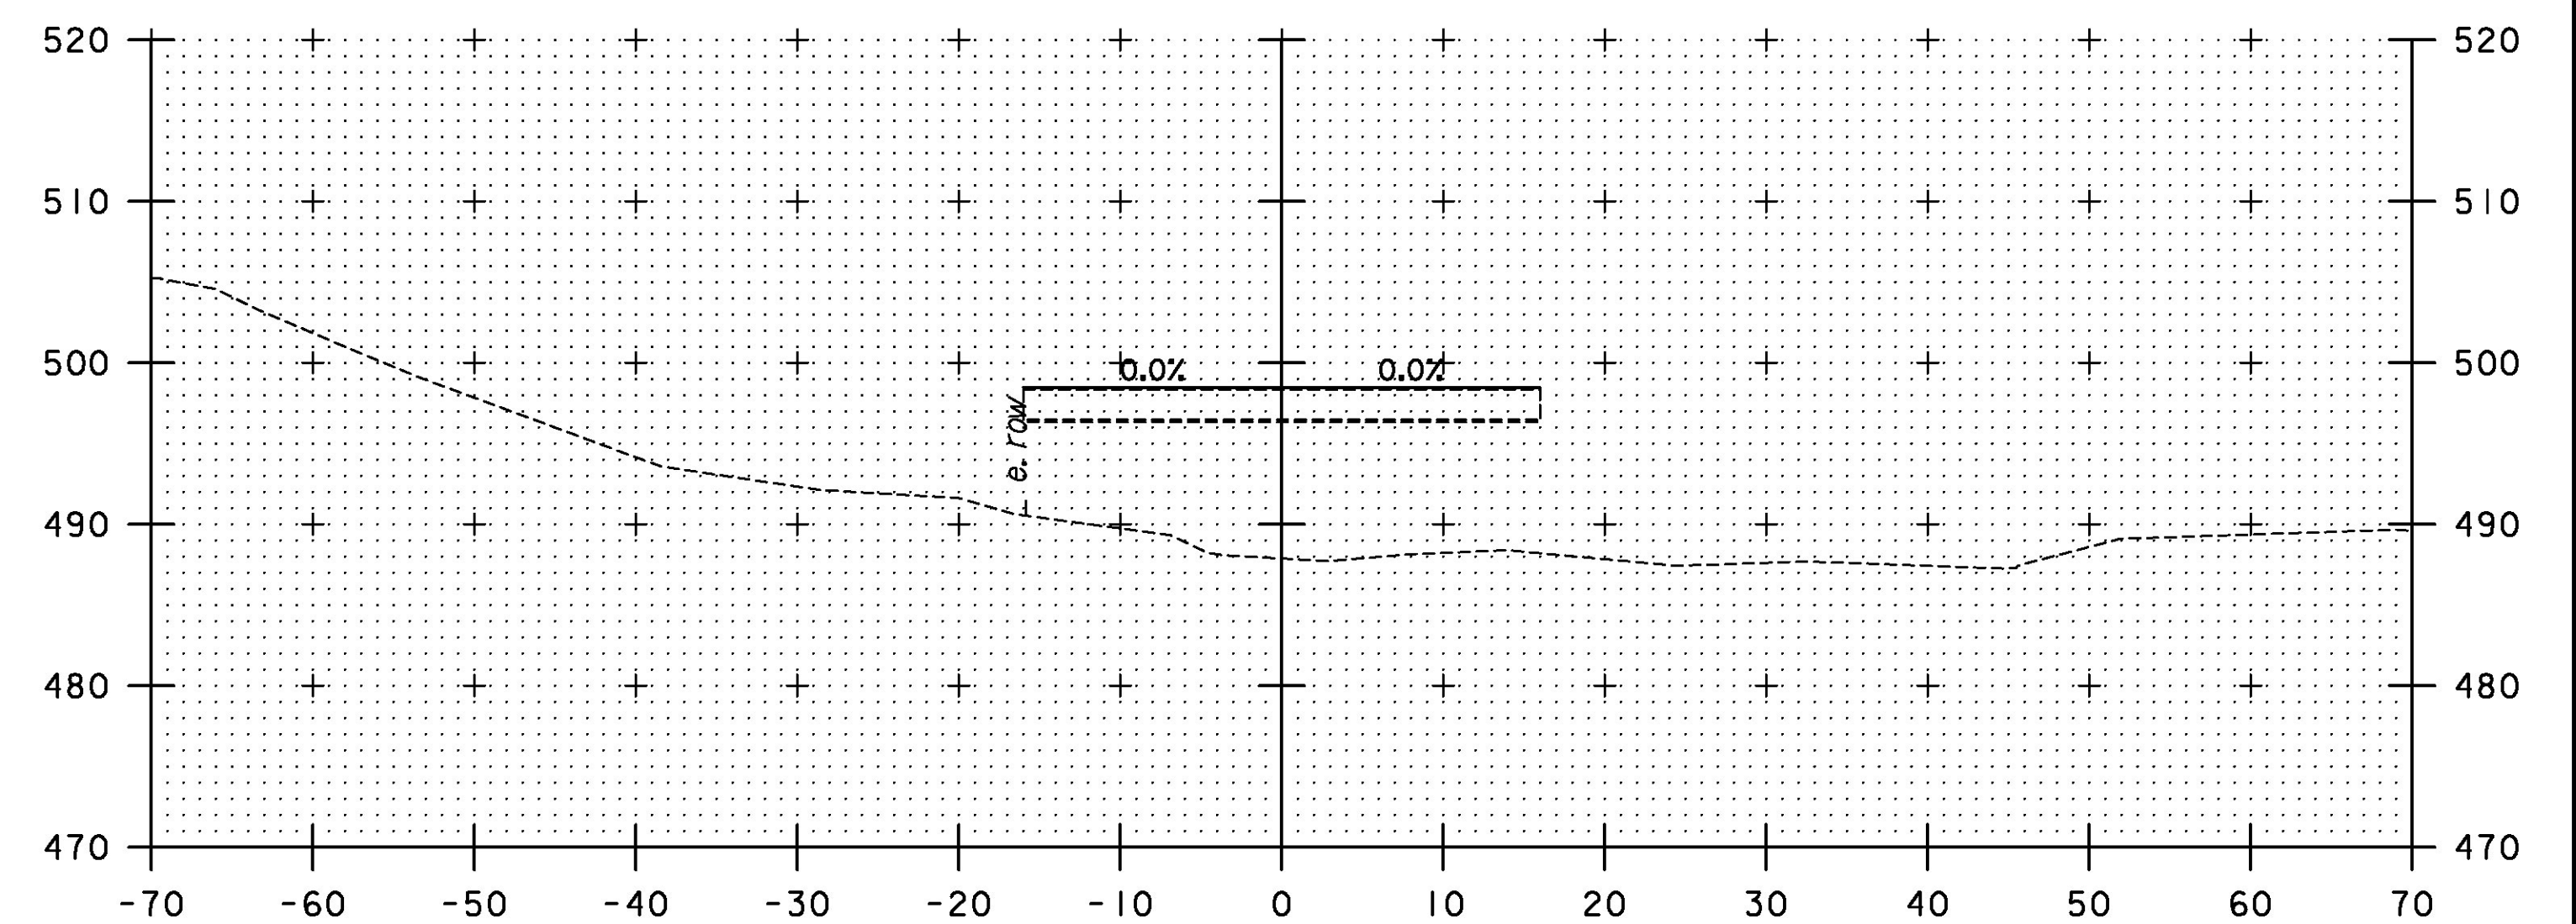

55+25

STA. 54+75 TO STA. 55+50

TYLINTERNATIONAL

PROJECT NAME: DUXBURY  
PROJECT NUMBER: BF 013-4(47)

FILE NAME: z16b001rwdwy\_xs.dgn  
PROJECT LEADER: J. OLUND  
DESIGNED BY: T. KELLEY  
TEMPORARY ROADWAY CROSS SECTIONS 4

PLOT DATE: 5/23/2016  
DRAWN BY: T. KELLEY  
CHECKED BY: J. HOWE  
SHEET 24 OF 69