




57+75

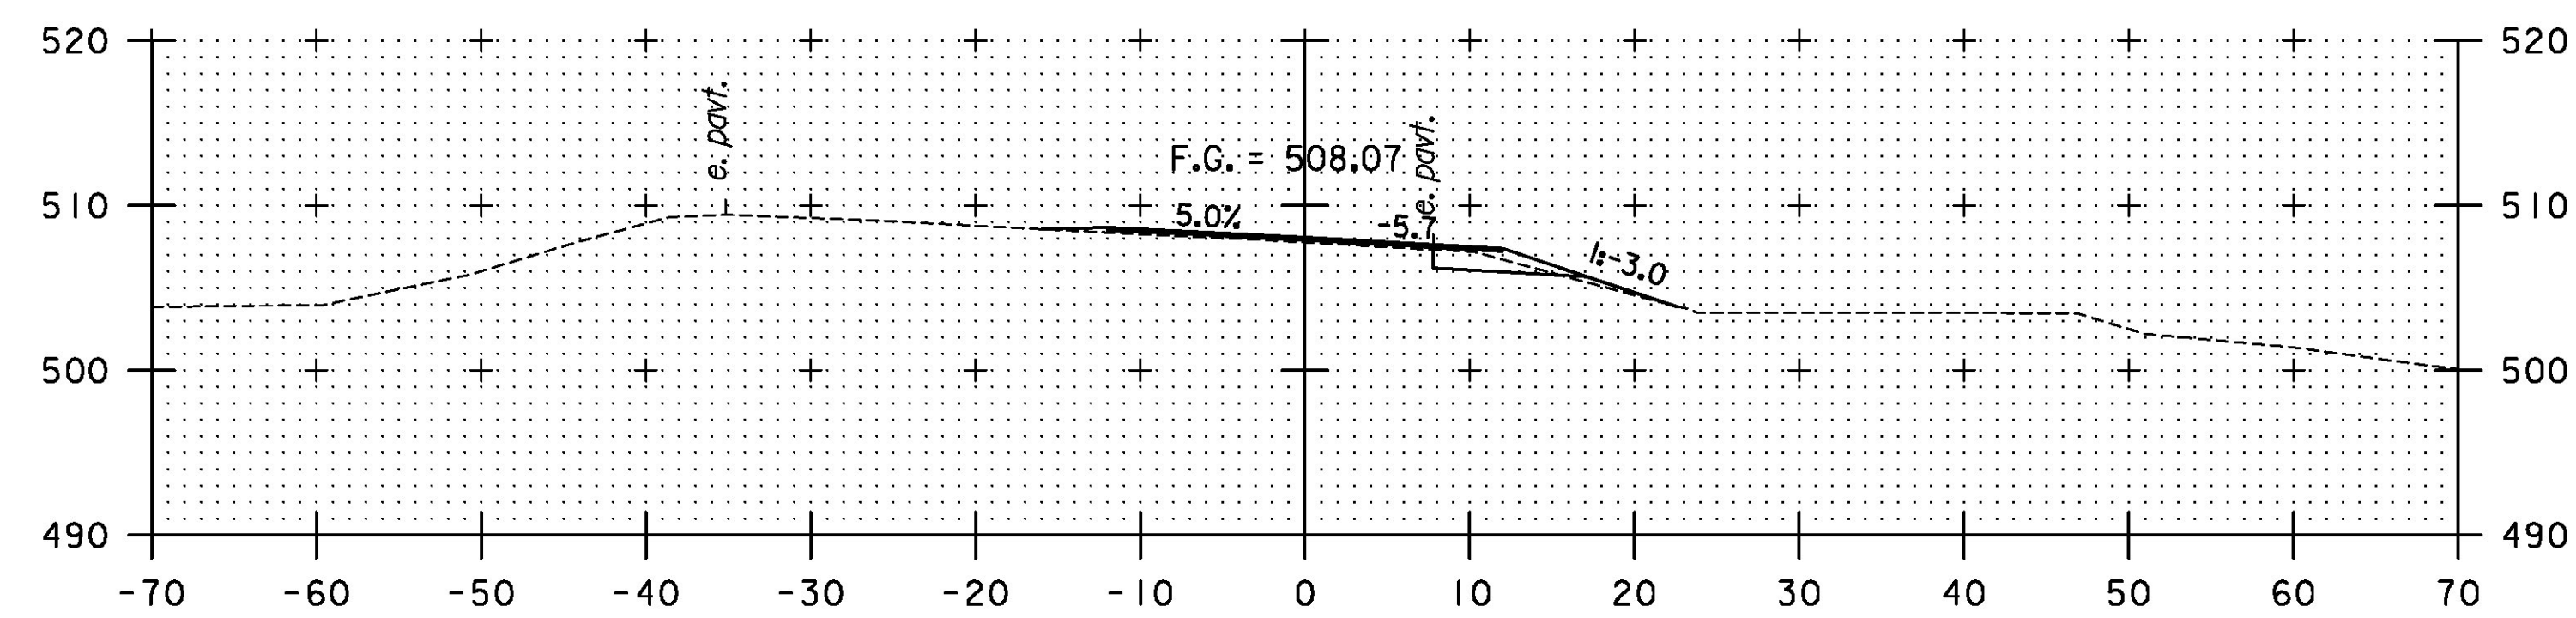


57+50

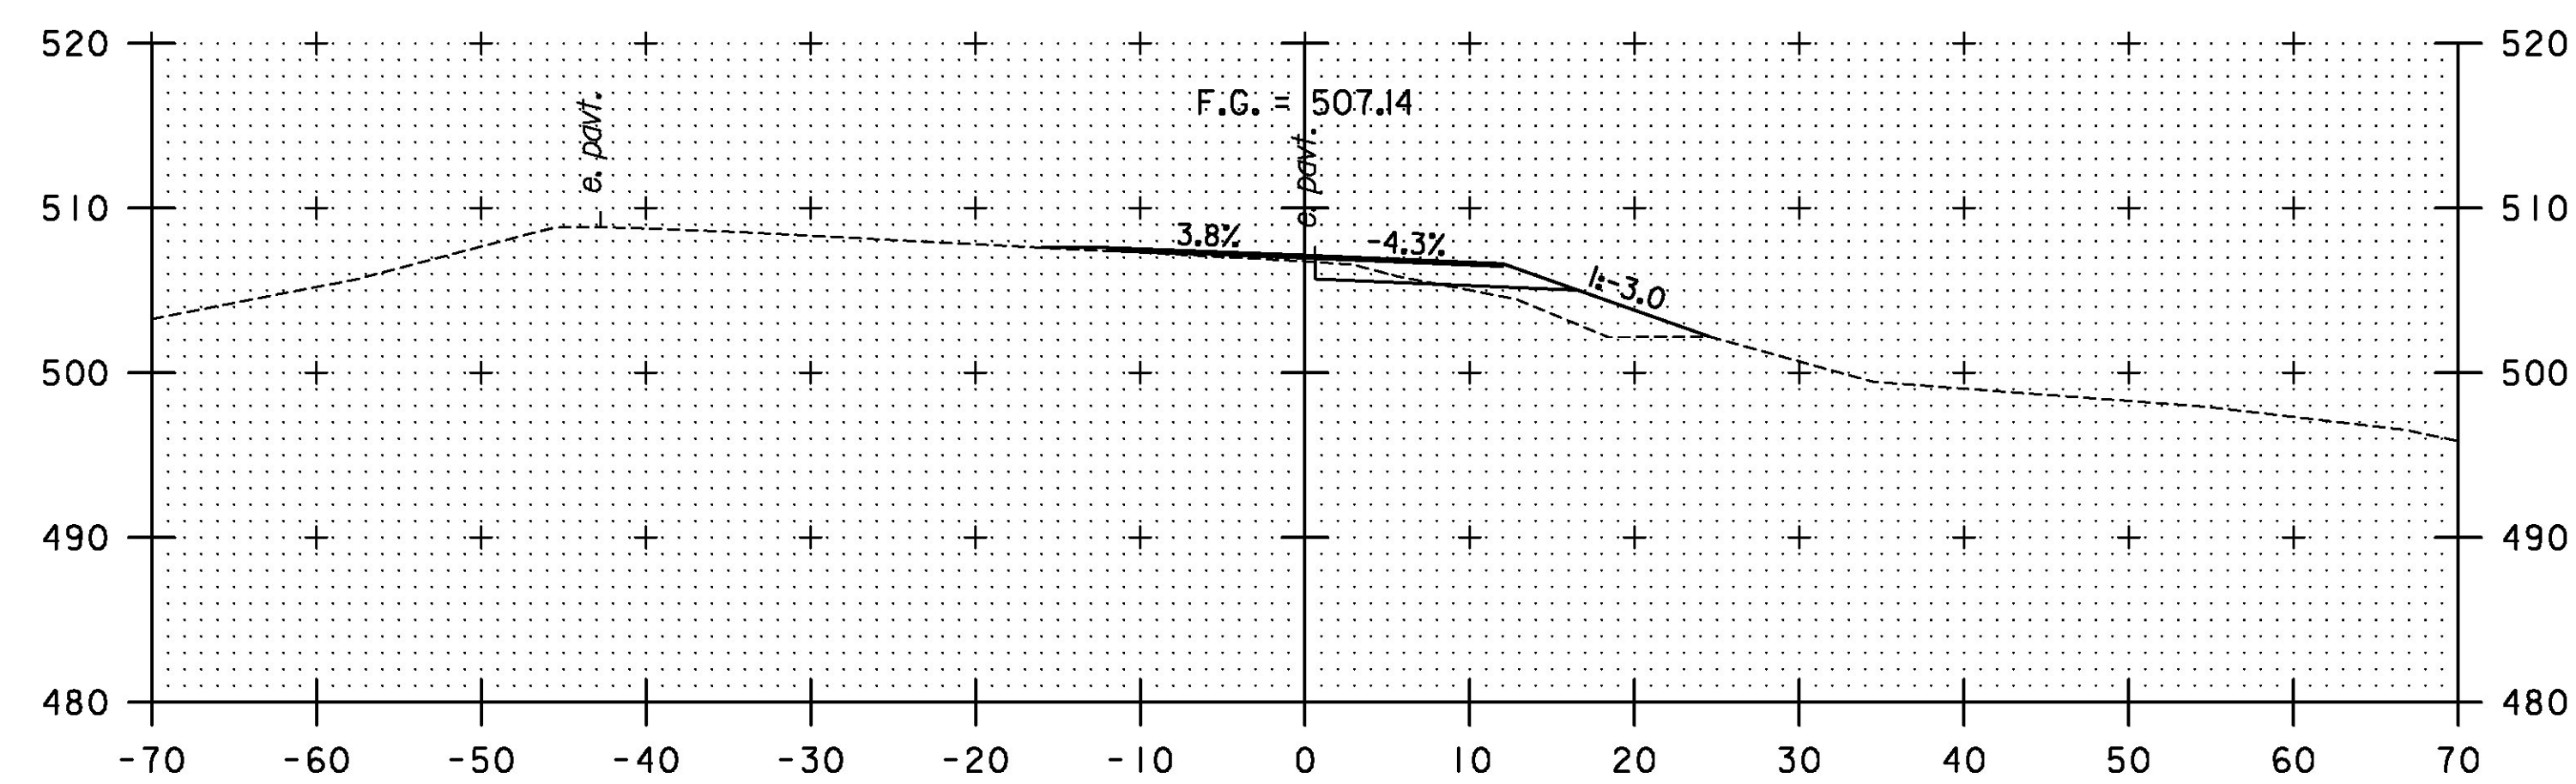


57+25

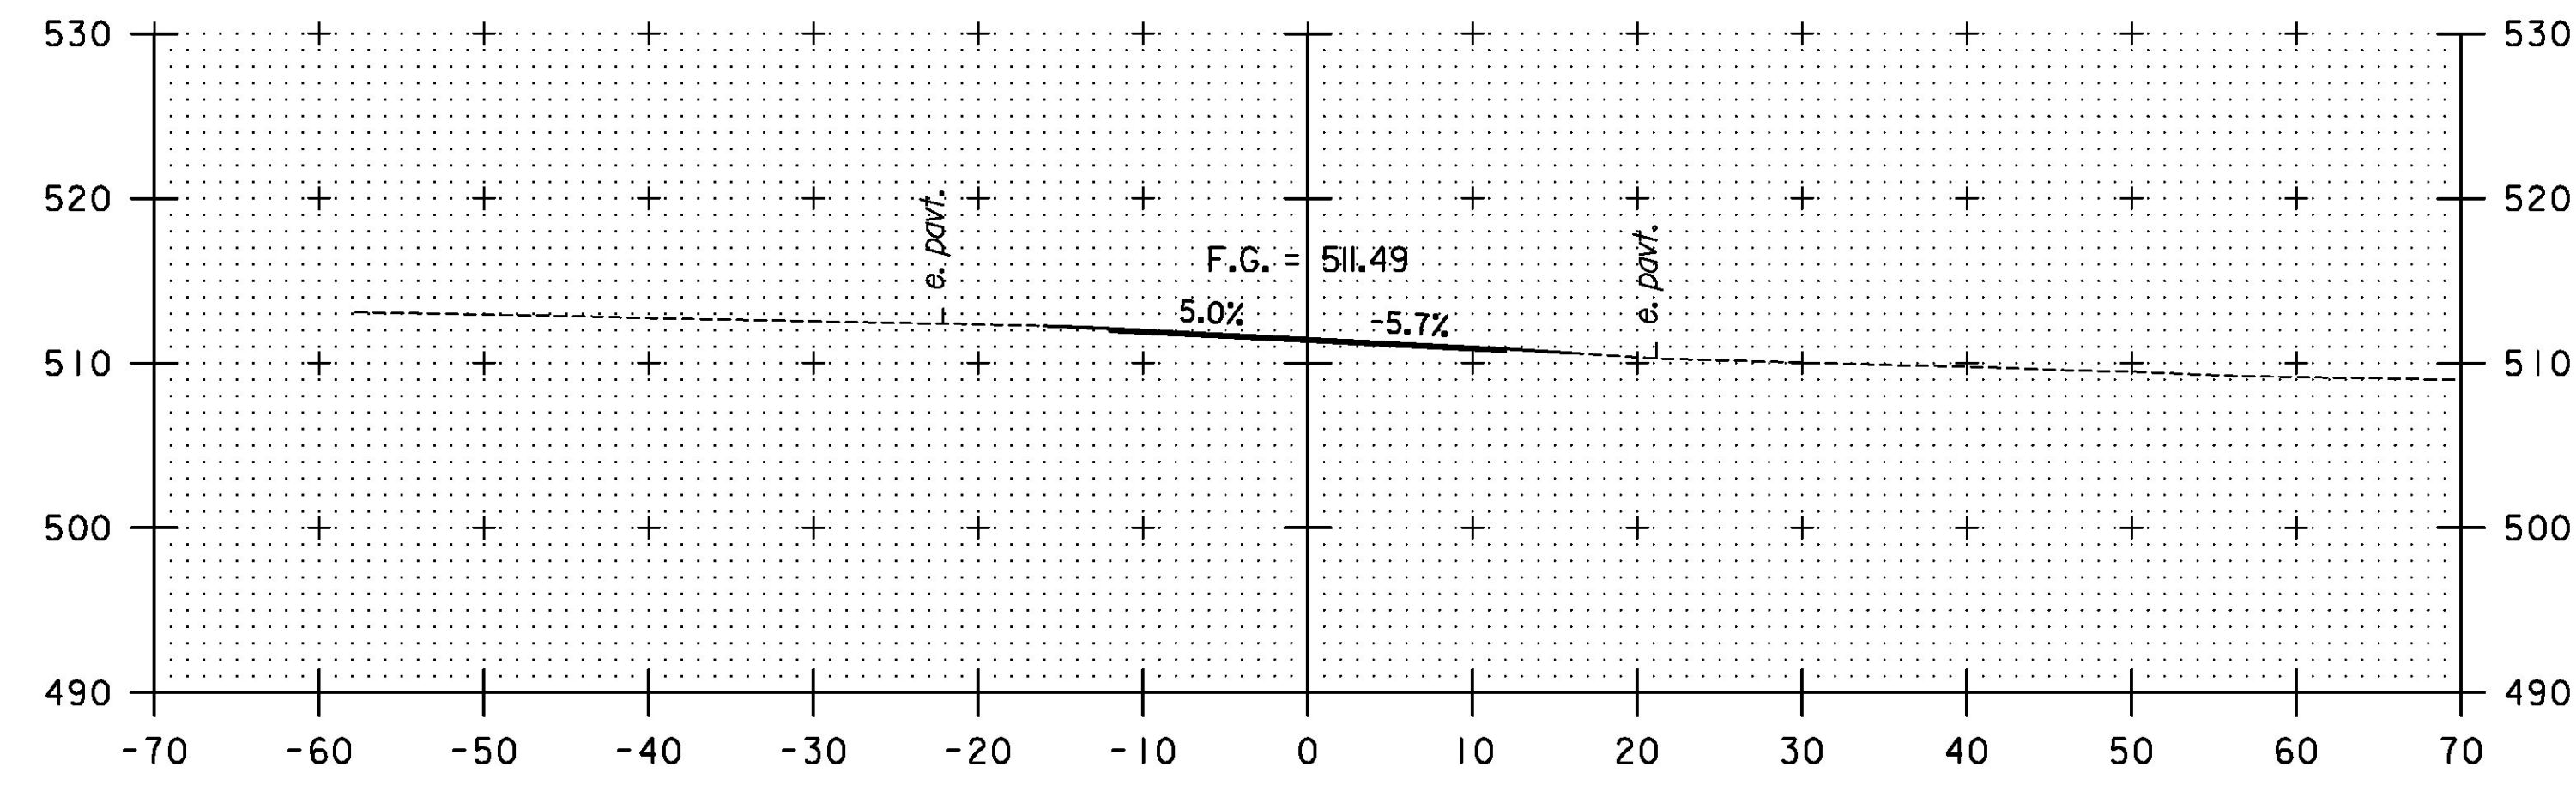

58+50

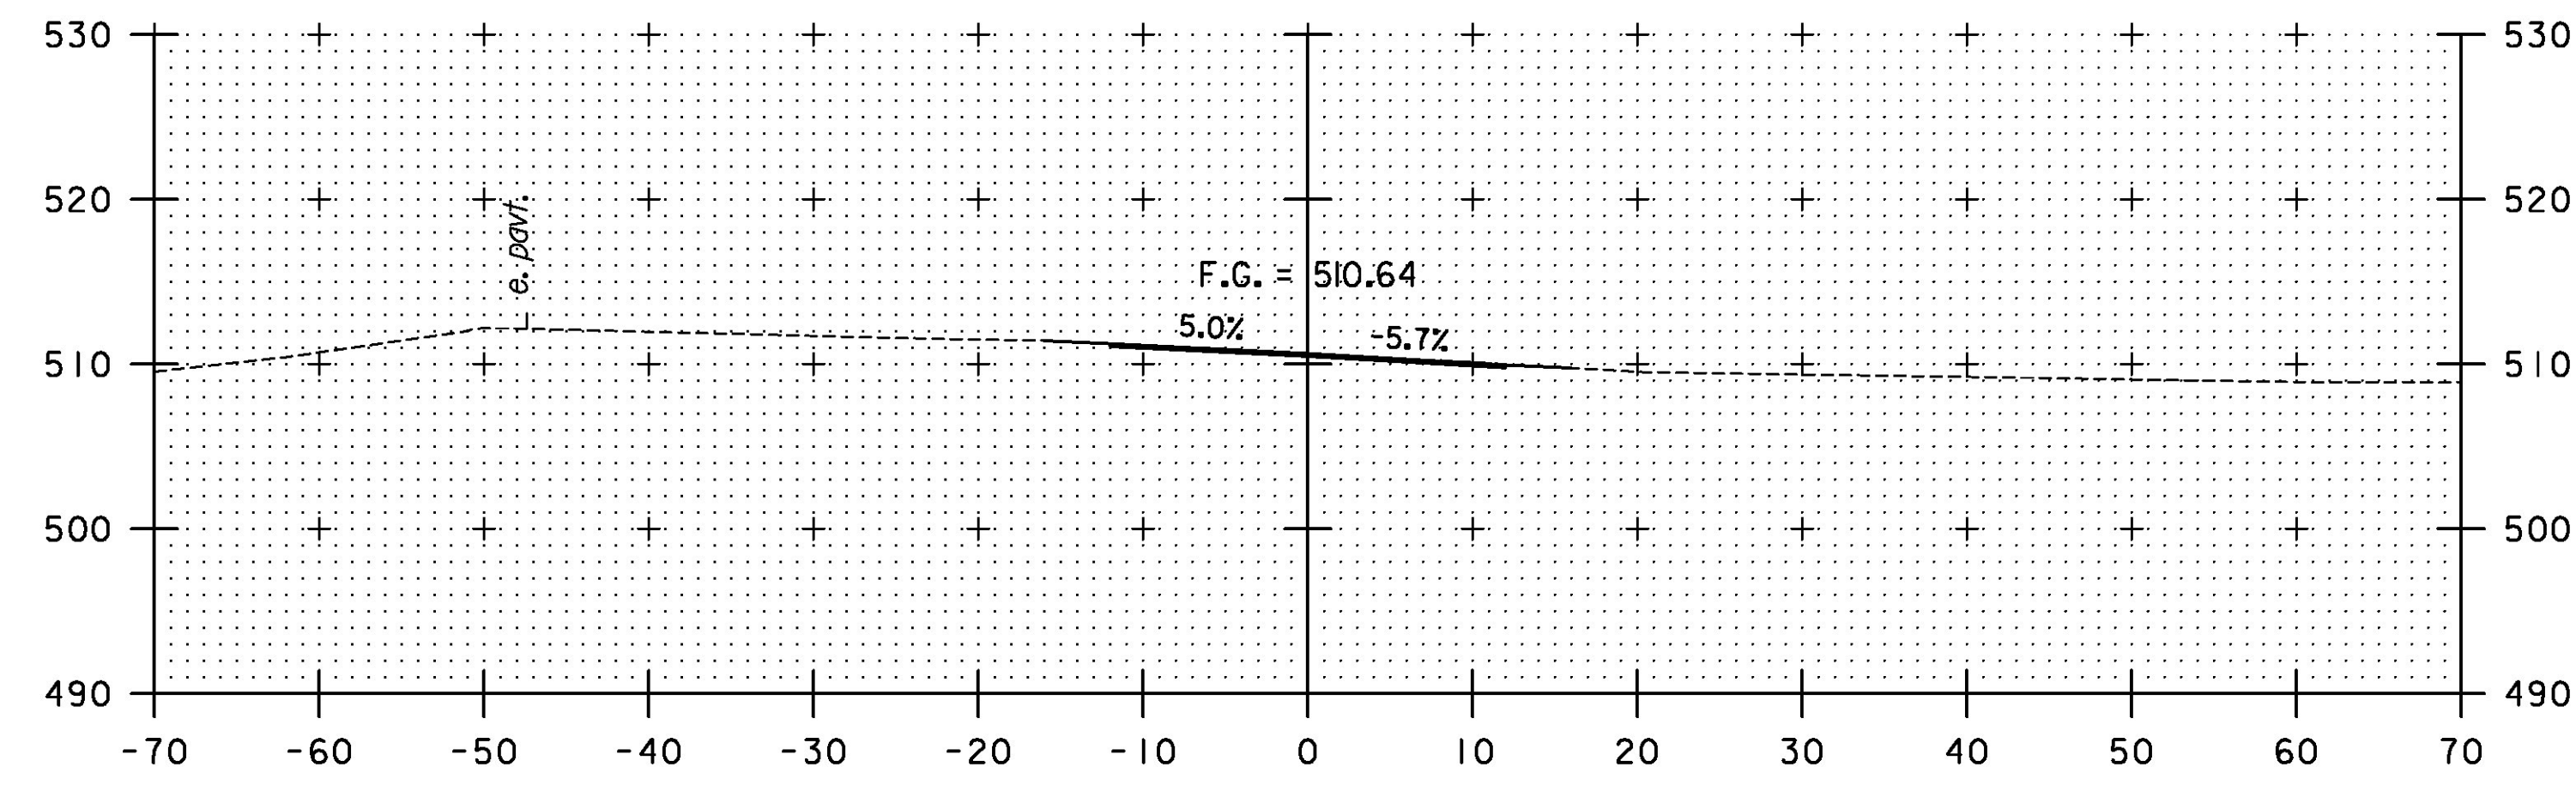

58+25

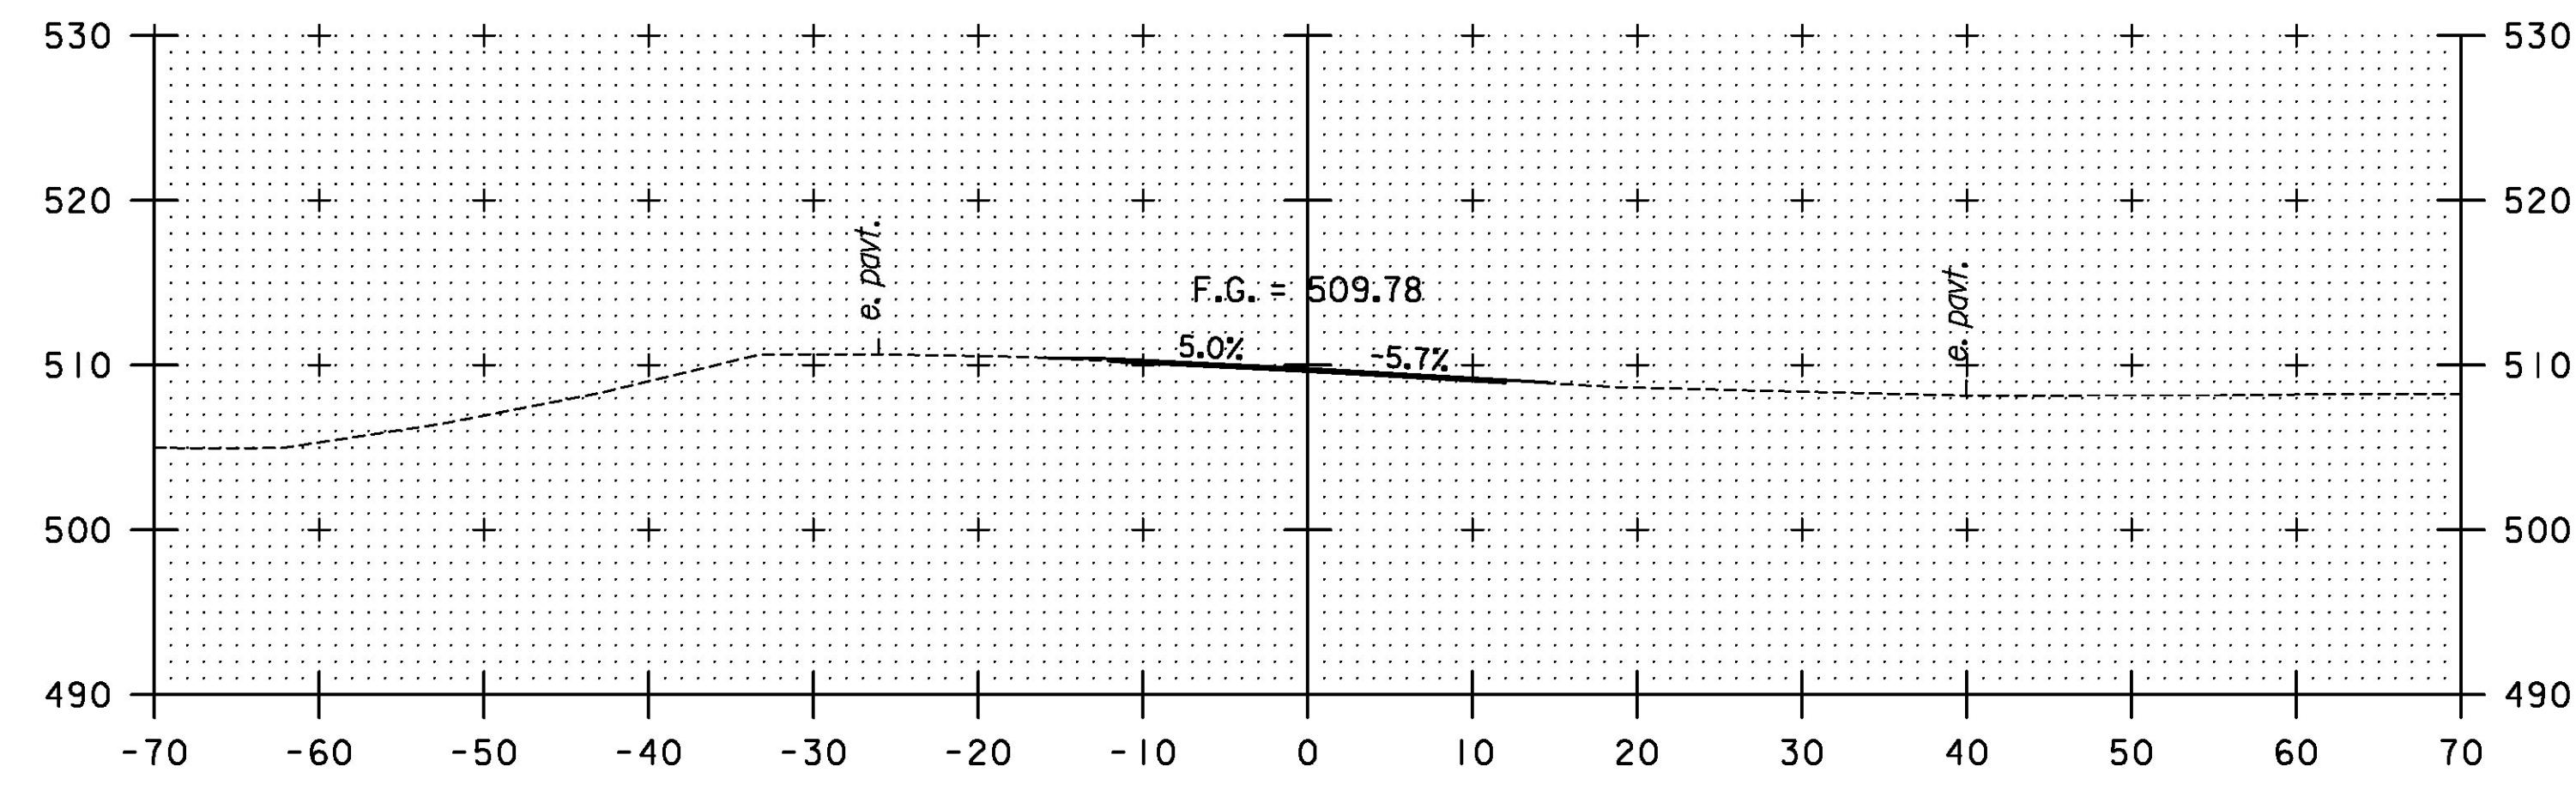

58+00

STA. 57+25 TO STA. 58+50

TYLINTERNATIONAL

PROJECT NAME:	DUXBURY
PROJECT NUMBER:	BF 013-4(47)
FILE NAME:	z16b001trdwy_xs.dgn
PROJECT LEADER:	J. OLUND
DESIGNED BY:	T. KELLEY
TEMPORARY ROADWAY CROSS SECTIONS	6
PLOT DATE:	5/23/2016
DRAWN BY:	T. KELLEY
CHECKED BY:	J. HOWE
SHEET	26 OF 69