



4 INCH YELLOW LINE (4" YL)  
 STA 298+75.08 - 298+75.08 RT (18' EA) (DOUBLE CENTERLINE)  
 STA 299+05.00 - 299+60.00 (55' EA) (DOUBLE CENTERLINE)

4 INCH WHITE LINE (4" WL)  
 STA 298+87.75, RT - 298+87.75, RT (16')  
 STA 299+02.54, LT - 299+60.00, LT (78')  
 STA 299+07.66, RT - 299+60.00, RT (63')

REMOVING SIGNS  
 STA 295+73 RT (1 SIGN)  
 24 INCH STOP BAR  
 STA 298+75.59 RT - 299+22.78 RT (46.06 FT)  
 LETTER OR SYMBOL  
 STA 298+81.43, RT (STOP)  
 STA 298+99.05, RT (STOP)

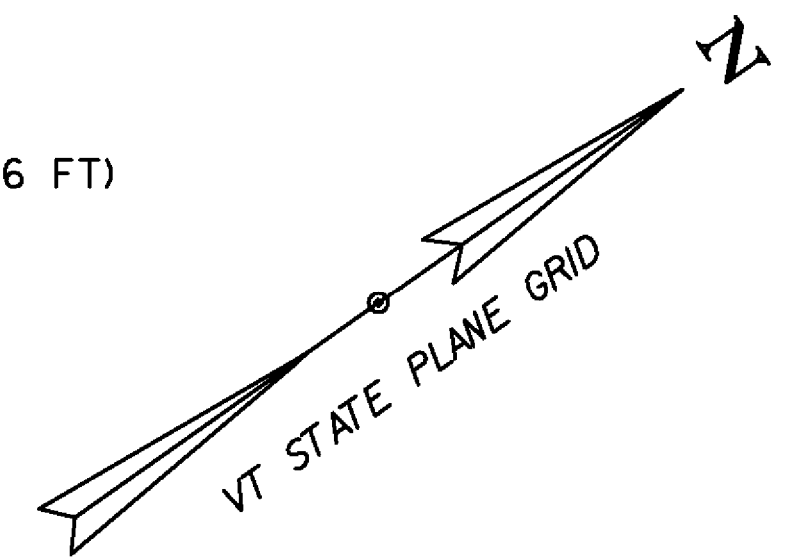

SIGNING LEGEND	
N	- NEW
R	- REMOVE
RET	- RETAIN
R&S	- REMOVE AND SALVAGE
S	- ERECT SALVAGED SIGN OR SUPPORT
	EXISTING ASSEMBLY
	PROPOSED ASSEMBLY

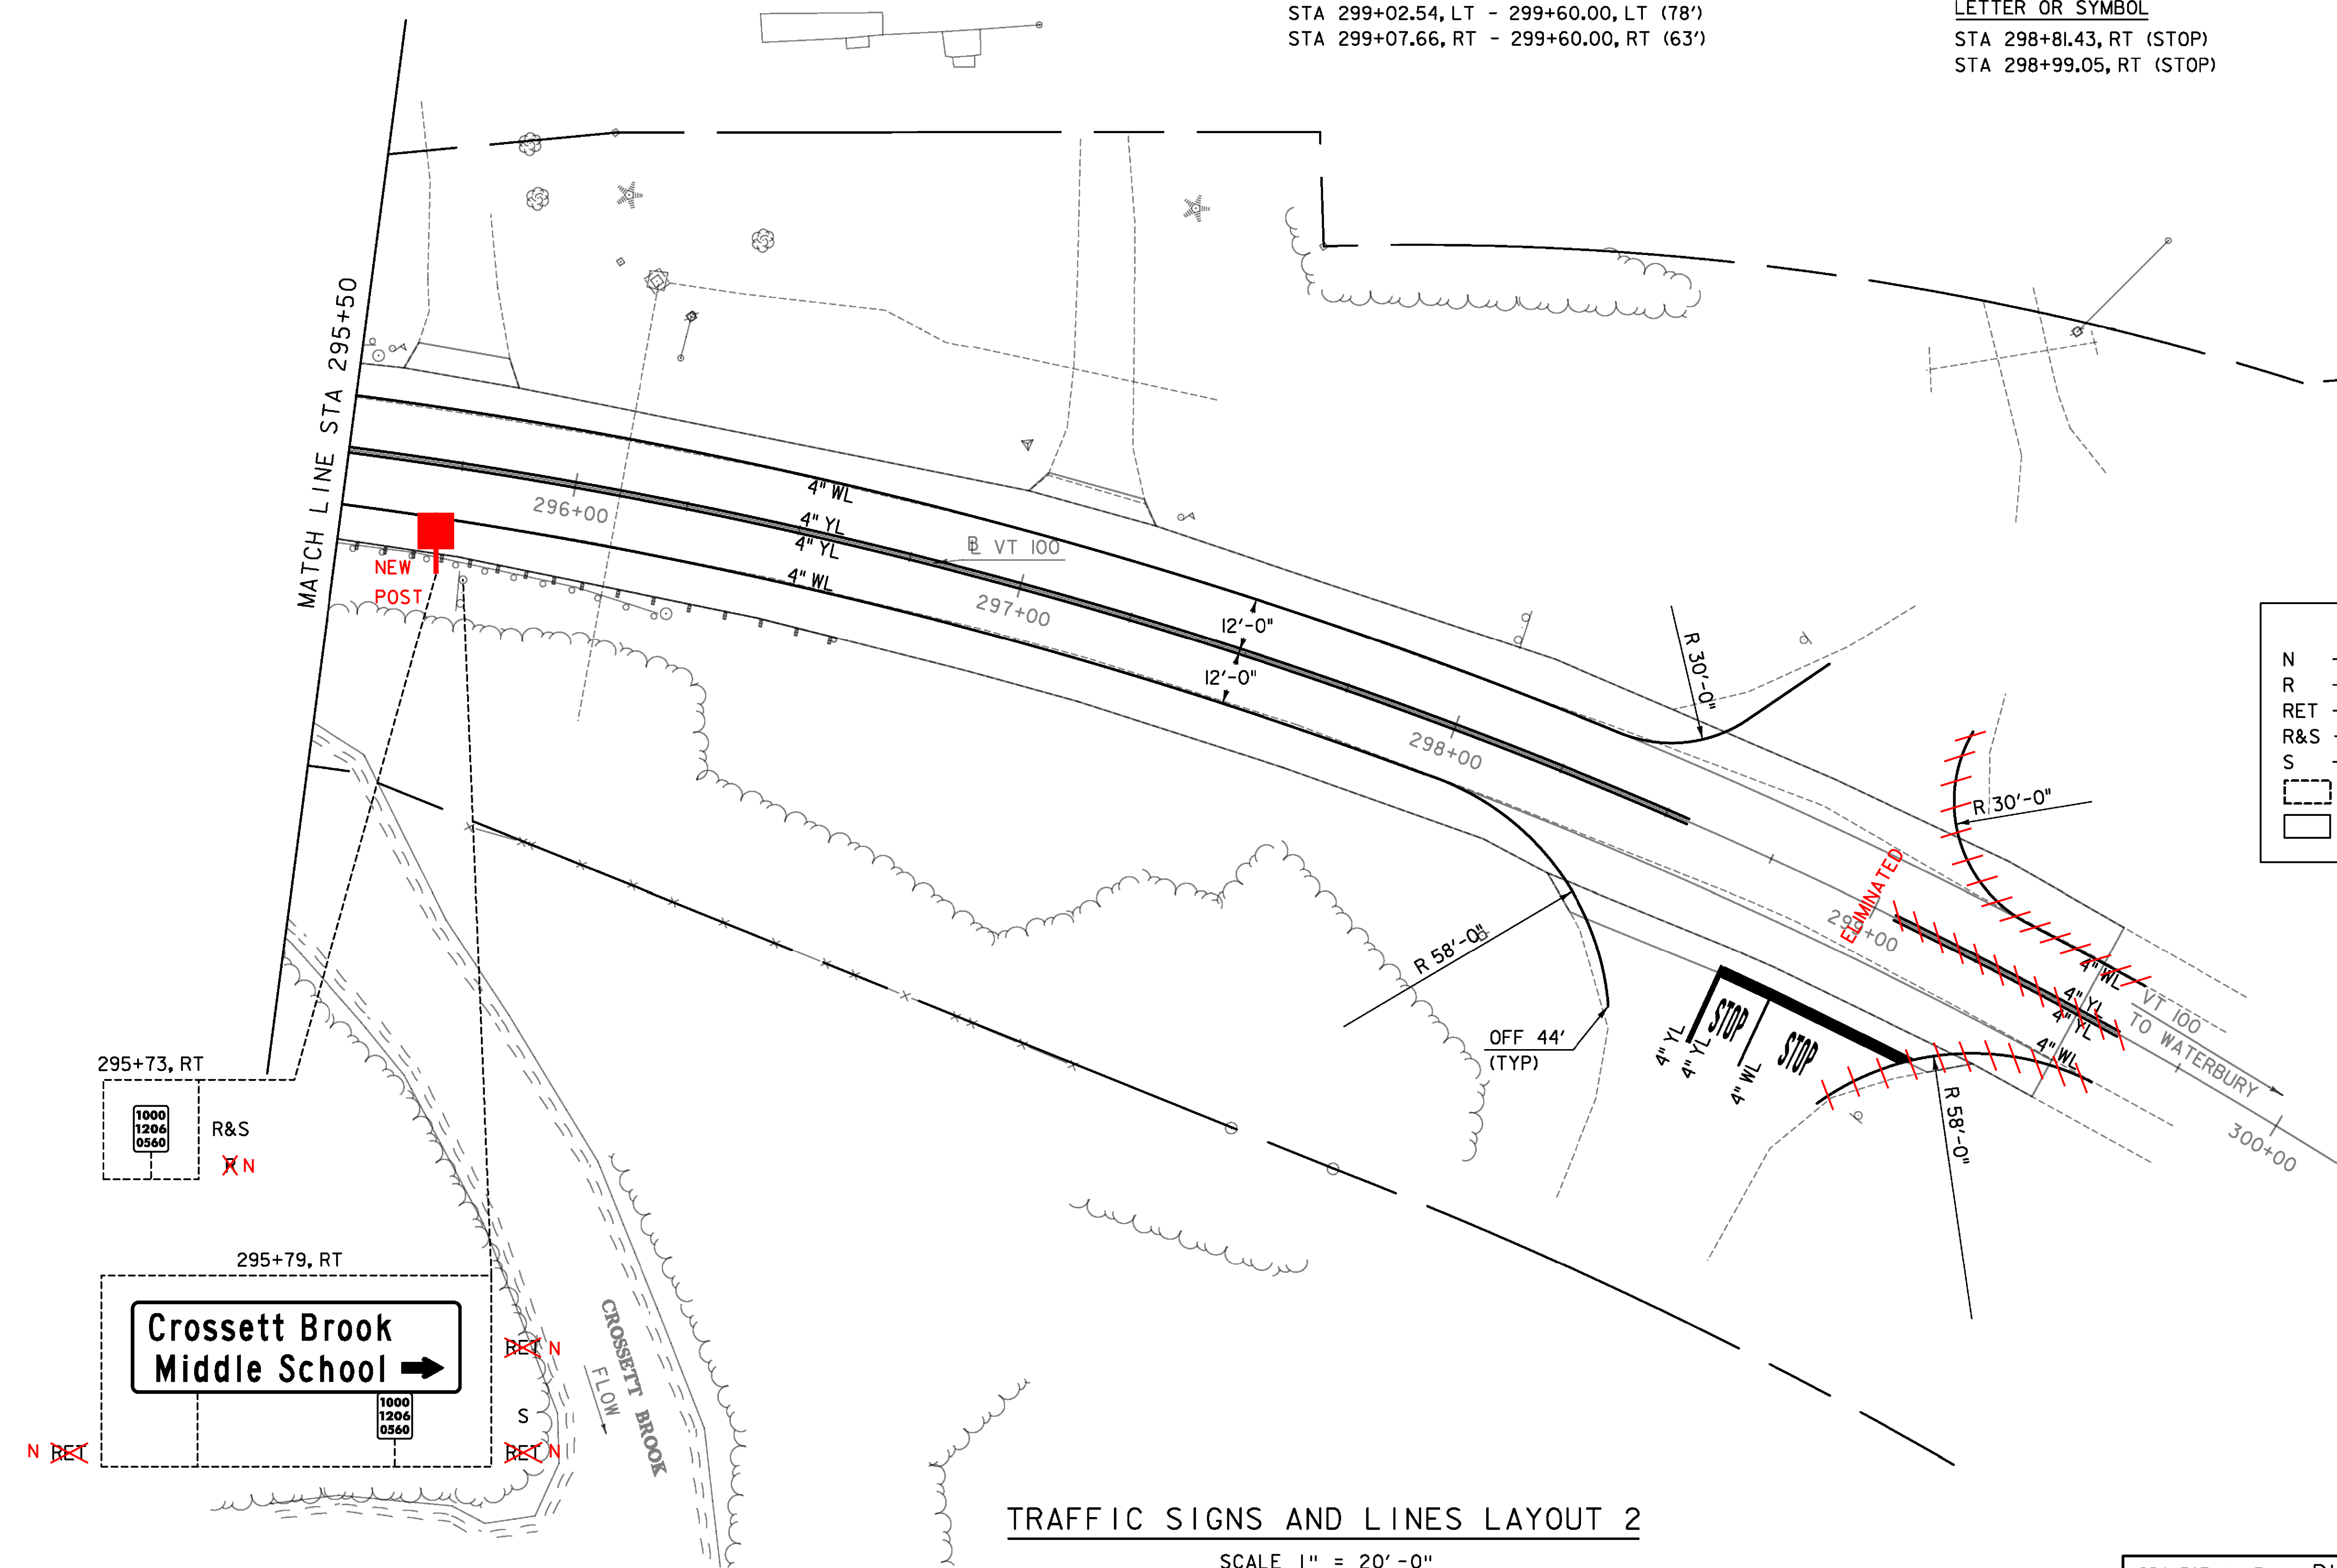

TRAFFIC SIGNS AND LINES LAYOUT 2

SCALE 1" = 20'-0"  
 20 0 20



PROJECT NAME: DUXBURY	PLOT DATE: 5/23/2016
PROJECT NUMBER: BF 013-4(47)	DRAWN BY: S. MORGAN
FILE NAME: z16b00ts.dgn	CHECKED BY: K. DUCHARME
PROJECT LEADER: J. OLUND	TRAFFIC SIGNS AND LINES LAYOUT SHEET 2 SHEET 34 OF 69
DESIGNED BY: B. TOOTHAKER	