


PLAN
SCALE: 1" = 10'-0"

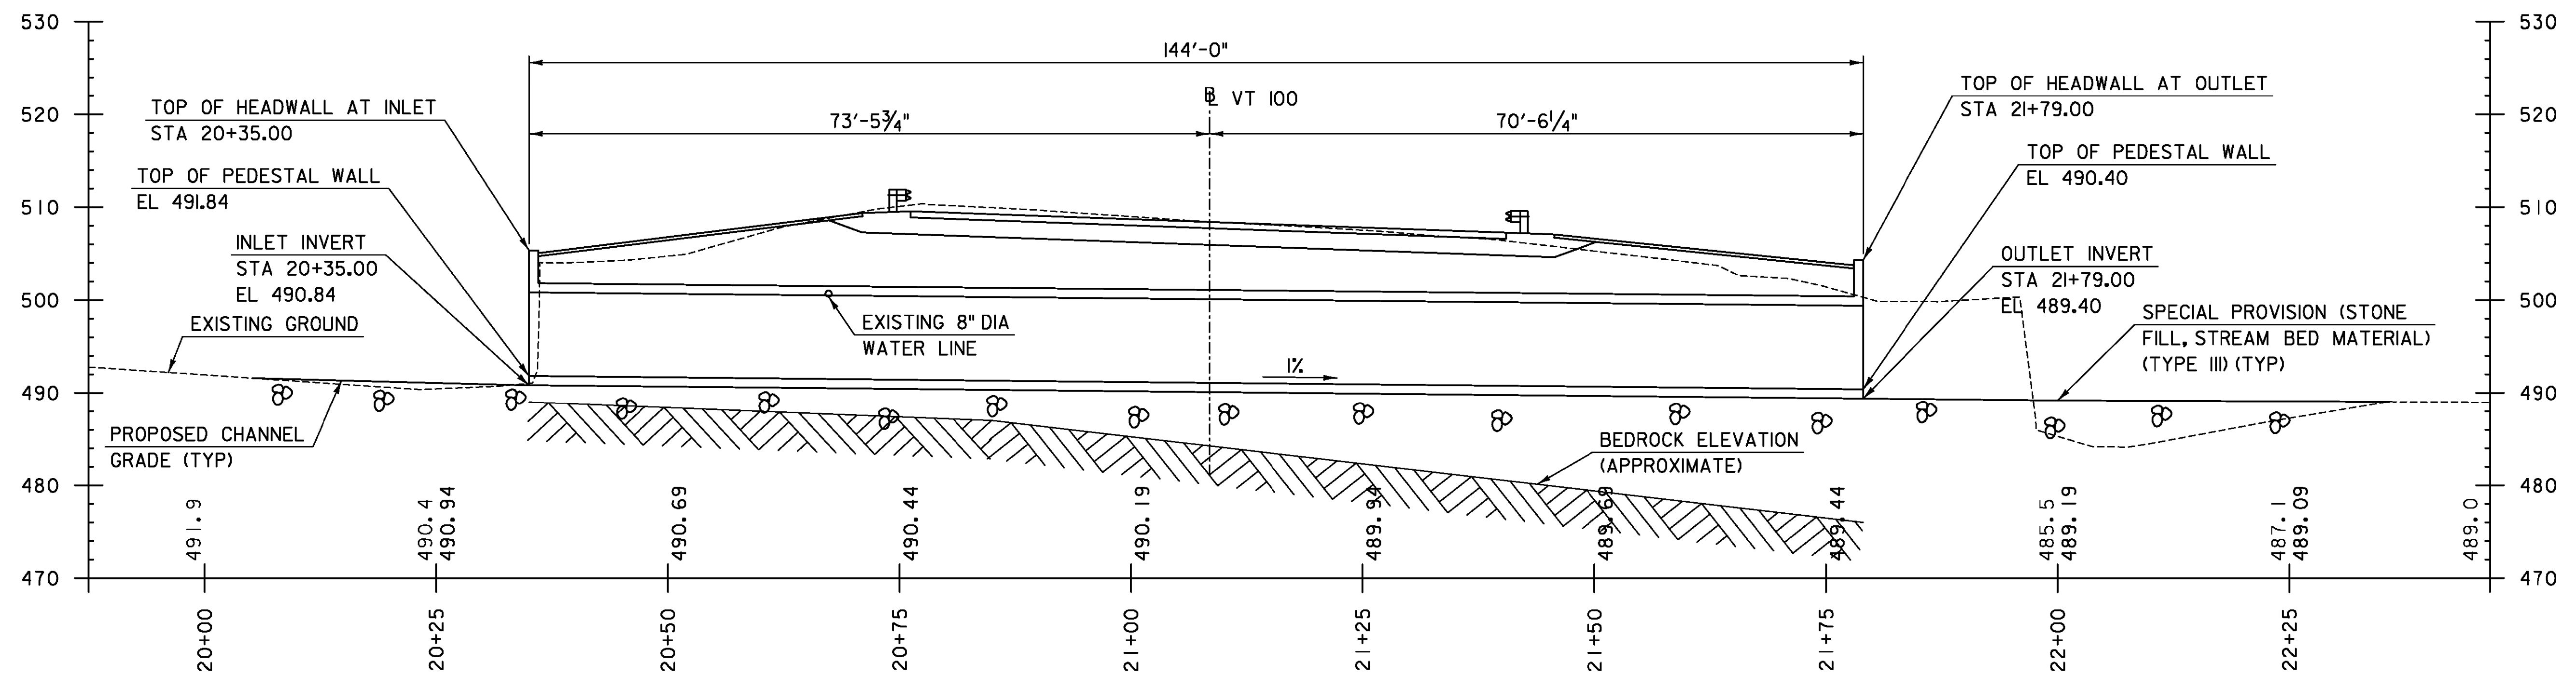

LONGITUDINAL SECTION ALONG CHANNEL LINE
SCALE: 1" = 10'-0"

NOTE:
GRADES SHOWN TO THE NEAREST TENTH ARE EXISTING CHANNEL GRADE ALONG ℓ .
GRADES SHOWN TO THE NEAREST HUNDREDTH ARE FINISH CHANNEL GRADE ALONG ℓ .

SCALE 1" = 10'-0"
10 0 10

TYLINT INTERNATIONAL

PROJECT NAME: DUXBURY
PROJECT NUMBER: BF 013-4(47)
FILE NAME: z16b00\pe.dgn
PROJECT LEADER: J. OLUND
DESIGNED BY: D. MYERS
PLAN AND ELEVATION

PLOT DATE: 5/23/2016
DRAWN BY: S. MORGAN
CHECKED BY: J. OLUND
SHEET 41 OF 69