


ABUTMENT NO 1 ELEVATION
(LOOKING UPSTATION)
SCALE 1/8" = 1'-0"

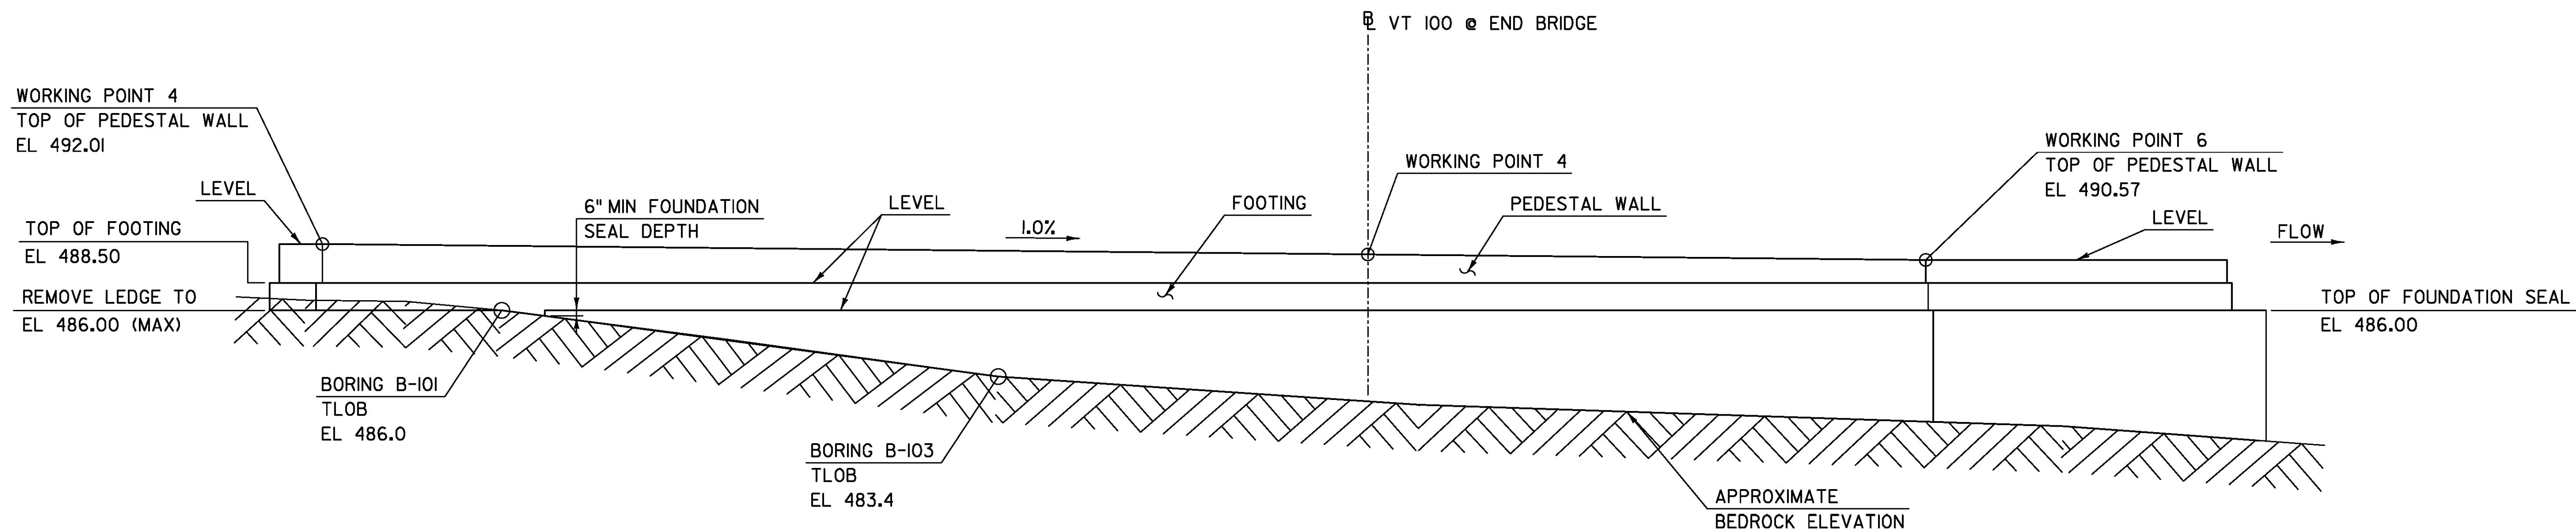

ABUTMENT NO 2 ELEVATION
(LOOKING UPSTATION)
SCALE 1/8" = 1'-0"

NOTE:
FOUNDATION SEAL MAY BE OMITTED WHERE
LEDGE ELEVATION EXCEEDS 485.5.

TYLIN INTERNATIONAL	PROJECT NAME: DUXBURY	PLOT DATE: 5/23/2016
	PROJECT NUMBER: BF 013-4(47)	DRAWN BY: S. MORGAN
	FILE NAME: z16b001fndelev.dgn	CHECKED BY: B. TOOTHAKER
	DESIGNED BY: D. MYERS	FOUNDATION ELEVATIONS
		SHEET 44 OF 69