




293+00
BEGIN PROJECT

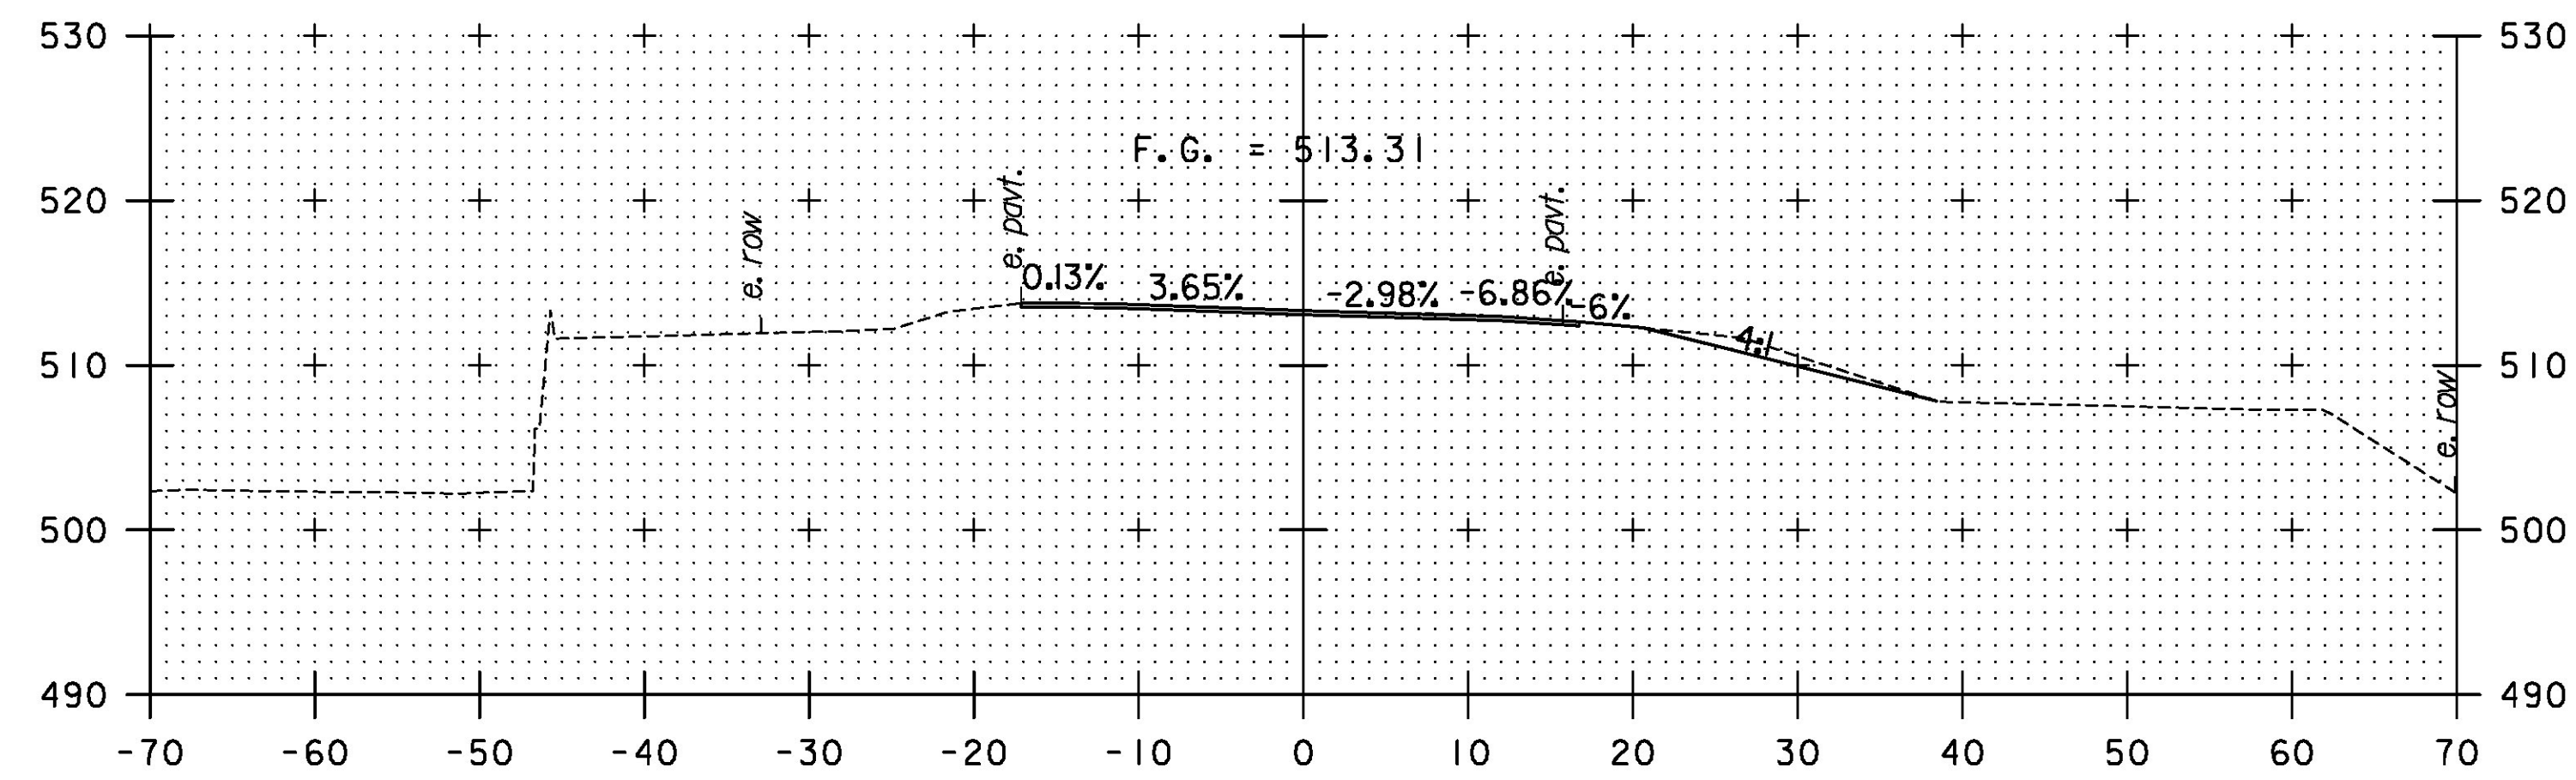


292+75

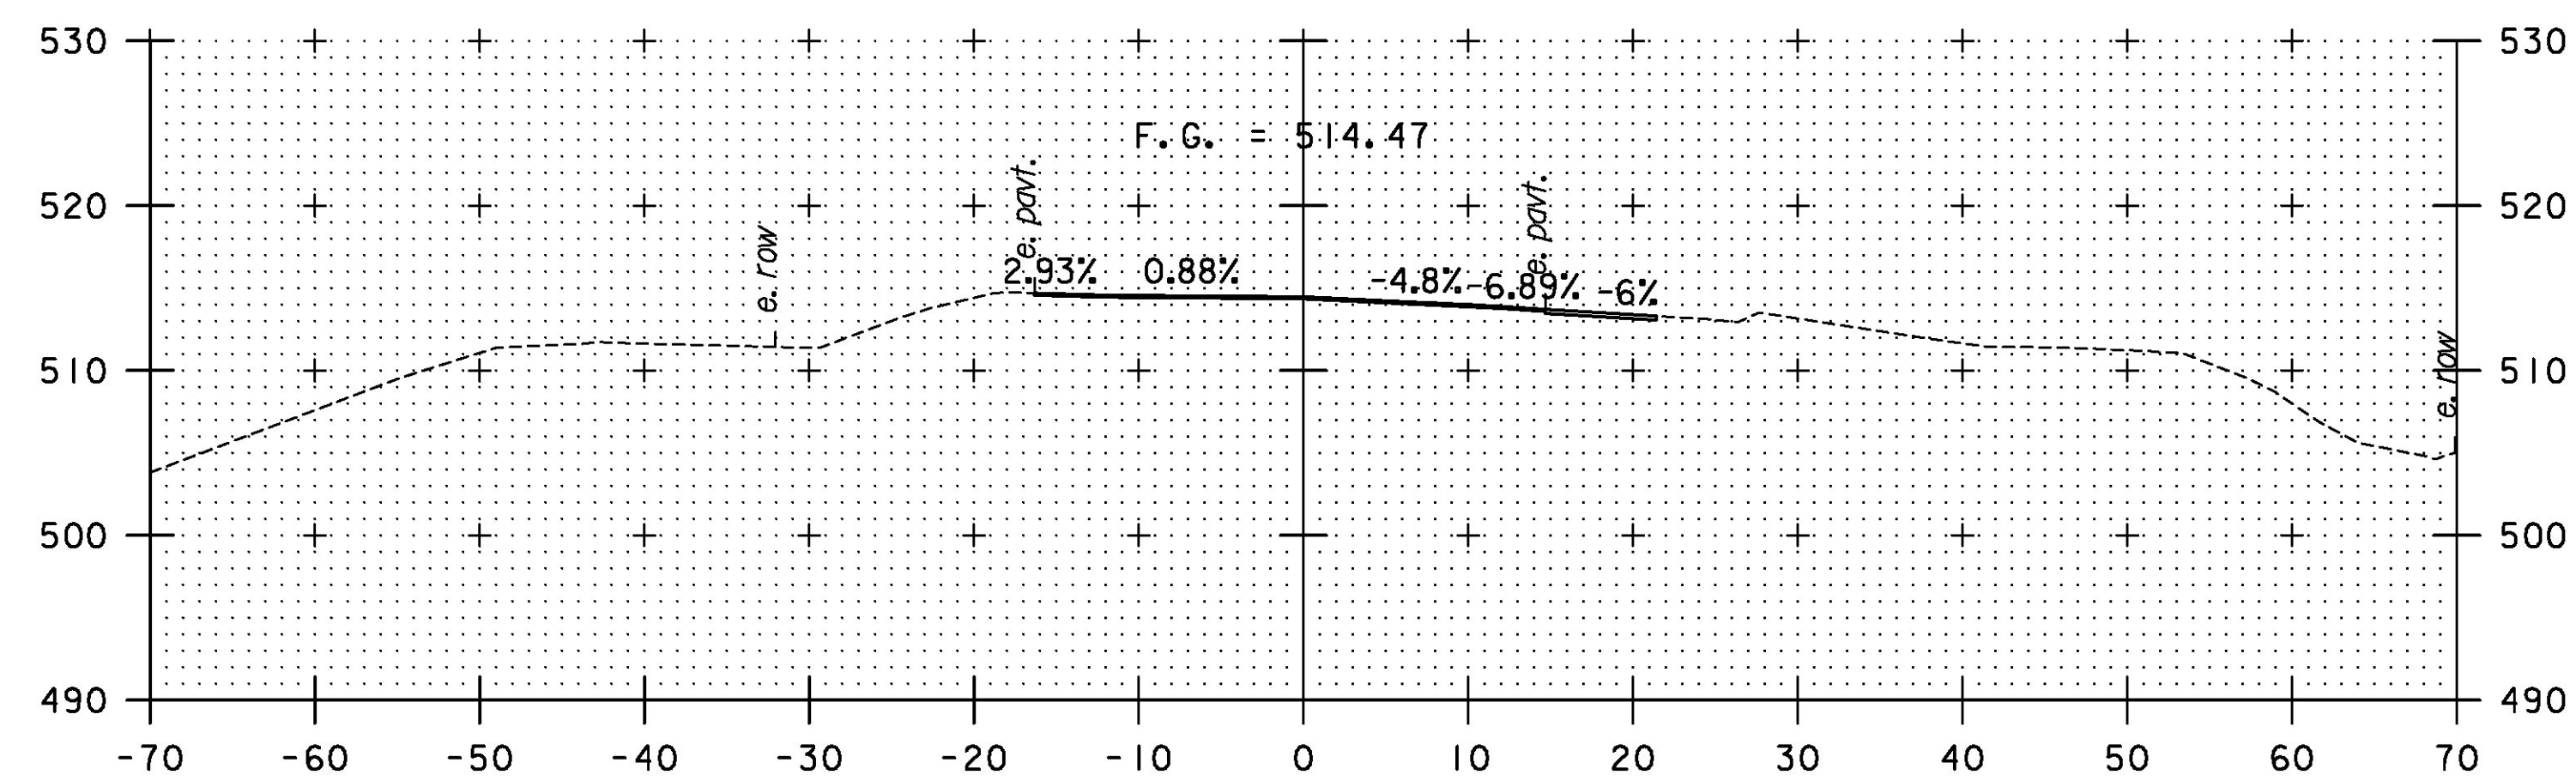

292+50

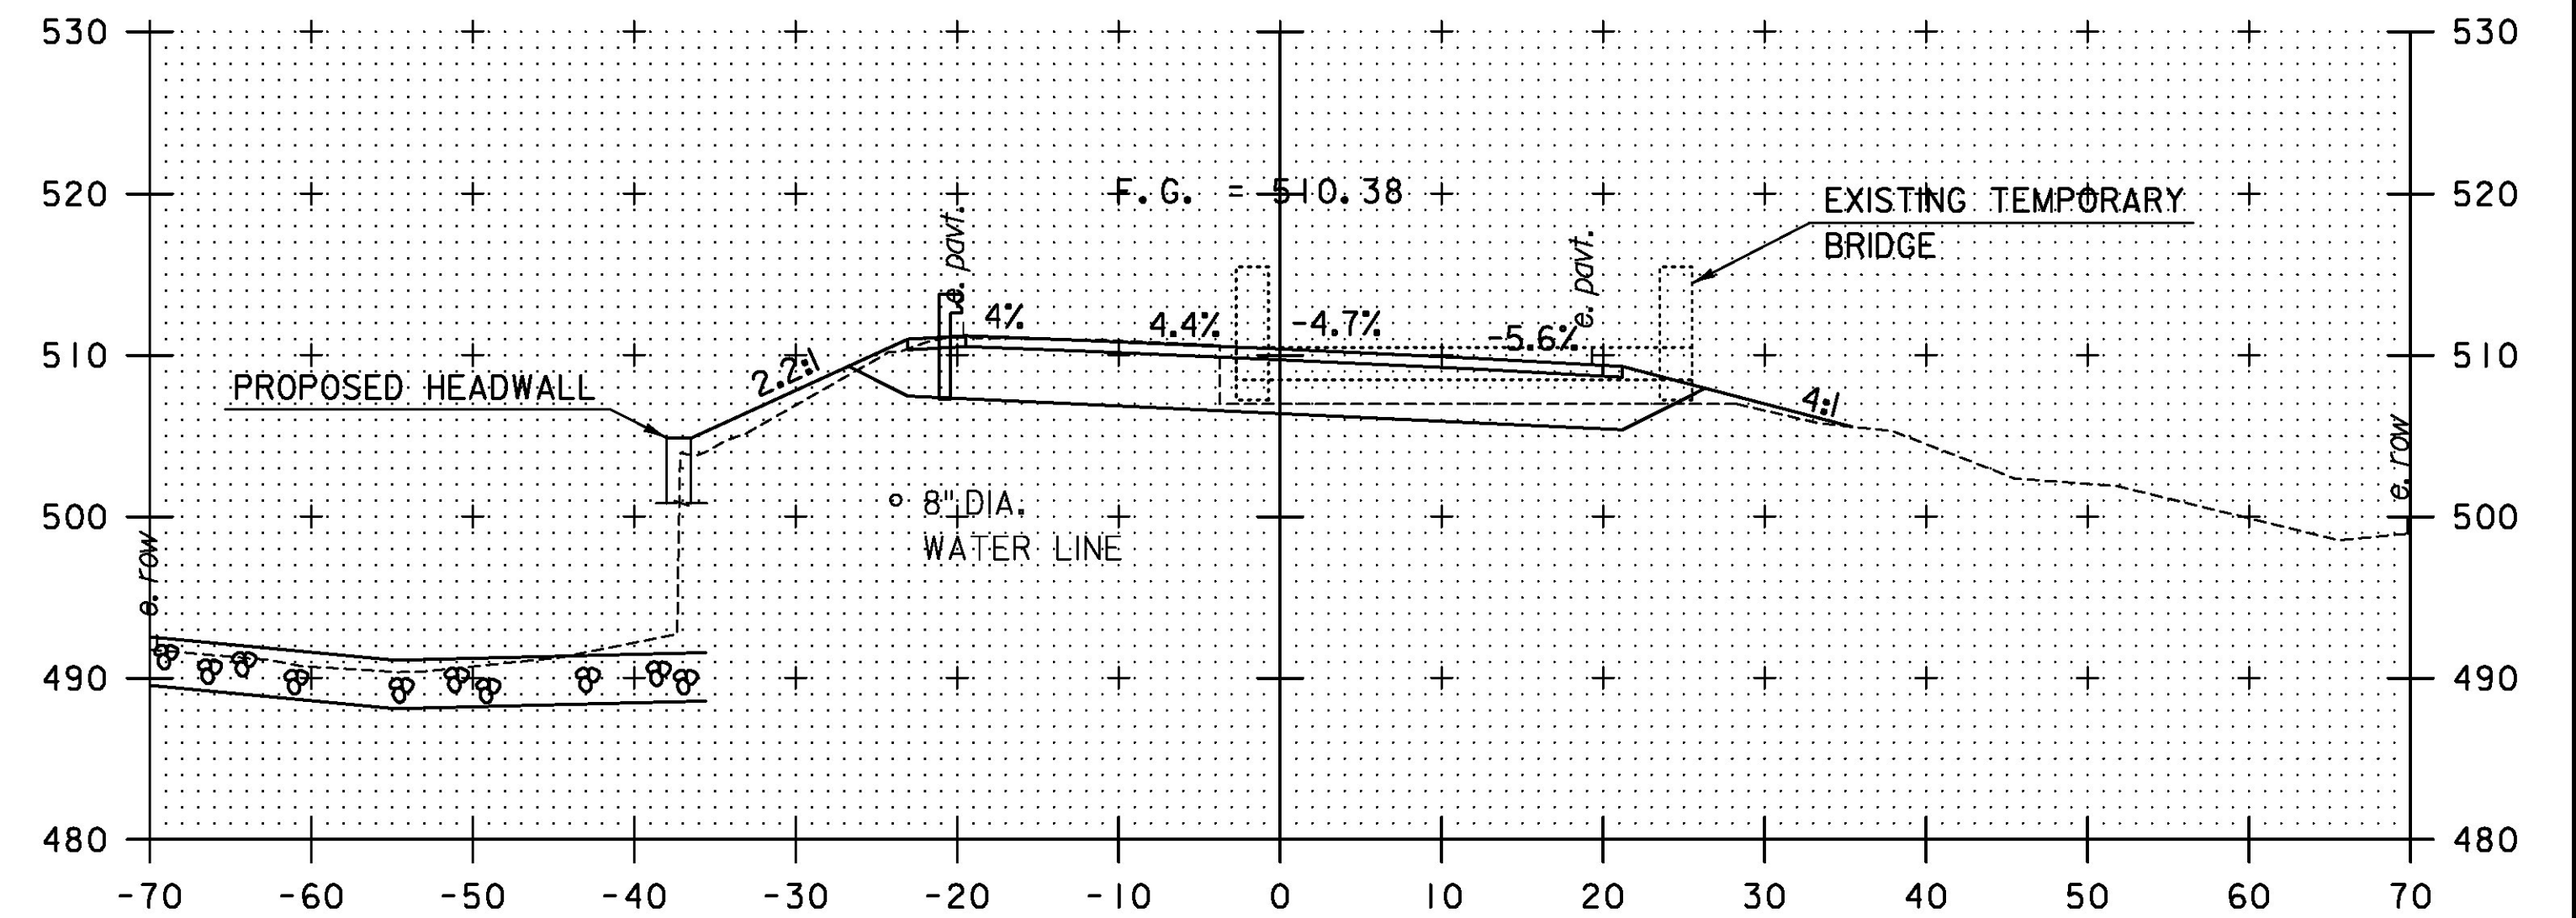

293+50

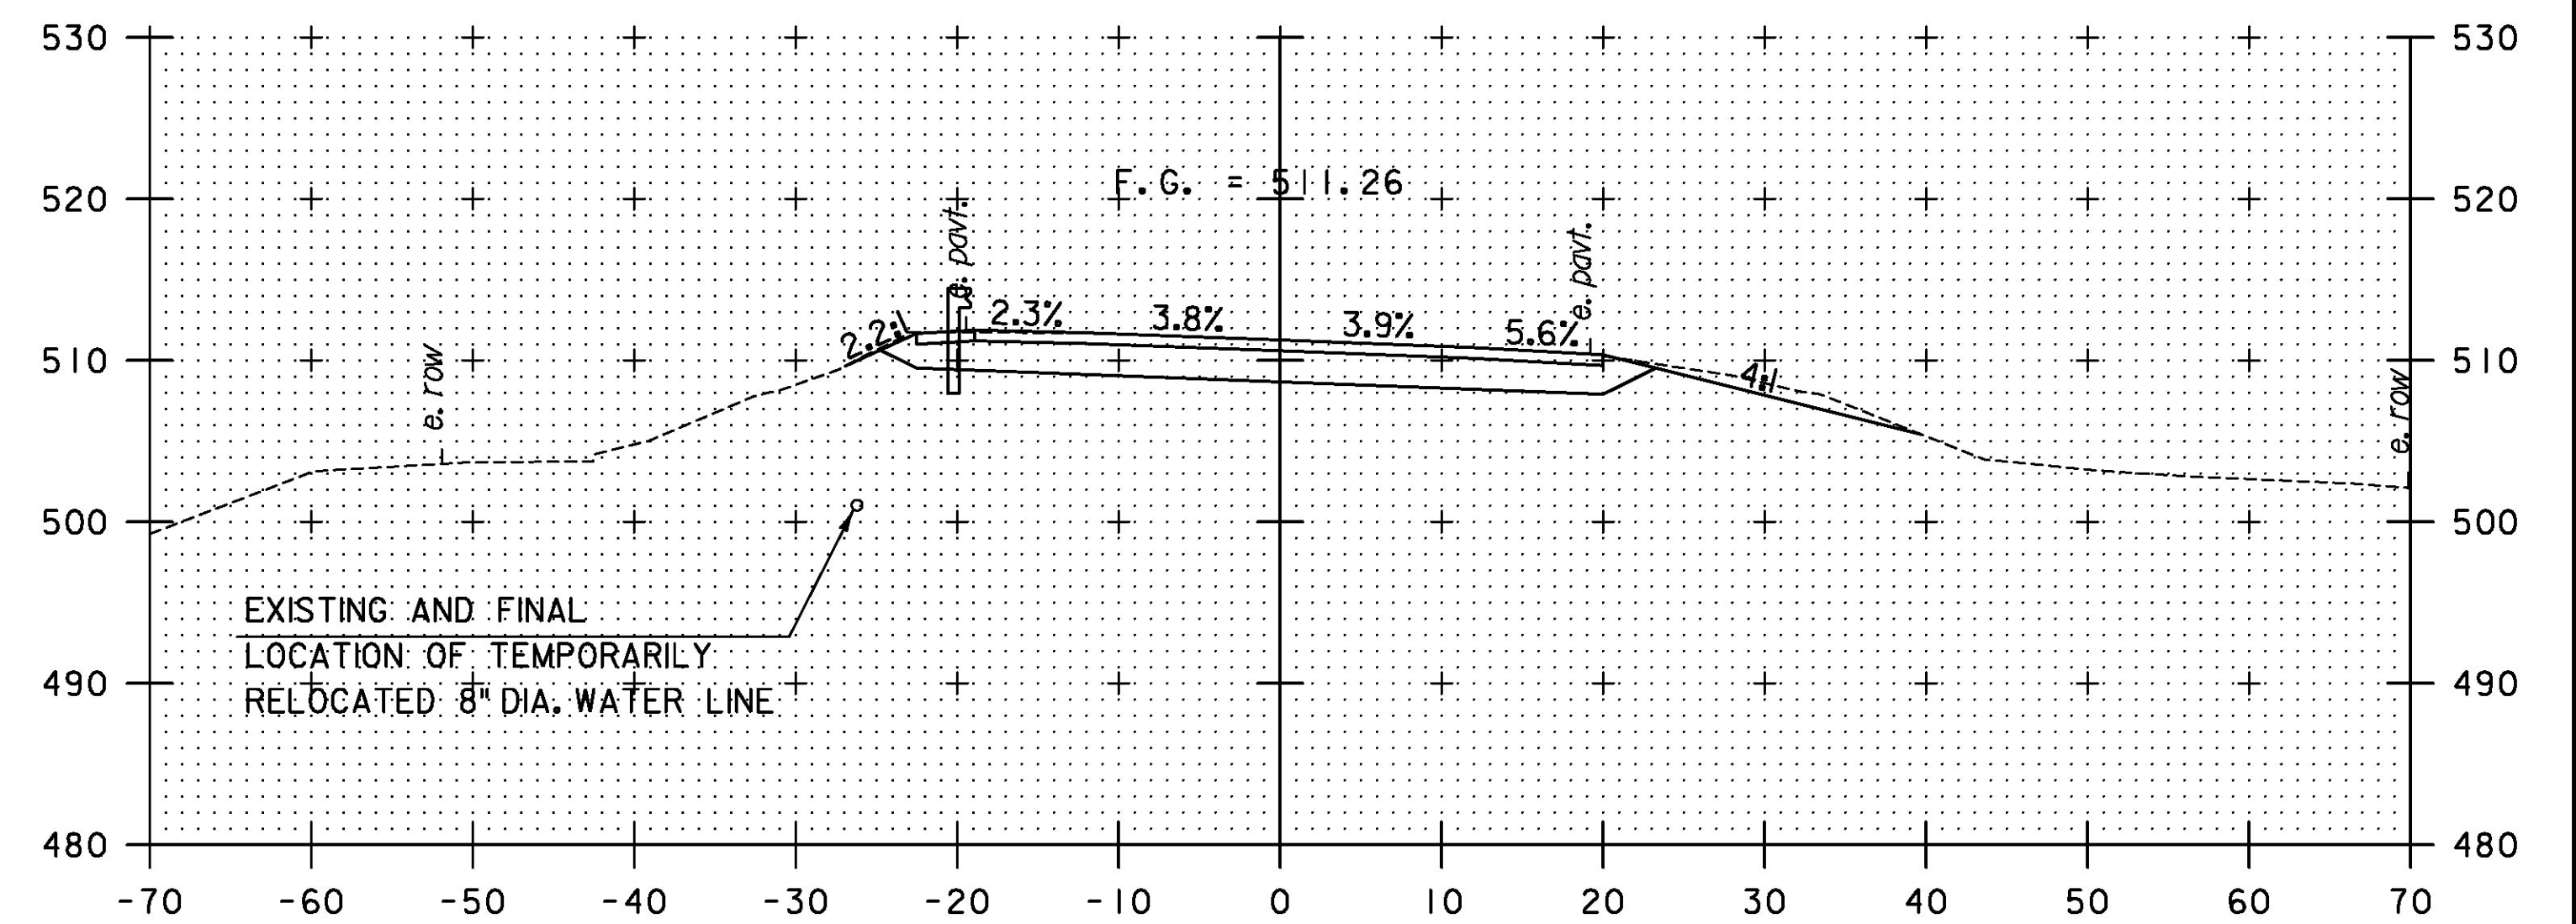

293+25

PROPOSED CULVERT NOT SHOWN.

STA. 292+50 TO STA. 293+50

TYLIN INTERNATIONAL

PROJECT NAME: DUXBURY
PROJECT NUMBER: BF 013-4(47)

FILE NAME: z16b001xs.dgn
PROJECT LEADER: J. OLUND
DESIGNED BY: J. HOWE
VT 100 CROSS SECTIONS 2

PLOT DATE: 5/23/2016
DRAWN BY: P. BRYANT
CHECKED BY: J. OLUND
SHEET 48 OF 69