




294+00
BEGIN BRIDGE 293+89.17

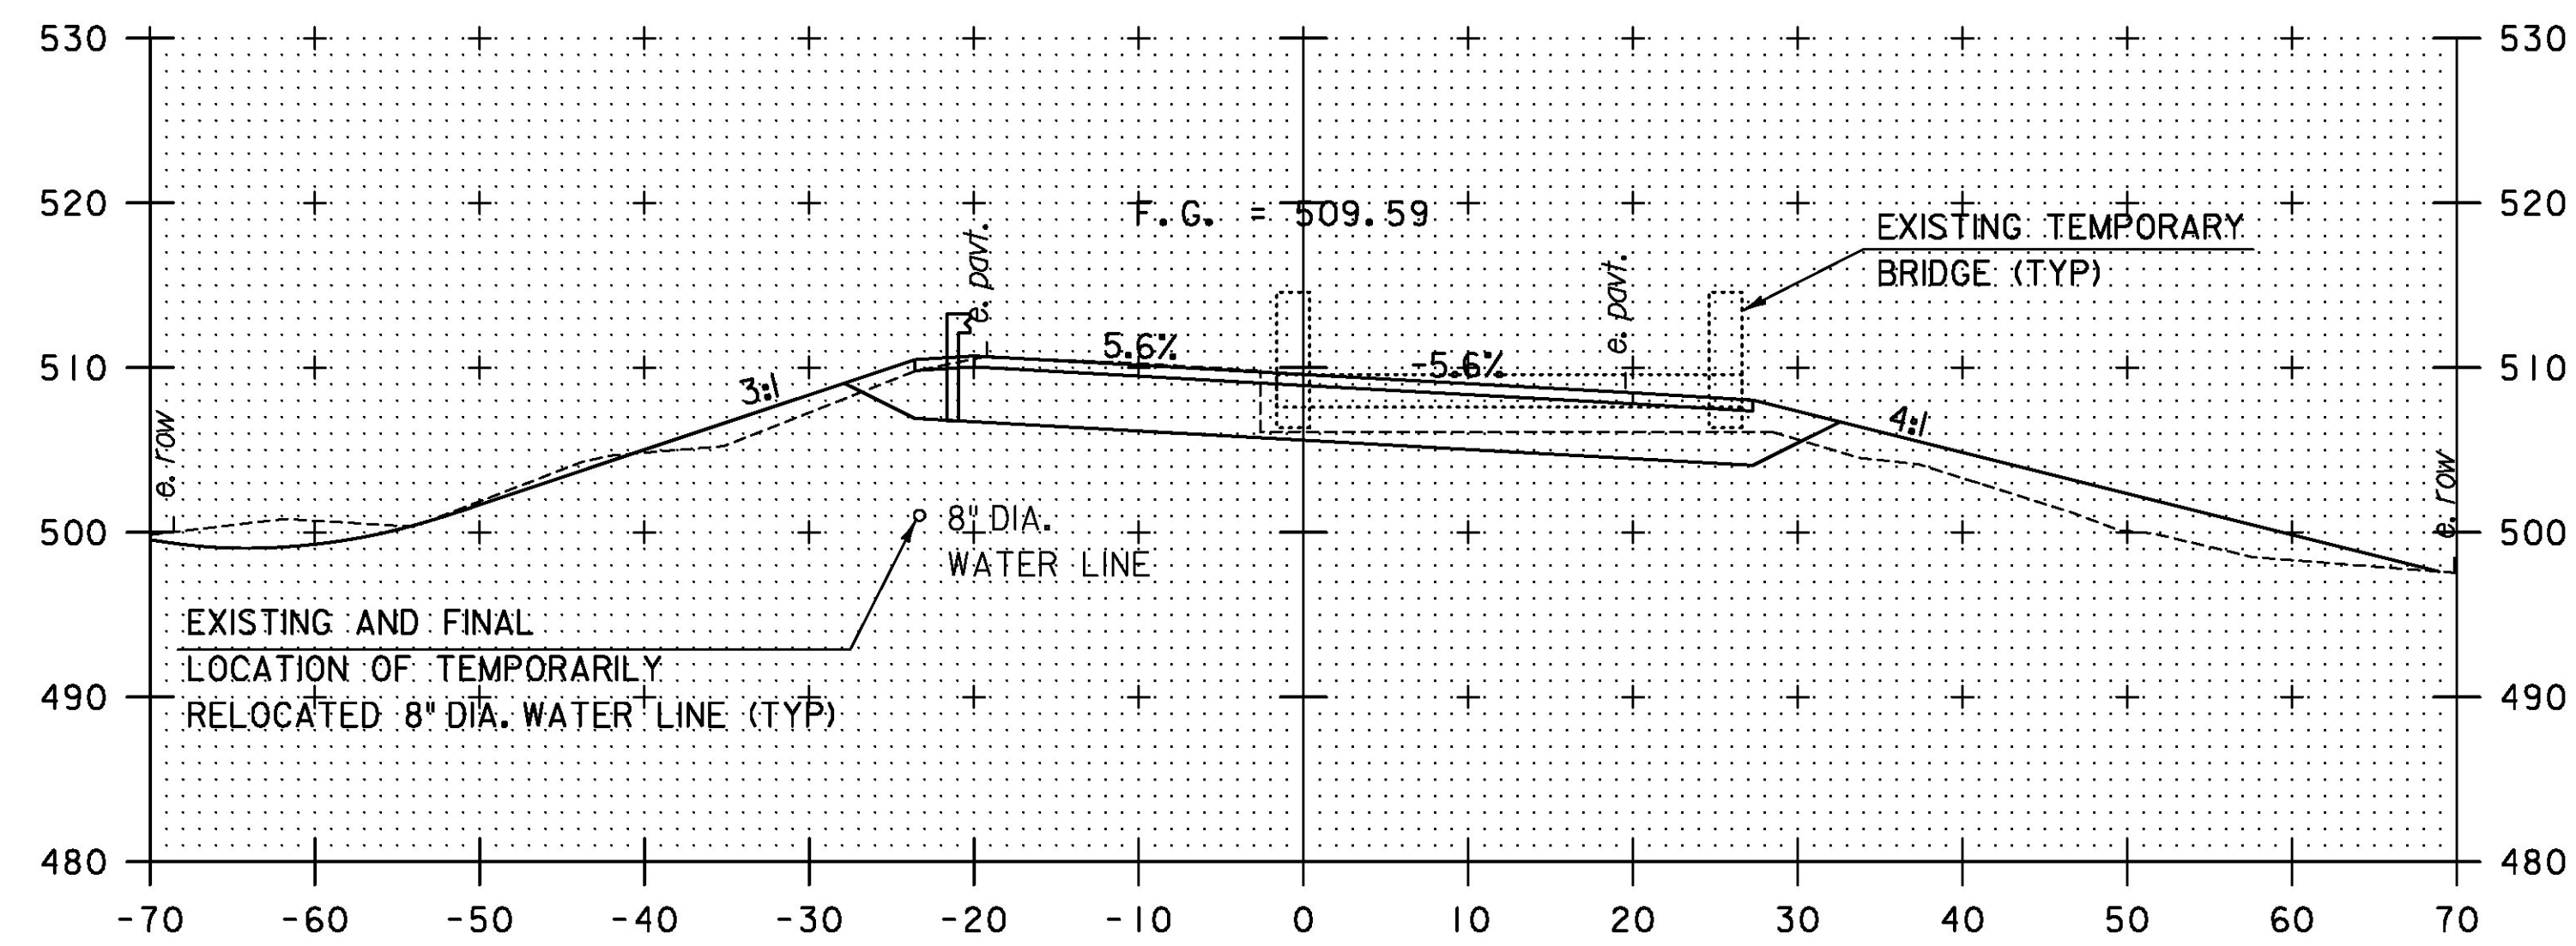


293+75

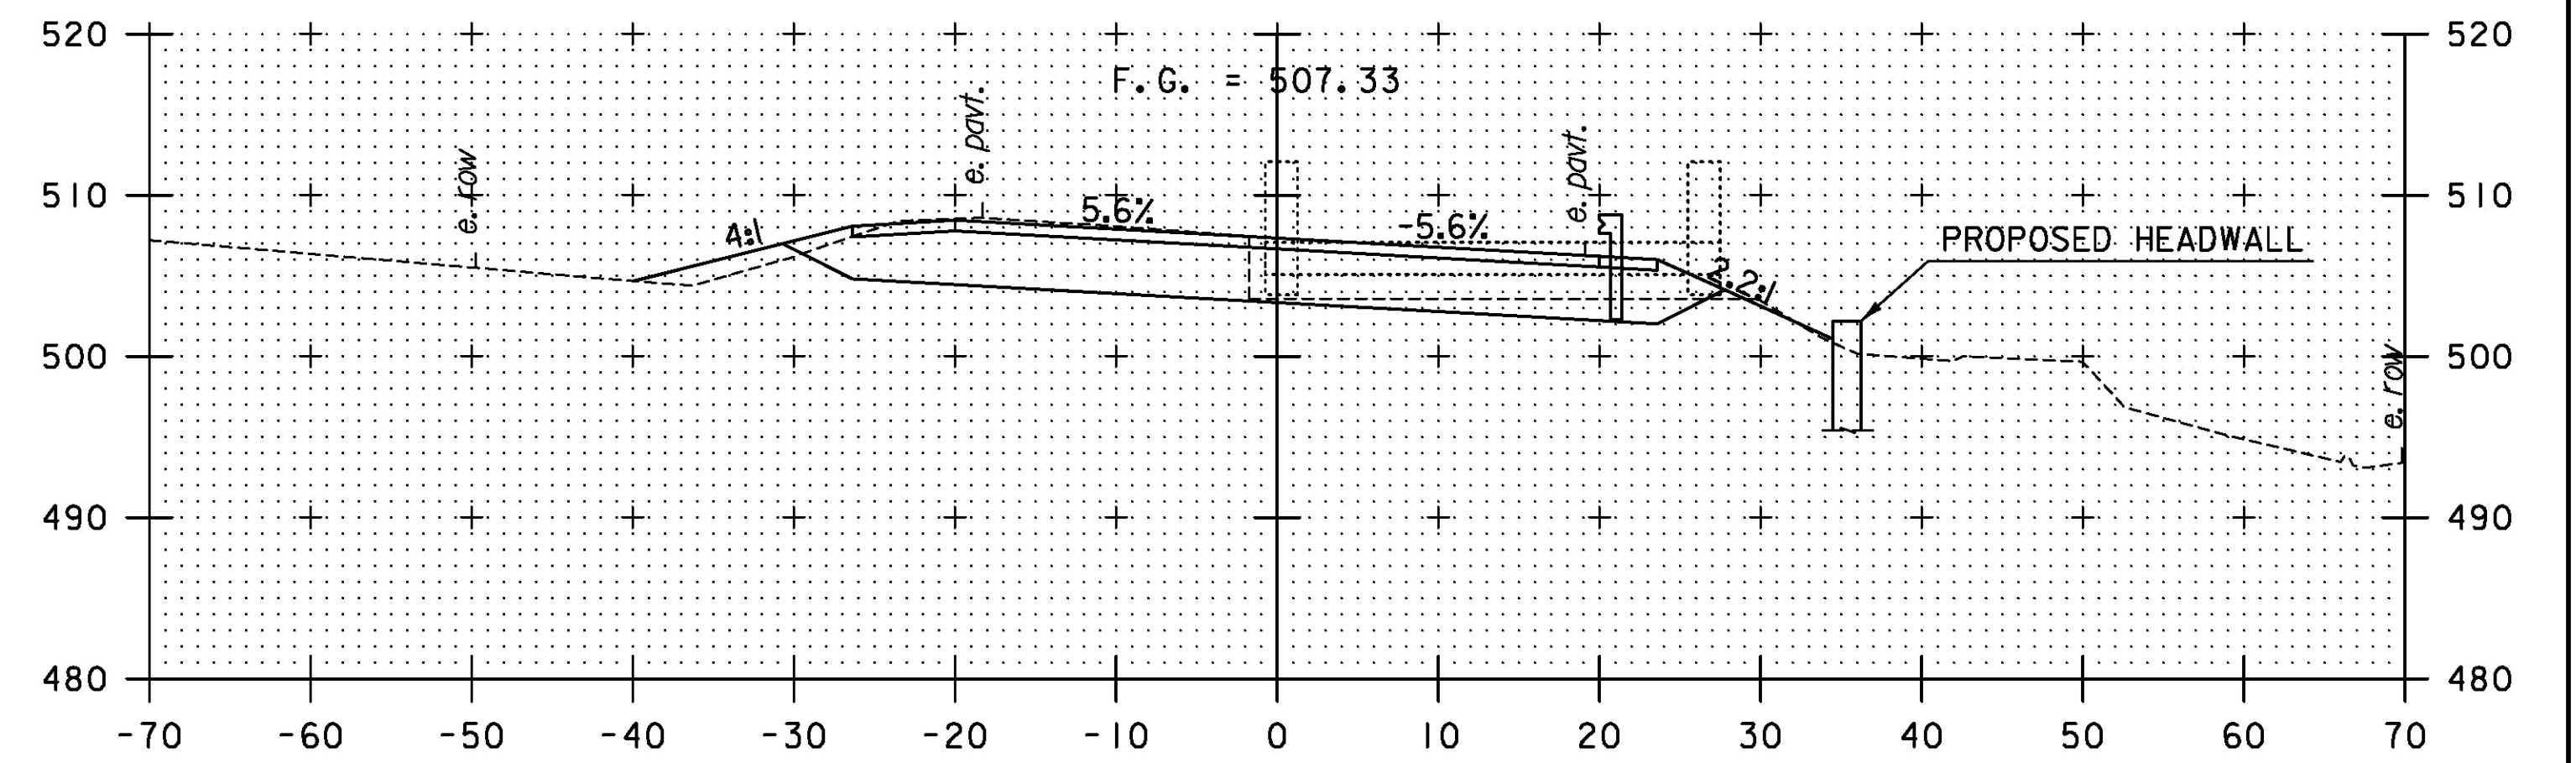

294+75

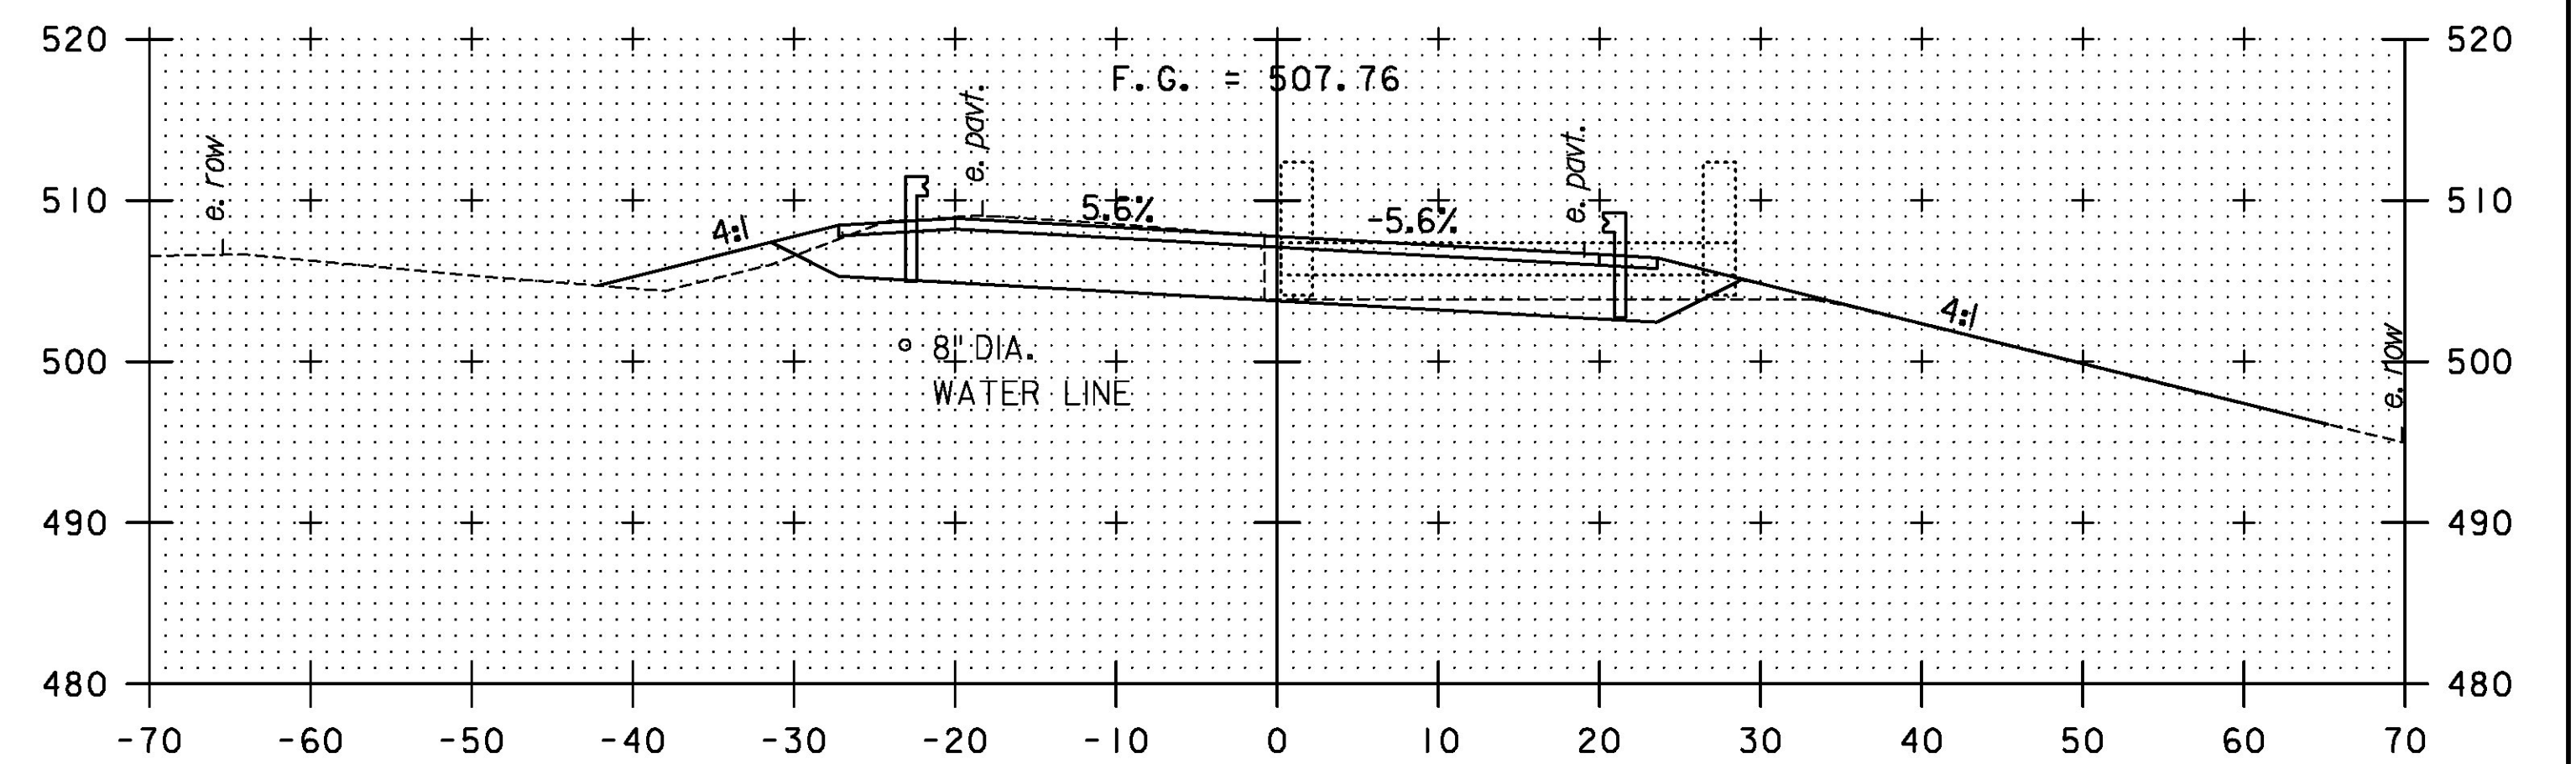

294+50
END BRIDGE 294+37.46

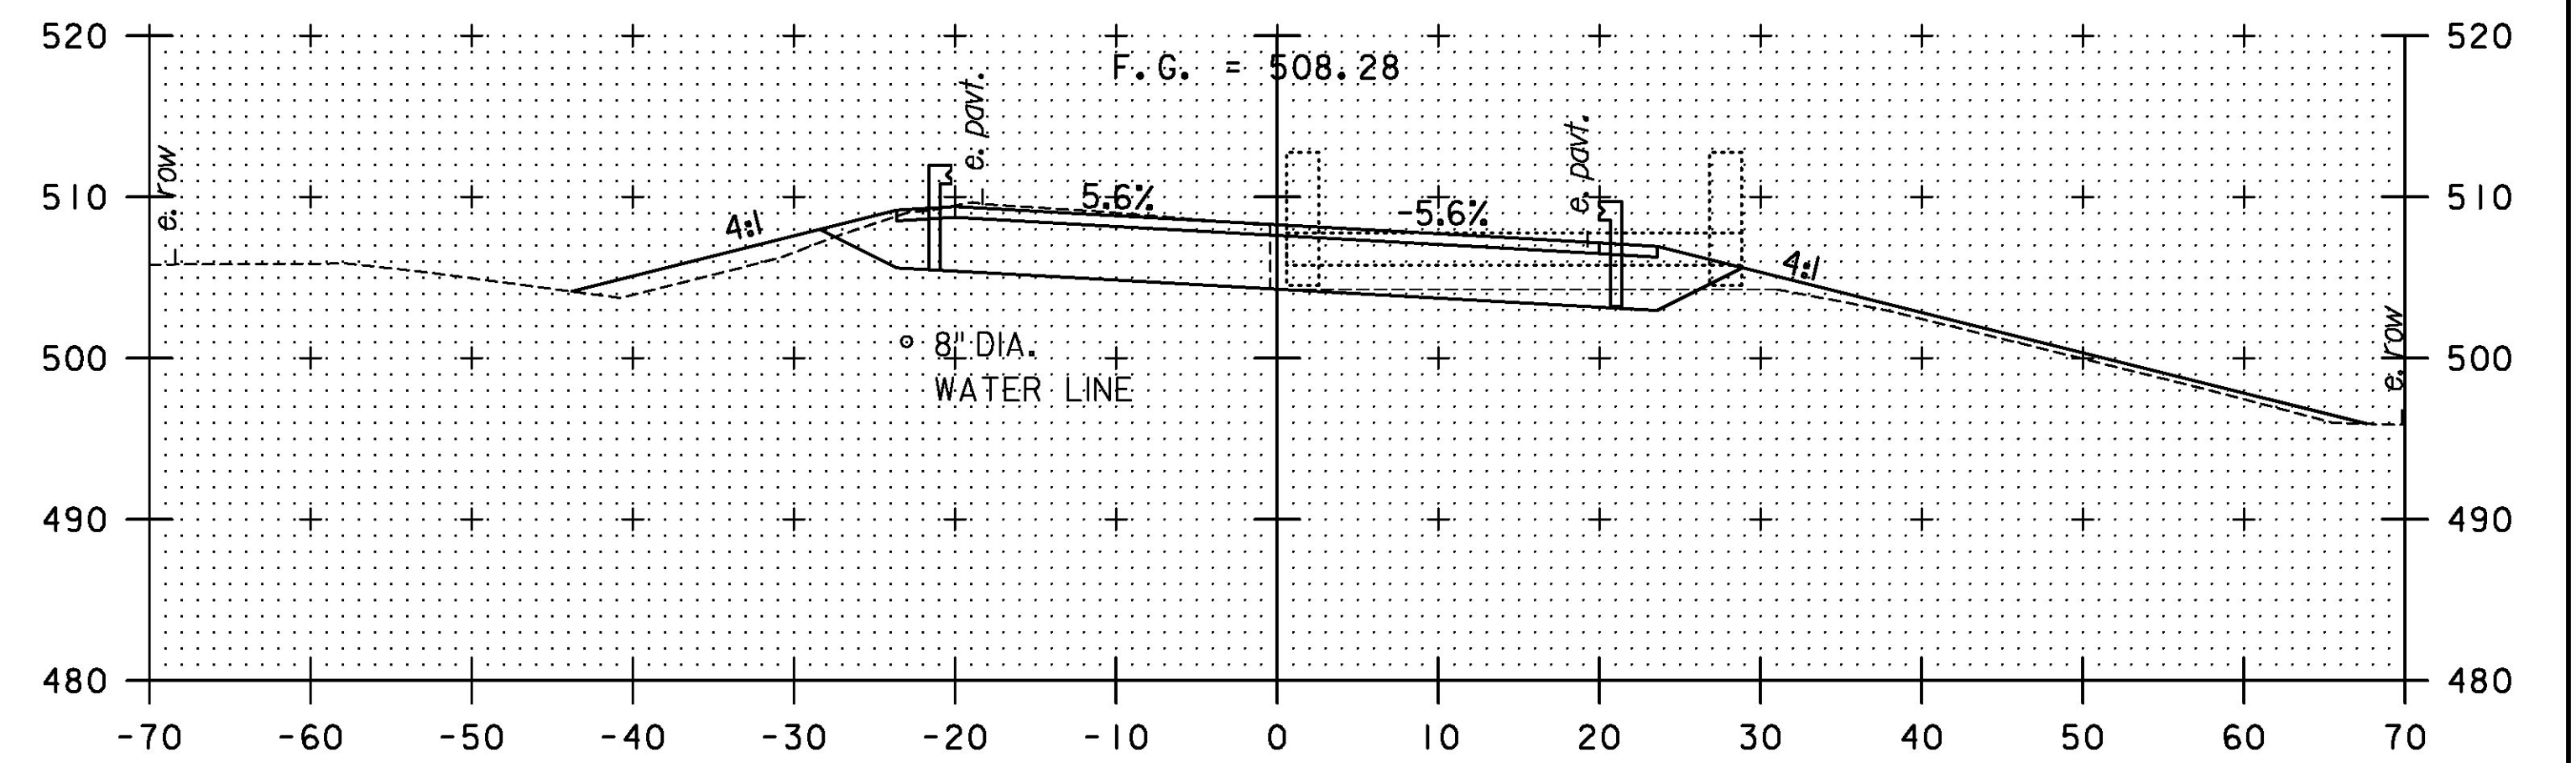

294+25

PROPOSED CULVERT NOT SHOWN.

STA. 293+75 TO STA. 294+75

TYLIN INTERNATIONAL

PROJECT NAME: DUXBURY
PROJECT NUMBER: BF 013-4(47)

FILE NAME: z16b001xs.dgn
PROJECT LEADER: J. OLUND
DESIGNED BY: J. HOWE
VT 100 CROSS SECTIONS 3

PLOT DATE: 5/23/2016
DRAWN BY: P. BRYANT
CHECKED BY: J. OLUND
SHEET 49 OF 69