




296+75

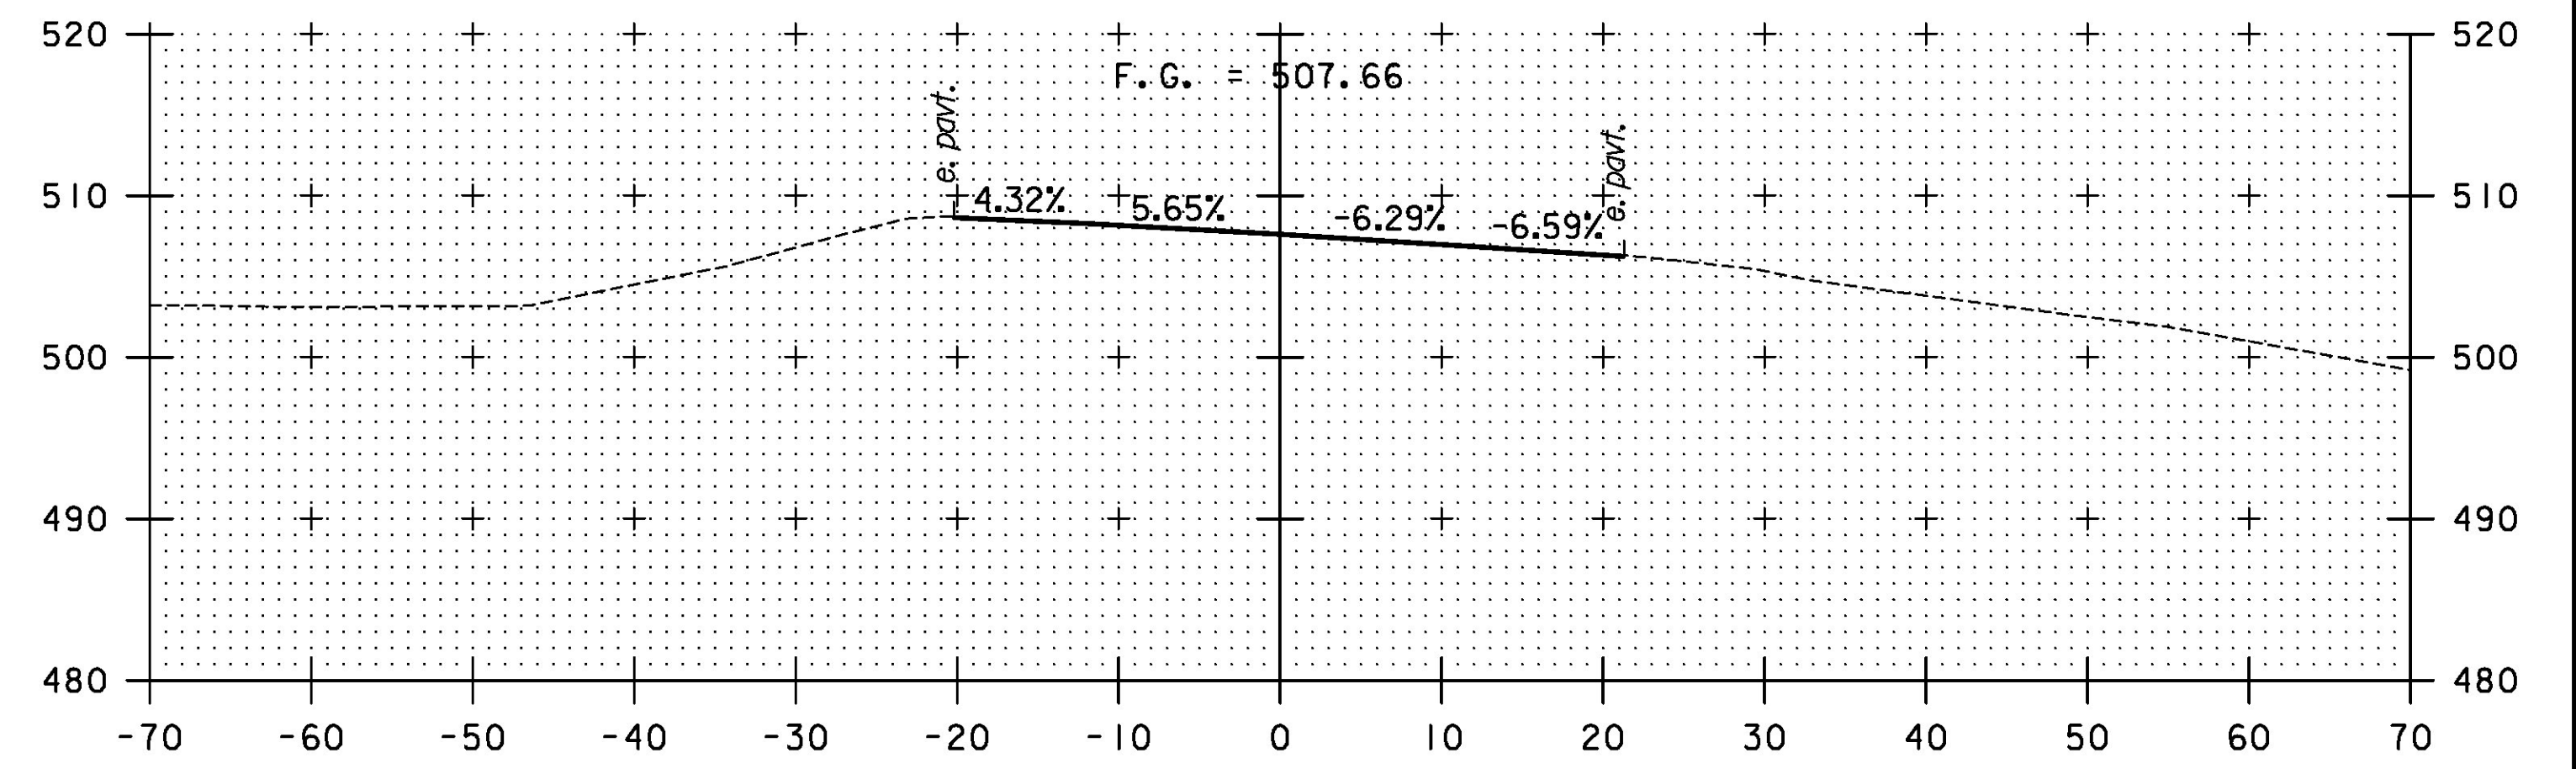


297+50

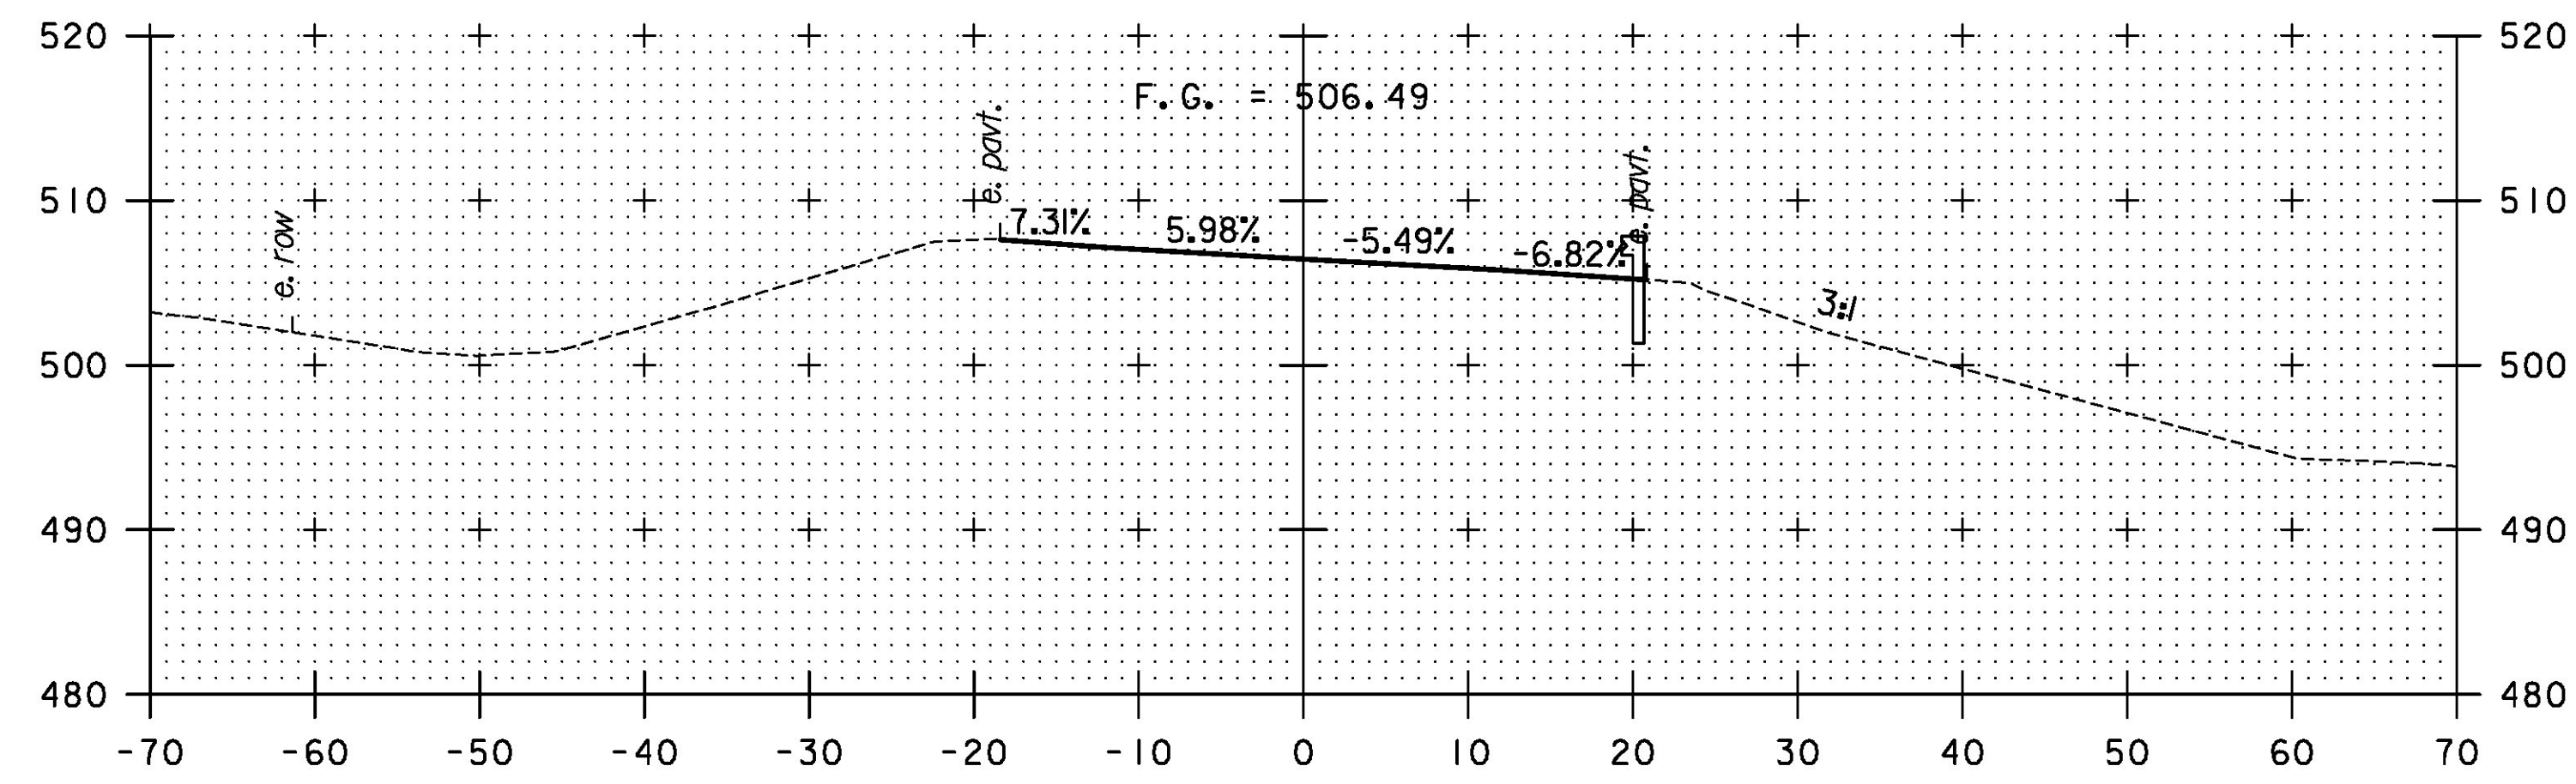


296+50

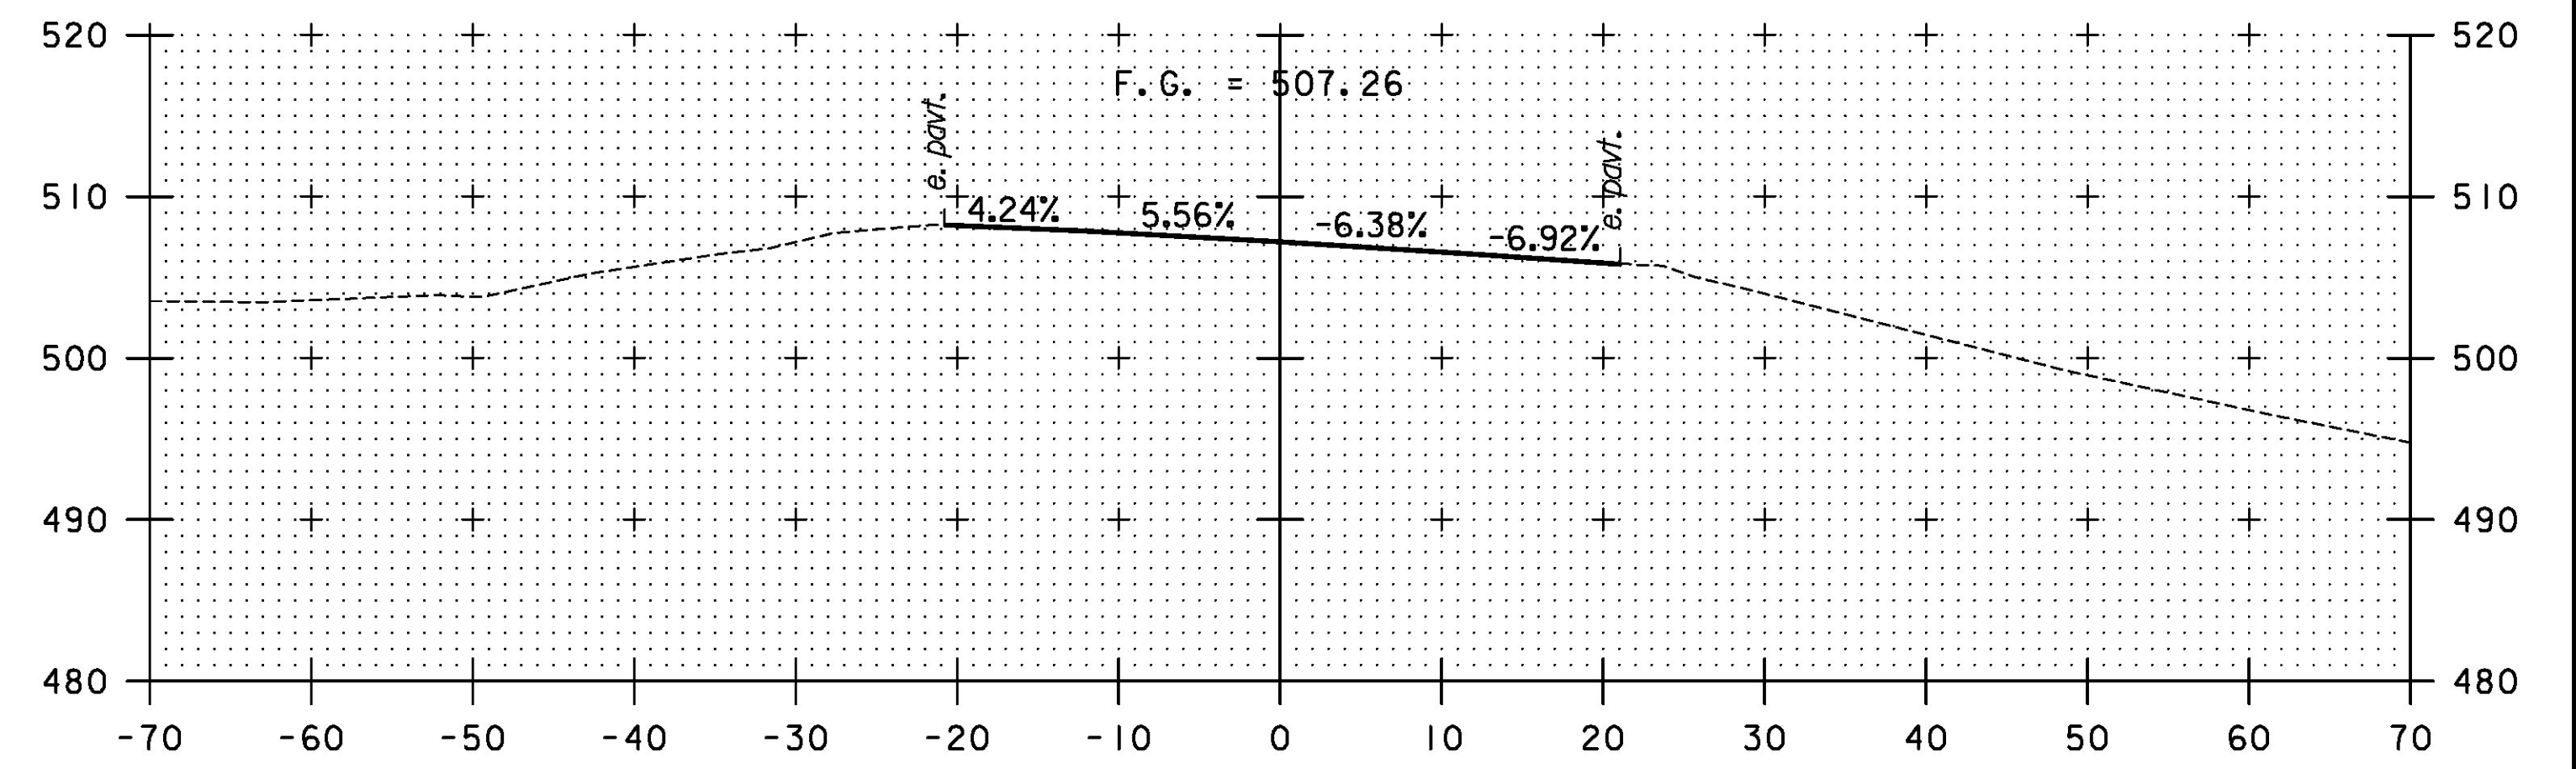

297+25

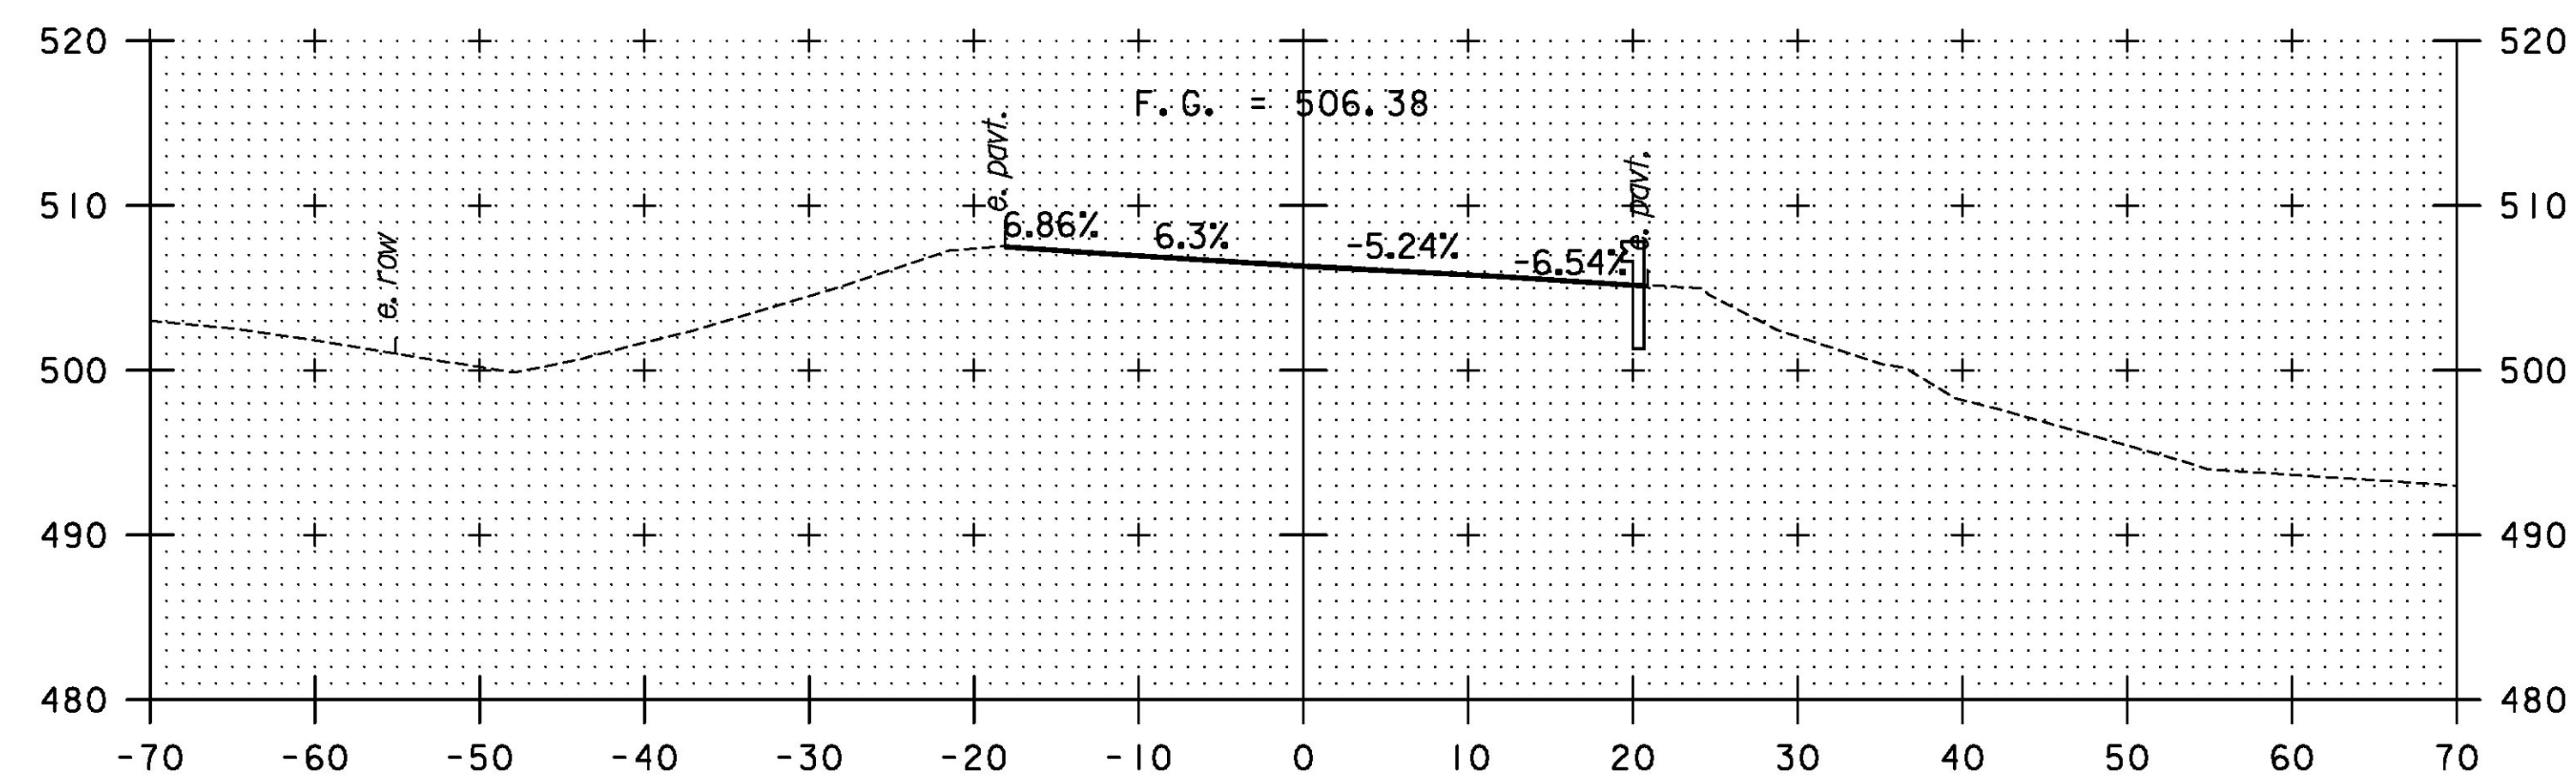

296+25

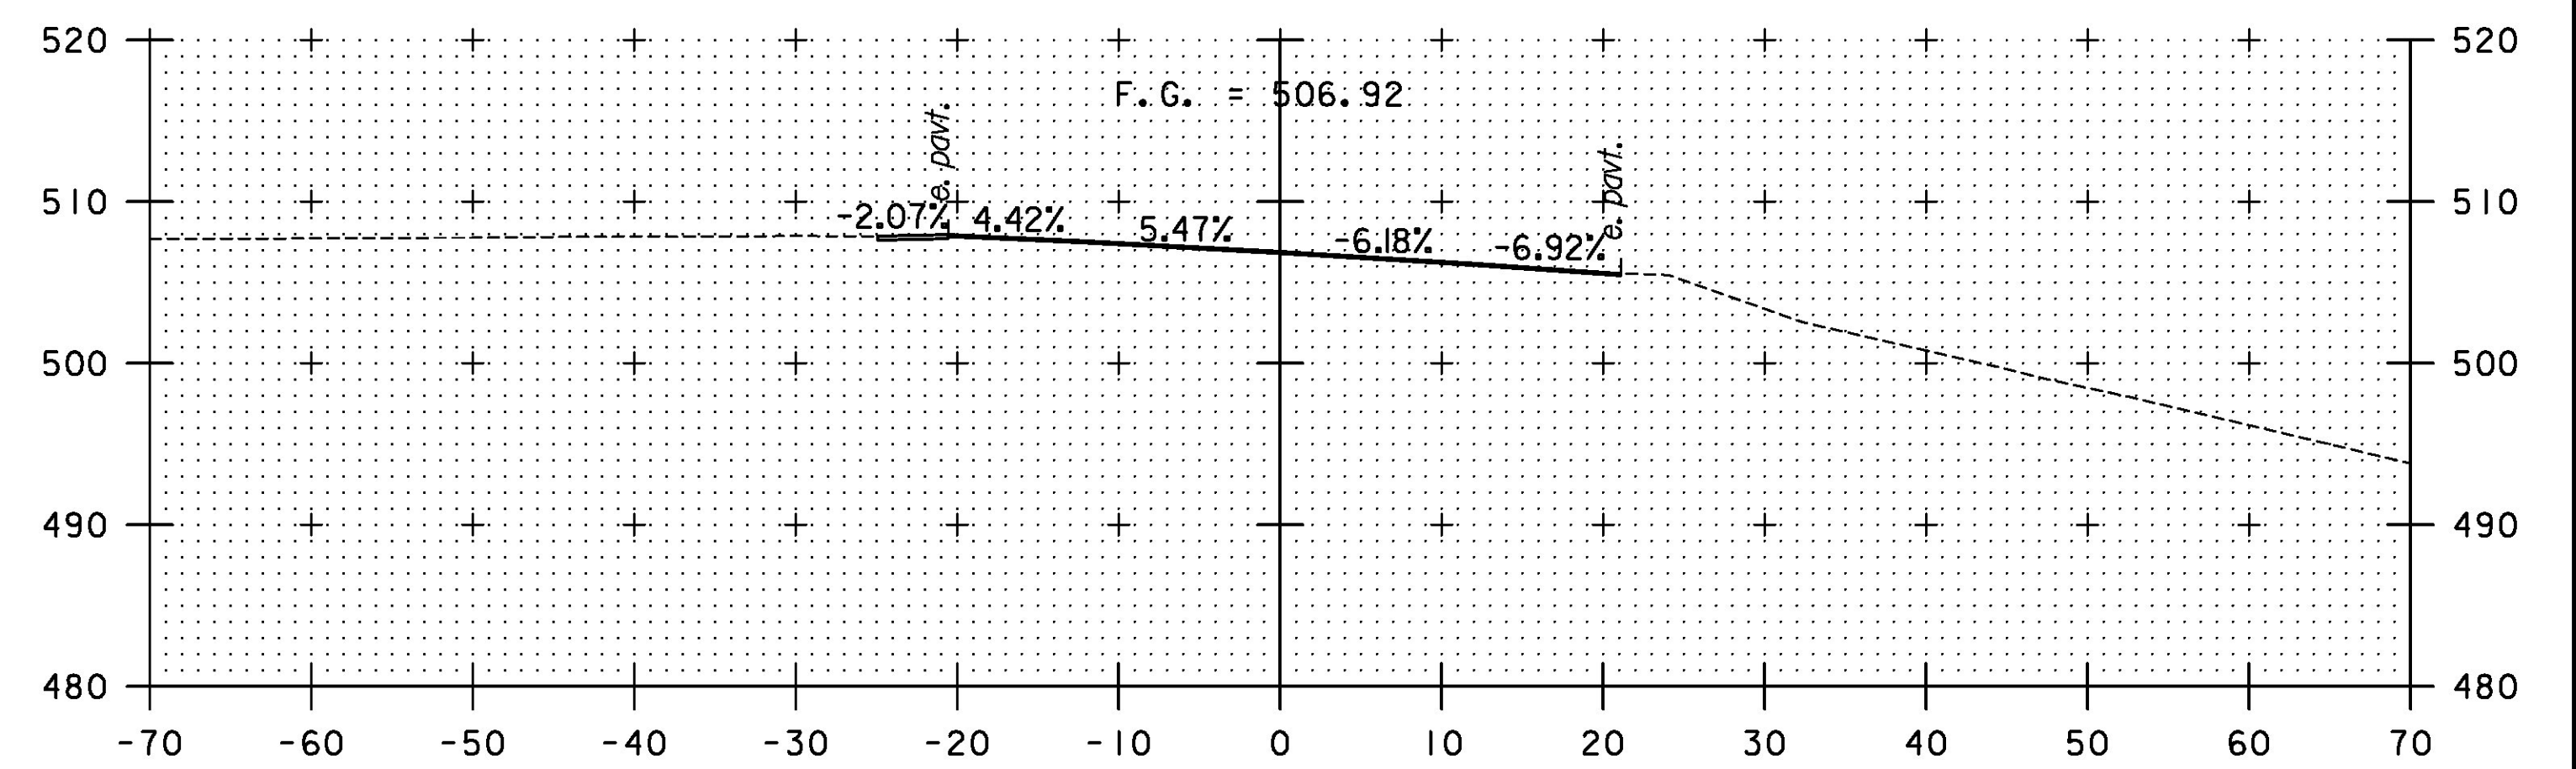

297+00

STA. 296+25 TO STA. 297+50

TYLINTERNATIONAL

PROJECT NAME: DUXBURY  
PROJECT NUMBER: BF 013-4(47)

FILE NAME: z16b001xs.dgn  
PROJECT LEADER: J. OLUND  
DESIGNED BY: J. HOWE  
VT 100 CROSS SECTIONS 5

PLOT DATE: 5/23/2016  
DRAWN BY: P. BRYANT  
CHECKED BY: J. OLUND  
SHEET 51 OF 69