




298+25

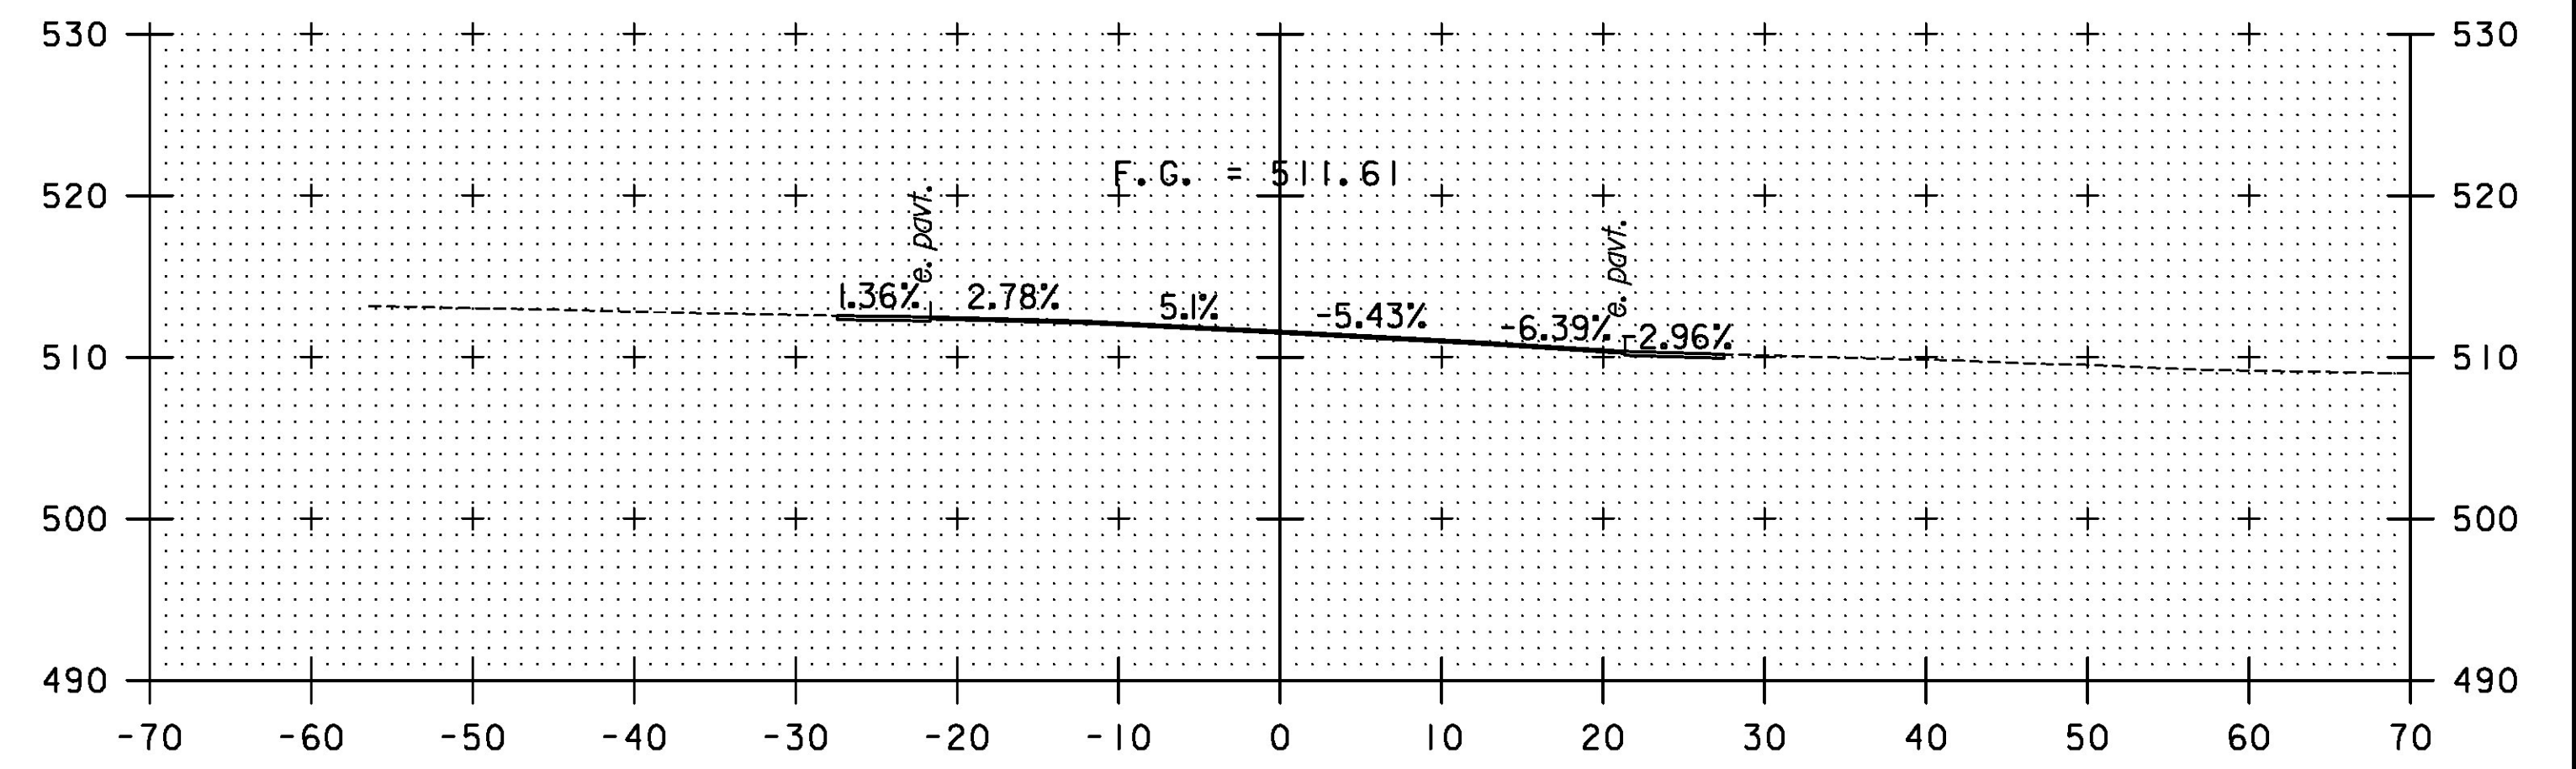


299+00

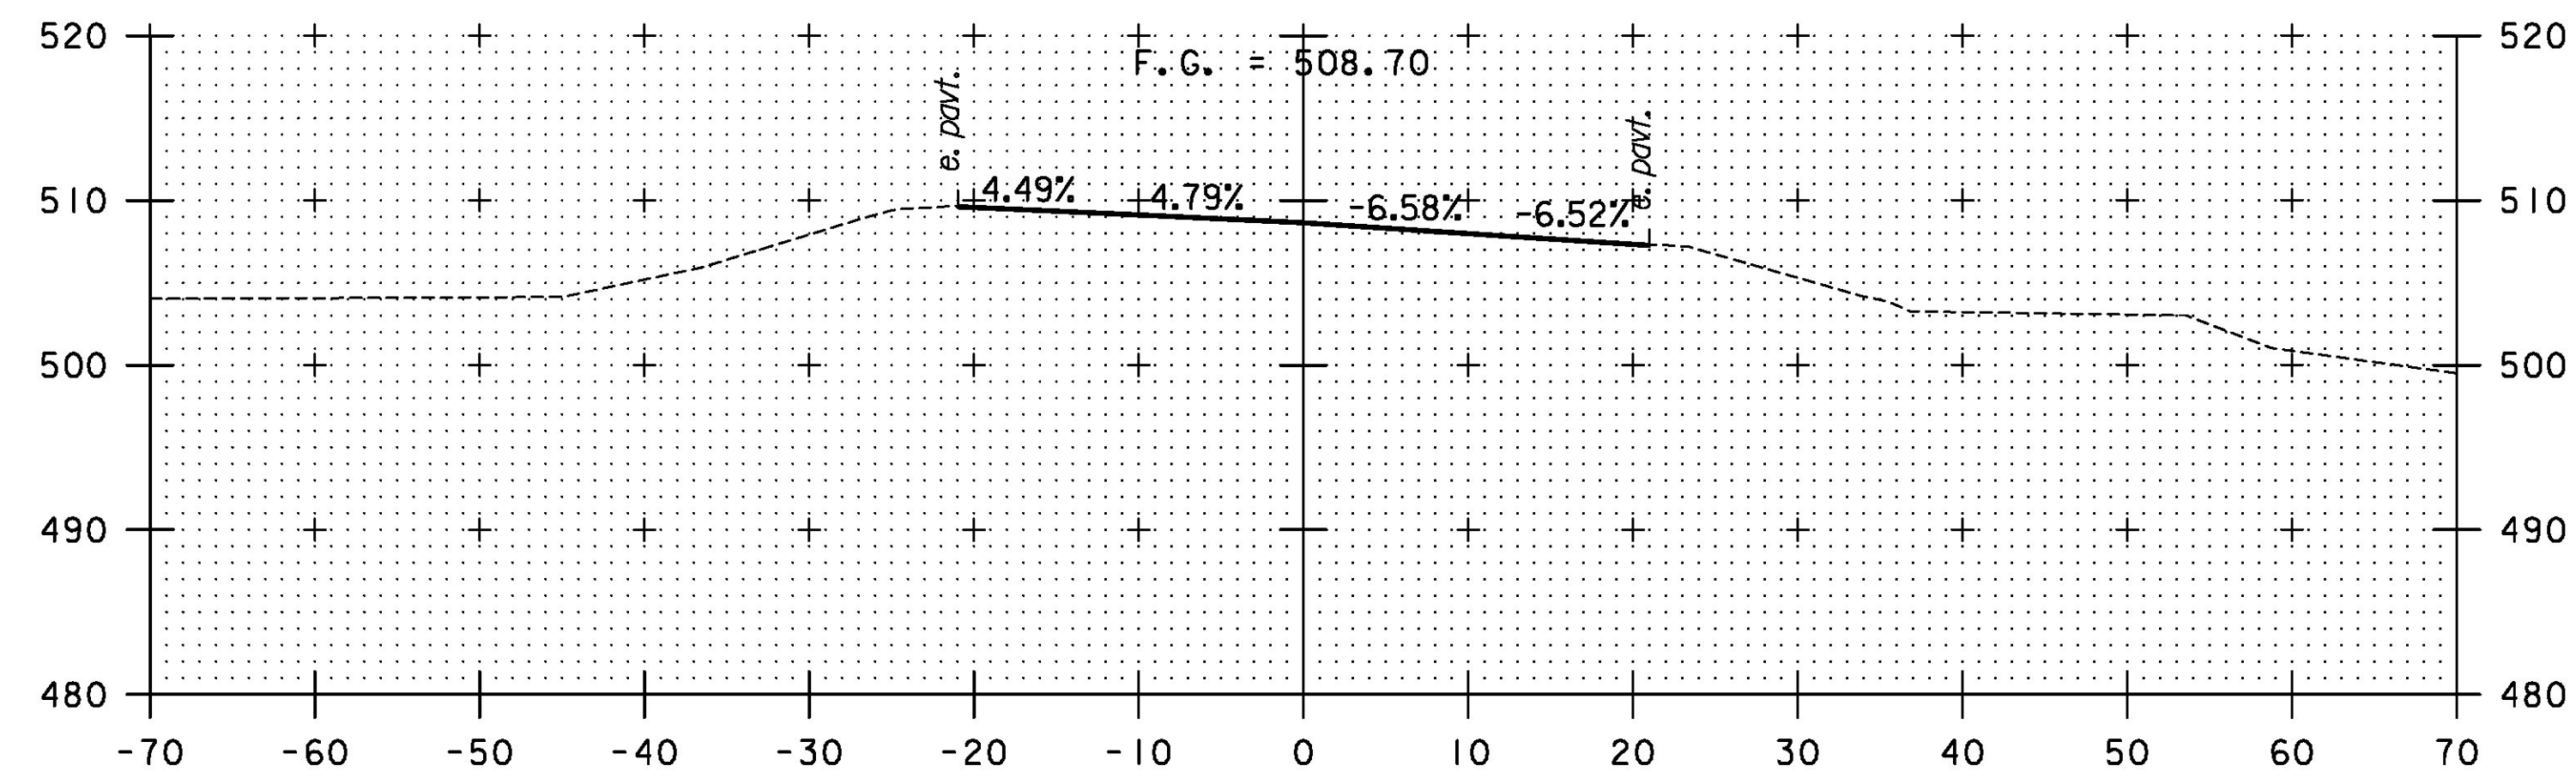


298+00

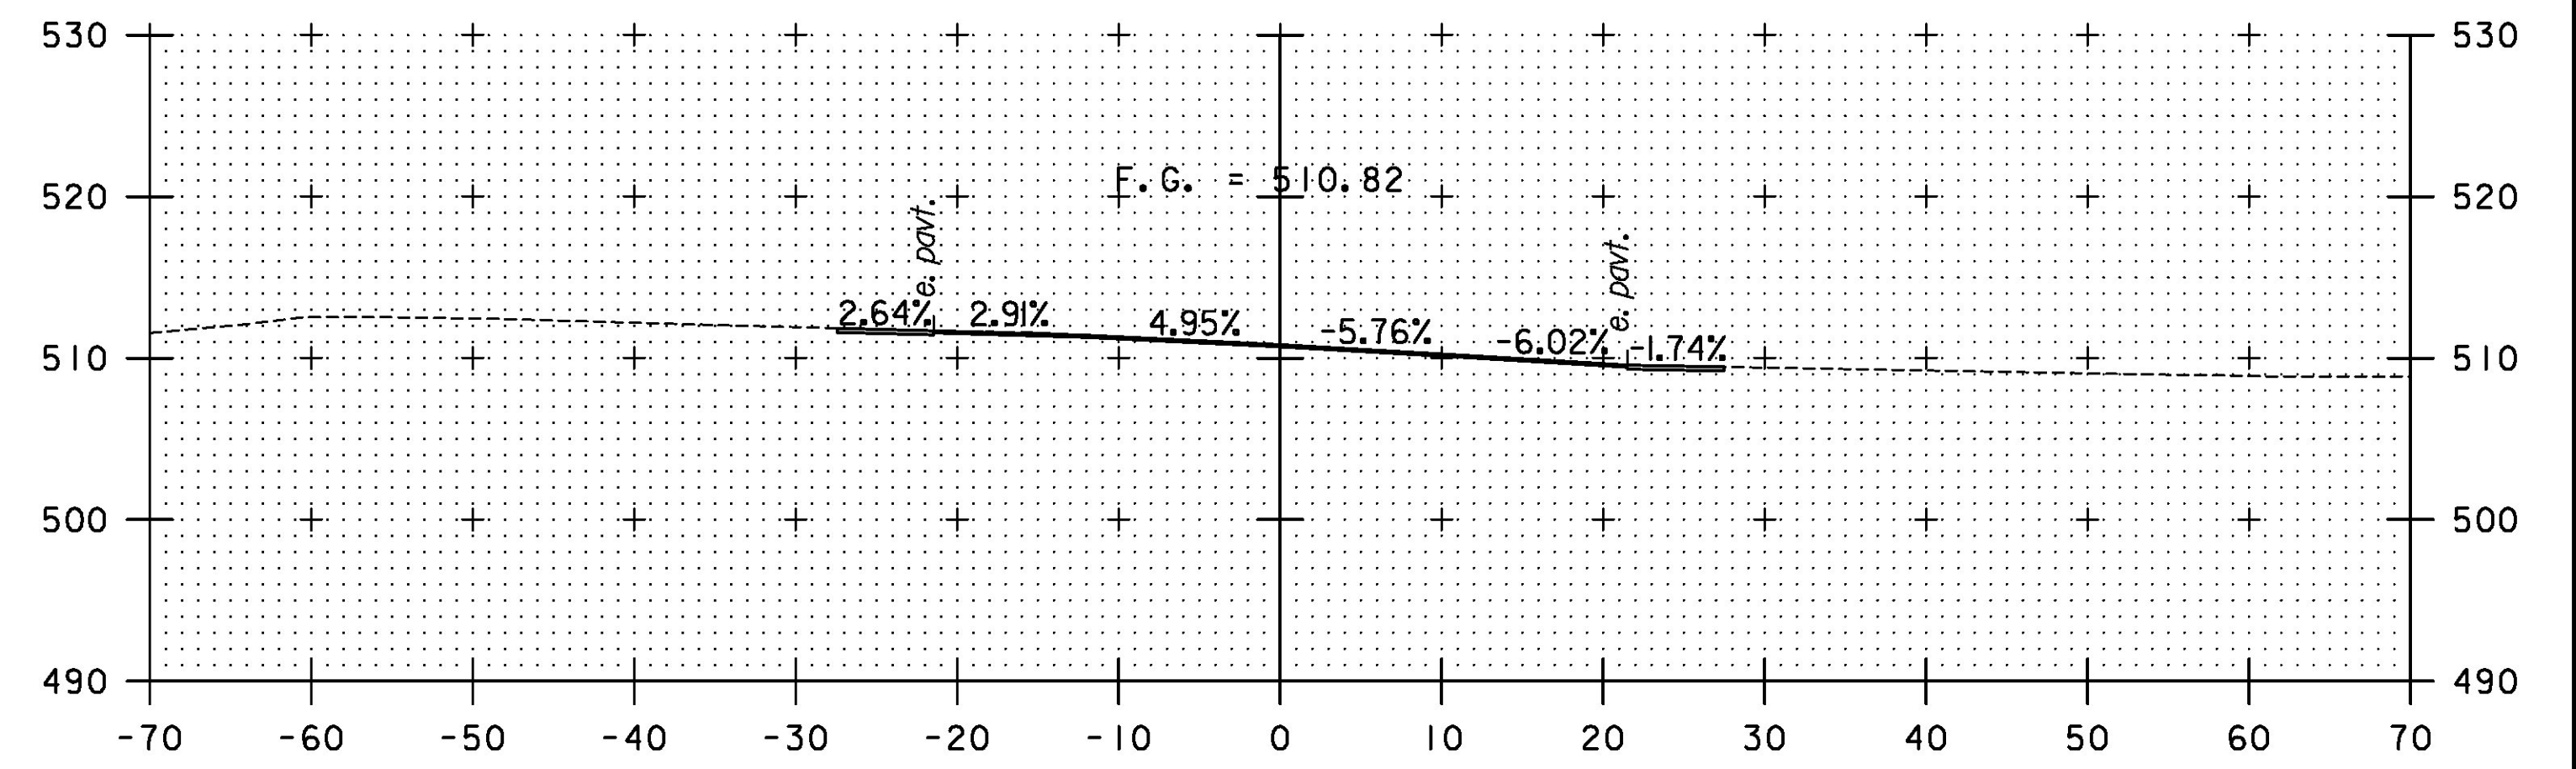

298+75

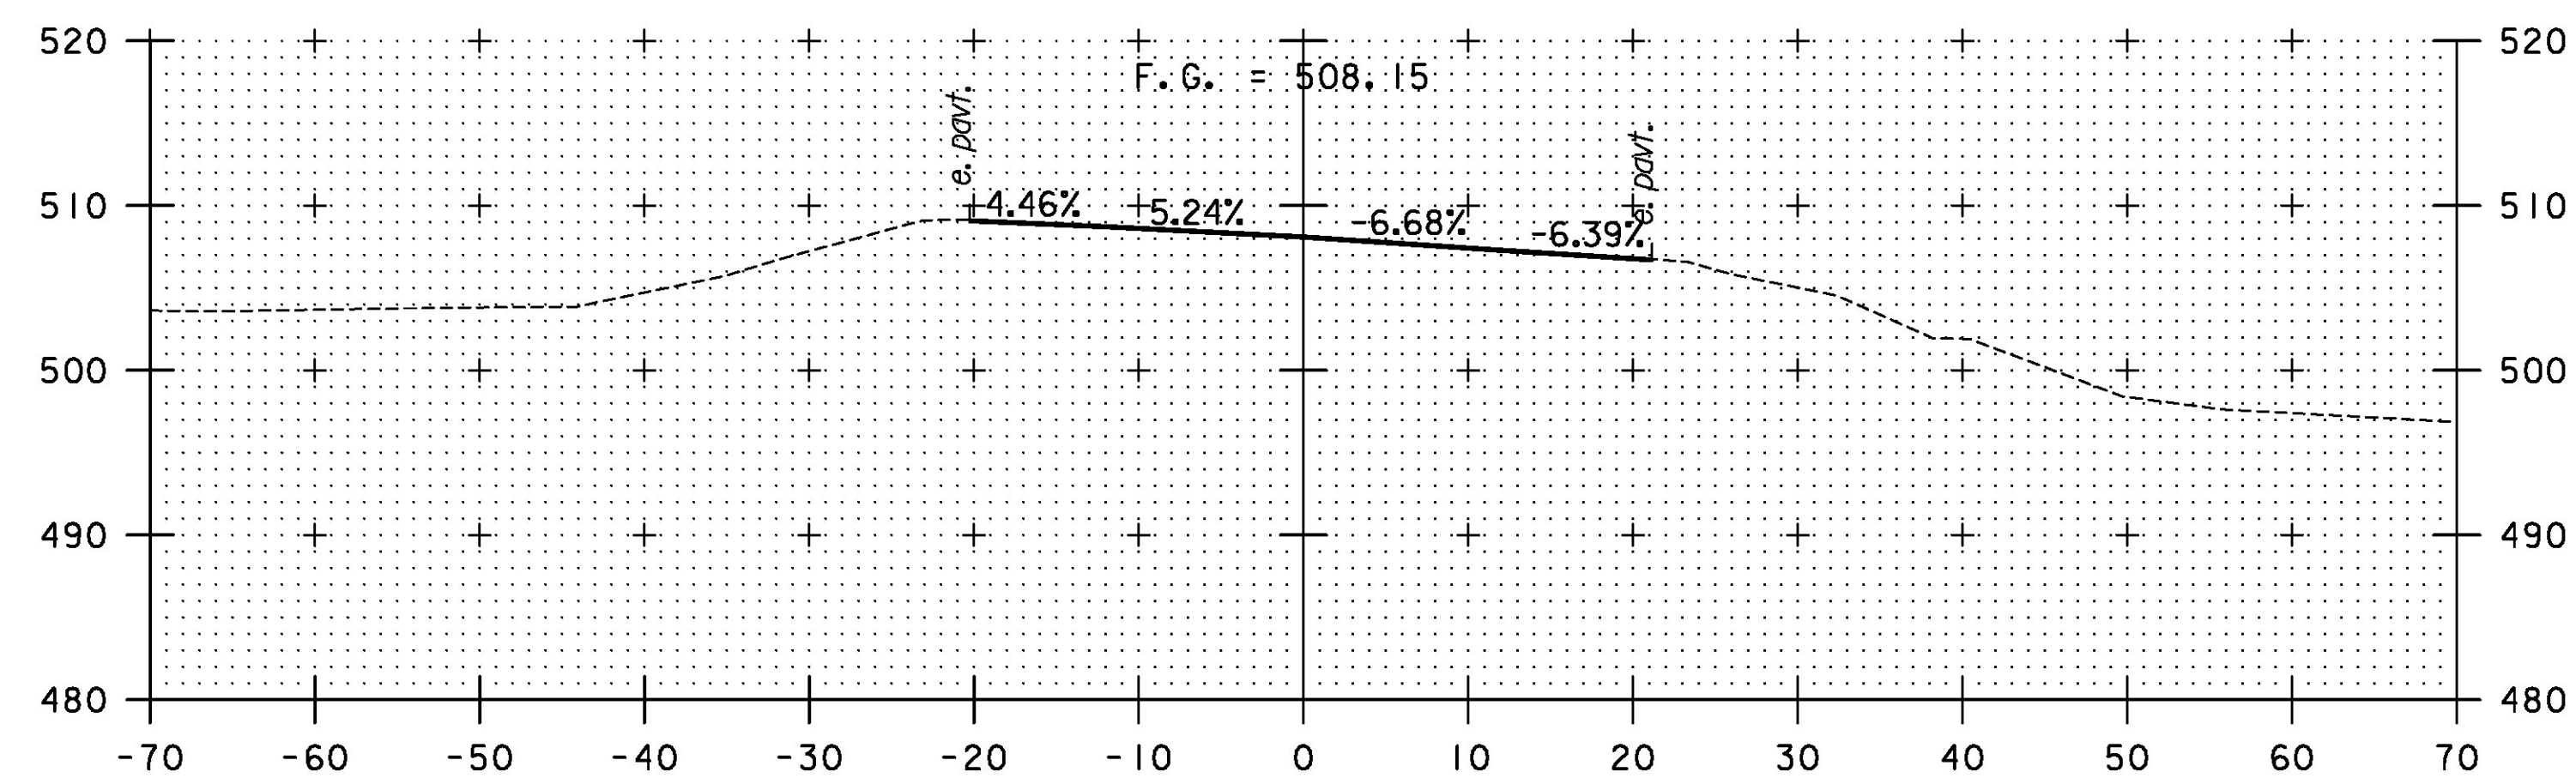

297+75

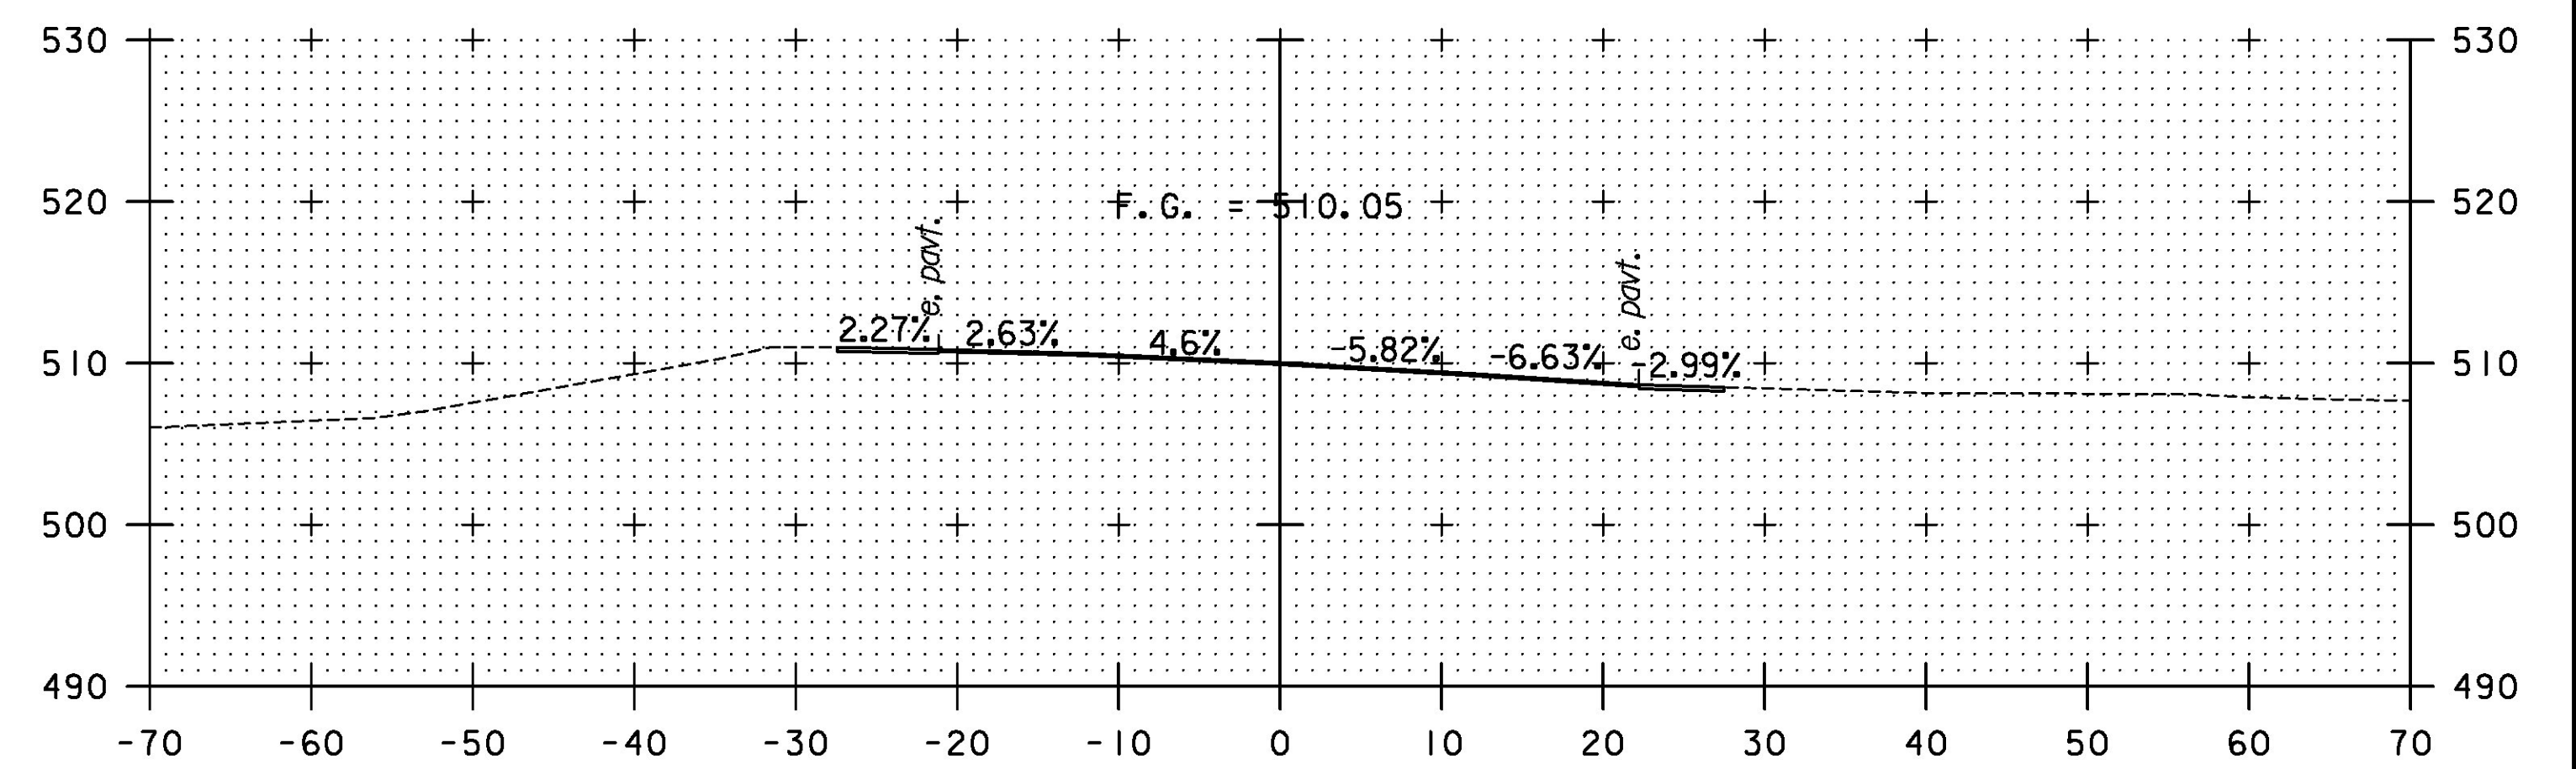

298+50

STA. 297+75 TO STA. 299+00

TYLIN INTERNATIONAL

PROJECT NAME:	DUXBURY	PLOT DATE:	5/23/2016
PROJECT NUMBER:	BF 013-4(47)	DRAWN BY:	P. BRYANT
FILE NAME:	z16b001xs.dgn	DESIGNED BY:	J. OLUND
PROJECT LEADER:	J. OLUND	CHECKED BY:	J. OLUND
VT 100 CROSS SECTIONS 6		SHEET	52 OF 69