


299+50  
END APPROACH

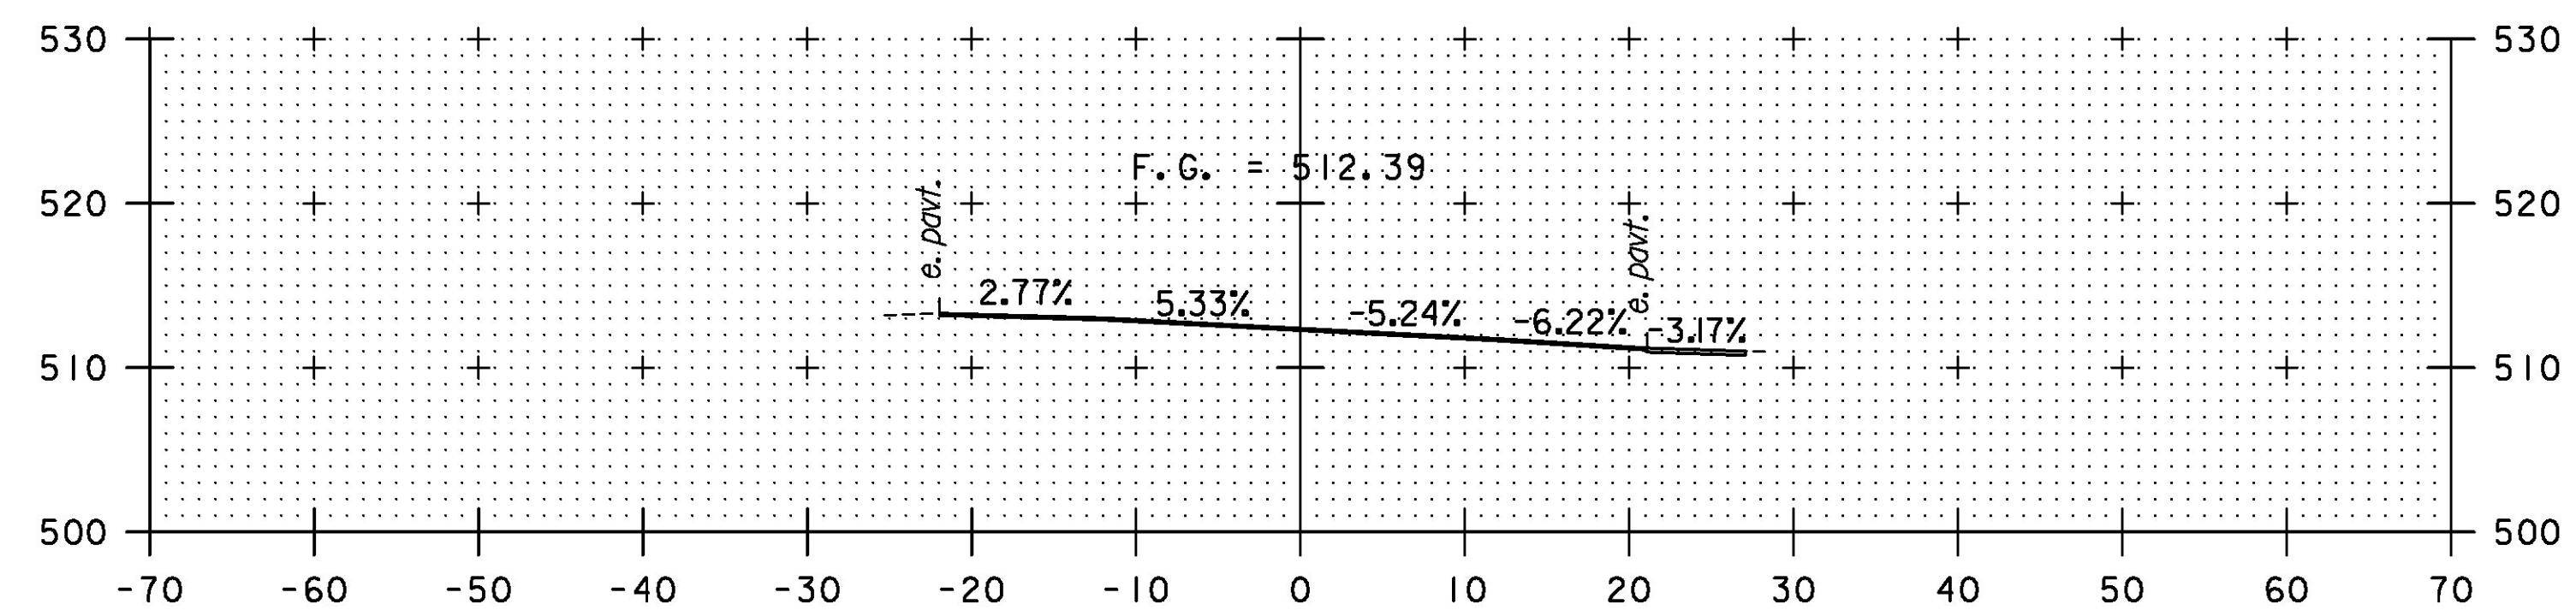

299+25

STA. 299+25 TO STA. 299+50

TYLINTERNATIONAL

PROJECT NAME: DUXBURY  
PROJECT NUMBER: BF 013-4(47)

FILE NAME: z16b001xs.dgn  
PROJECT LEADER: J. OLUND  
DESIGNED BY: J. HOWE  
VT 100 CROSS SECTIONS 7

PLOT DATE: 5/23/2016  
DRAWN BY: P. BRYANT  
CHECKED BY: J. OLUND  
SHEET 53 OF 69