


22+50


STA 22+32.39, LT  
 END UNCLASSIFIED CHANNEL EXCAVATION  
~~END GEOTEXTILE UNDER STONE FILL~~  
 END STONE FILL TYPE III  
 END GRUBBING MATERIAL

STA 22+32.39, LT & RT  
 END SPECIAL PROVISION  
 (STONE FILL, STREAM BED  
 MATERIAL) (TYPE III)

STA 22+32.39, RT  
 END UNCLASSIFIED CHANNEL EXCAVATION  
~~END GEOTEXTILE UNDER STONE FILL~~  
 END STONE FILL TYPE III  
 END GRUBBING MATERIAL

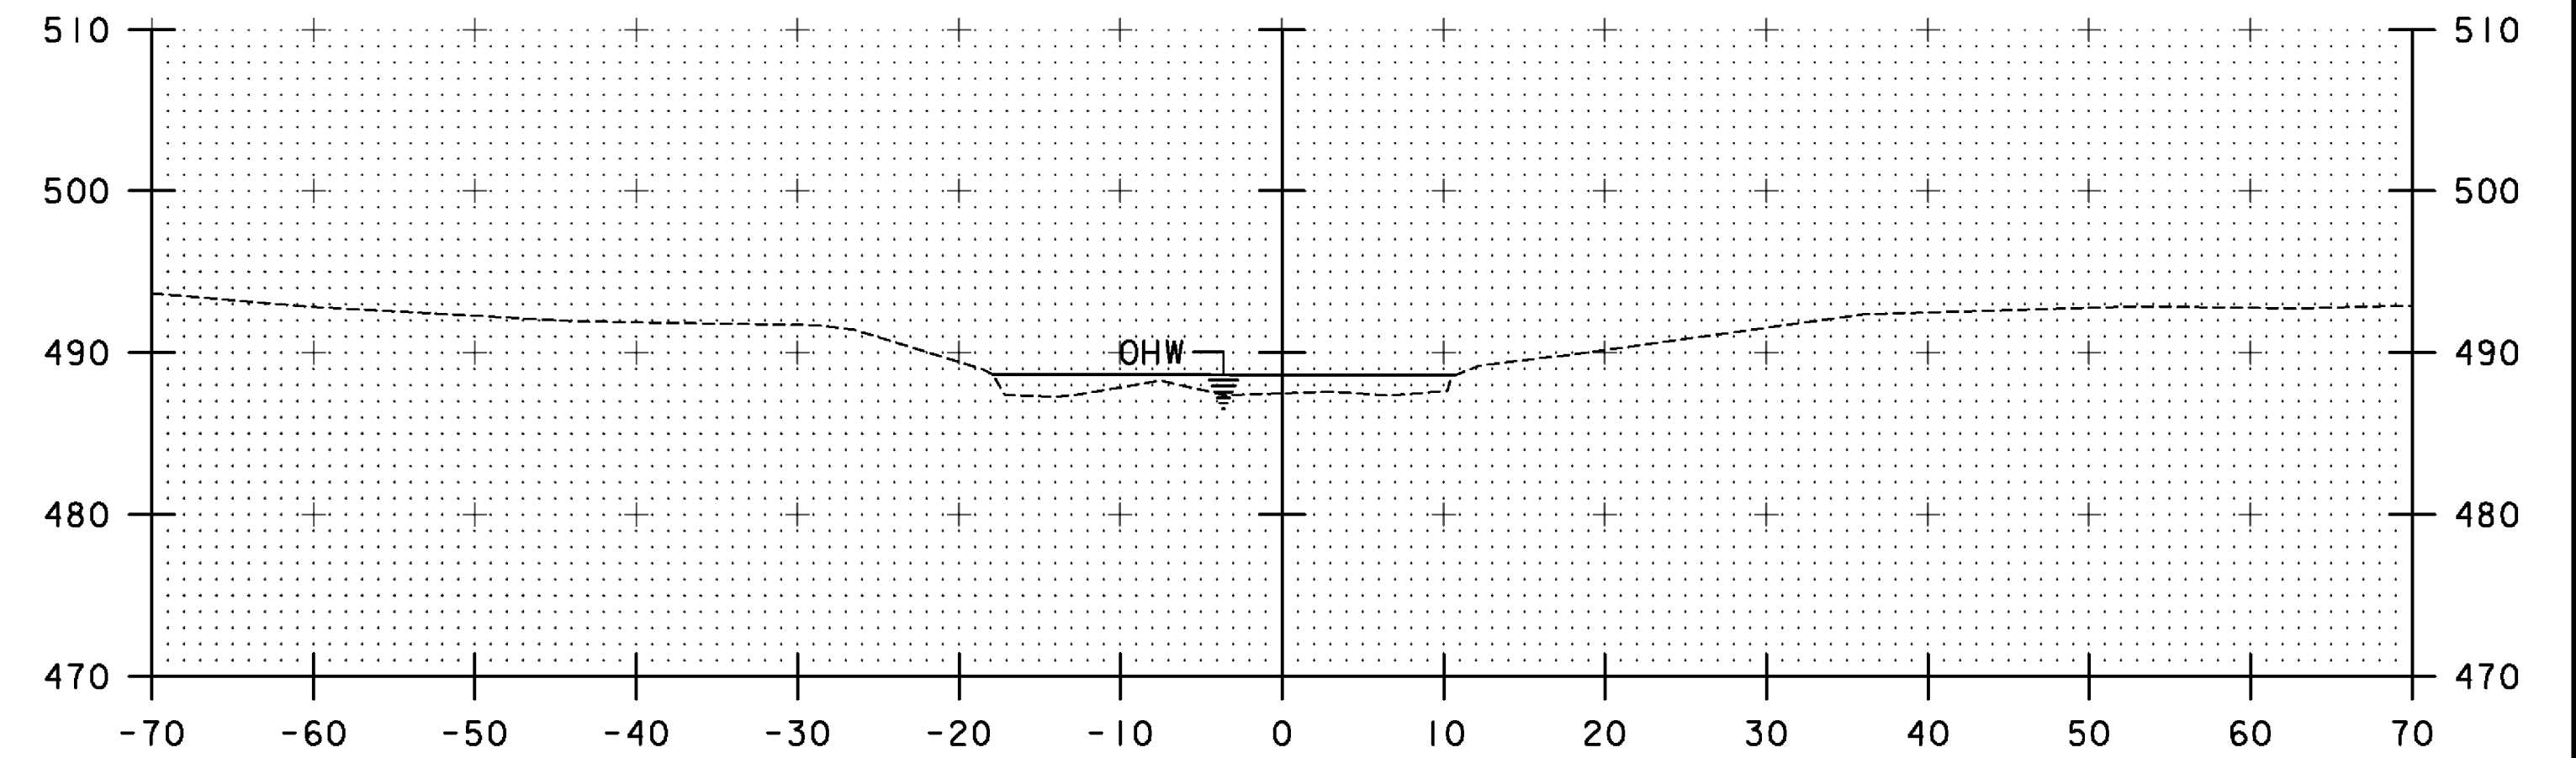


23+00

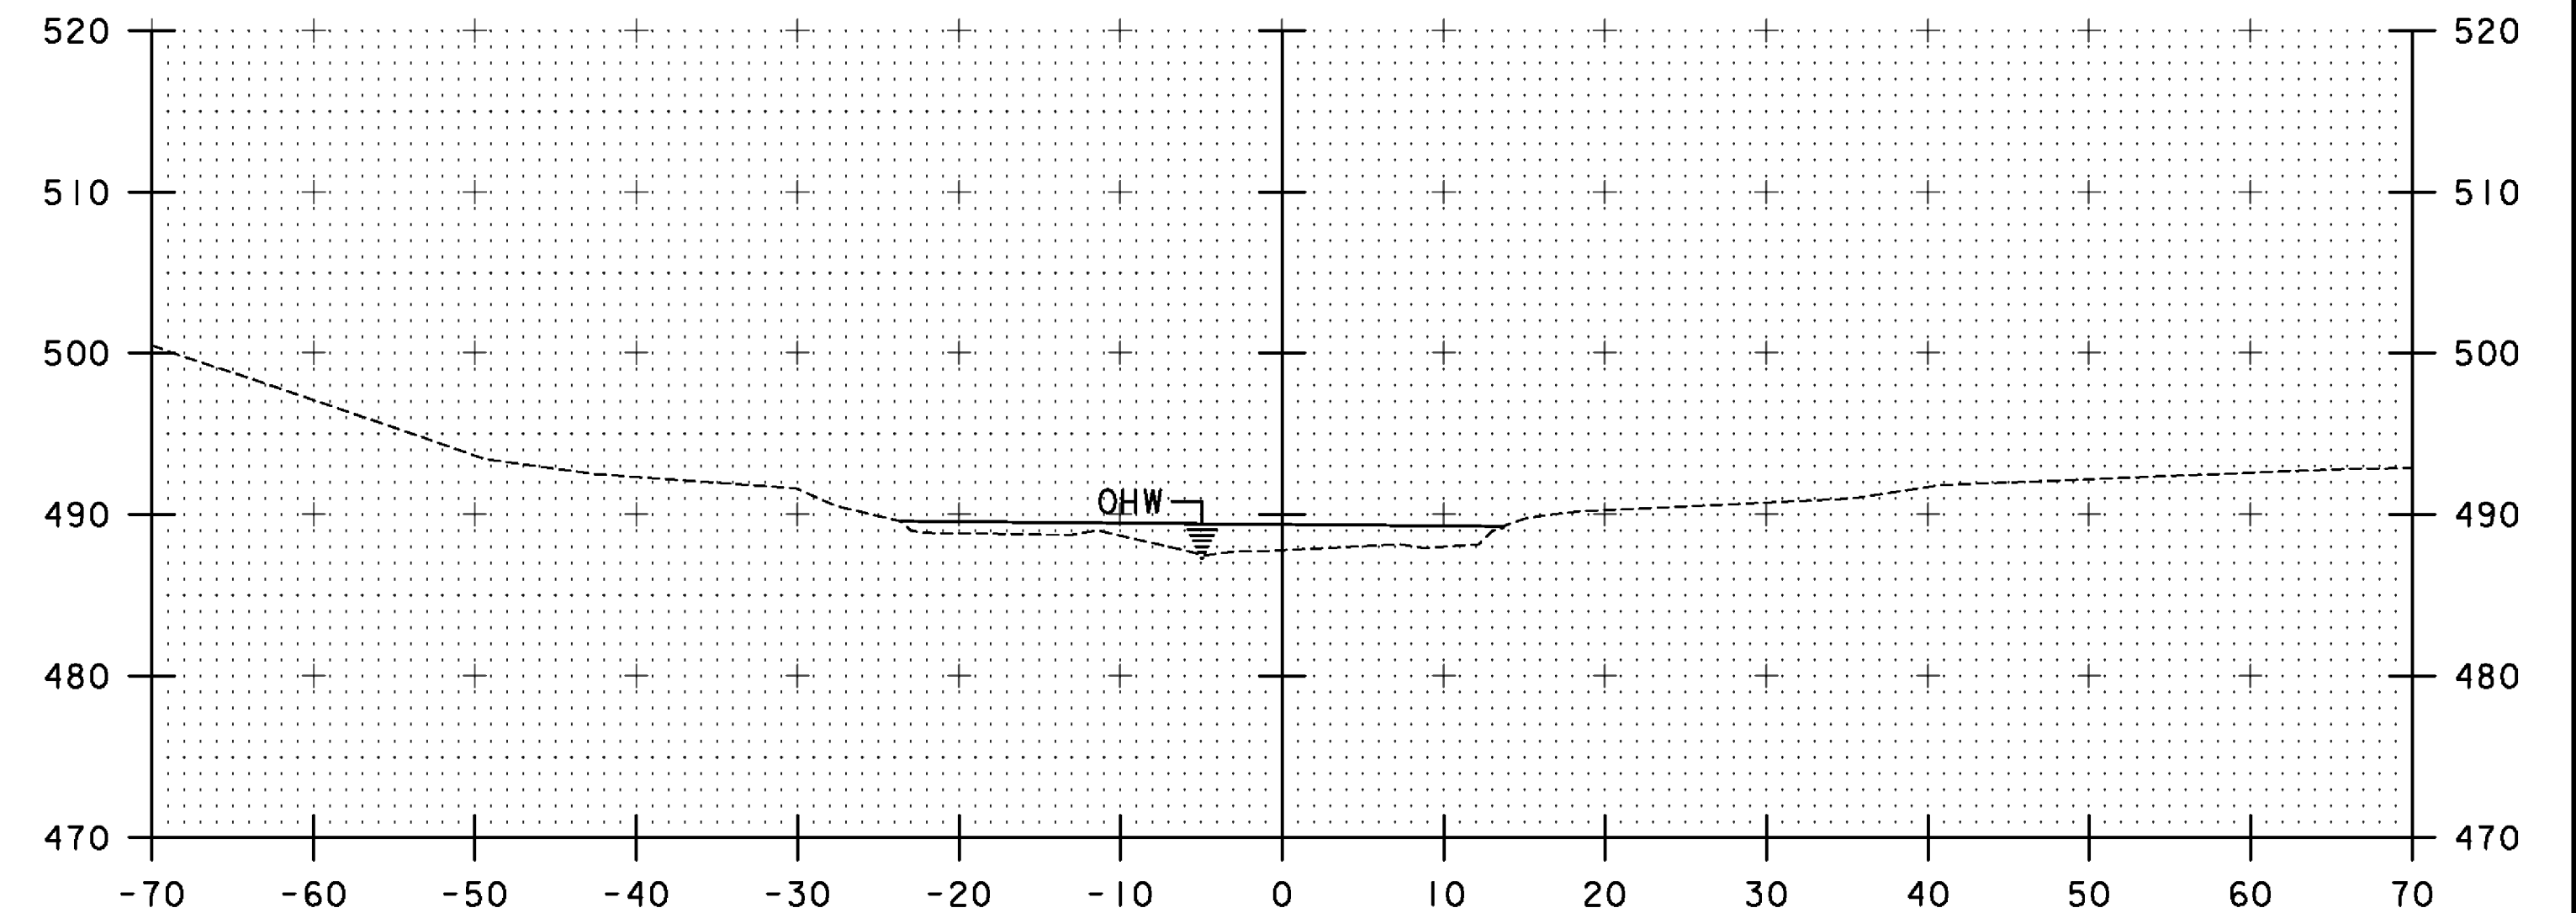

22+75

NOTE: TEMPORARY BRIDGE AND ROADWAY NOT SHOWN

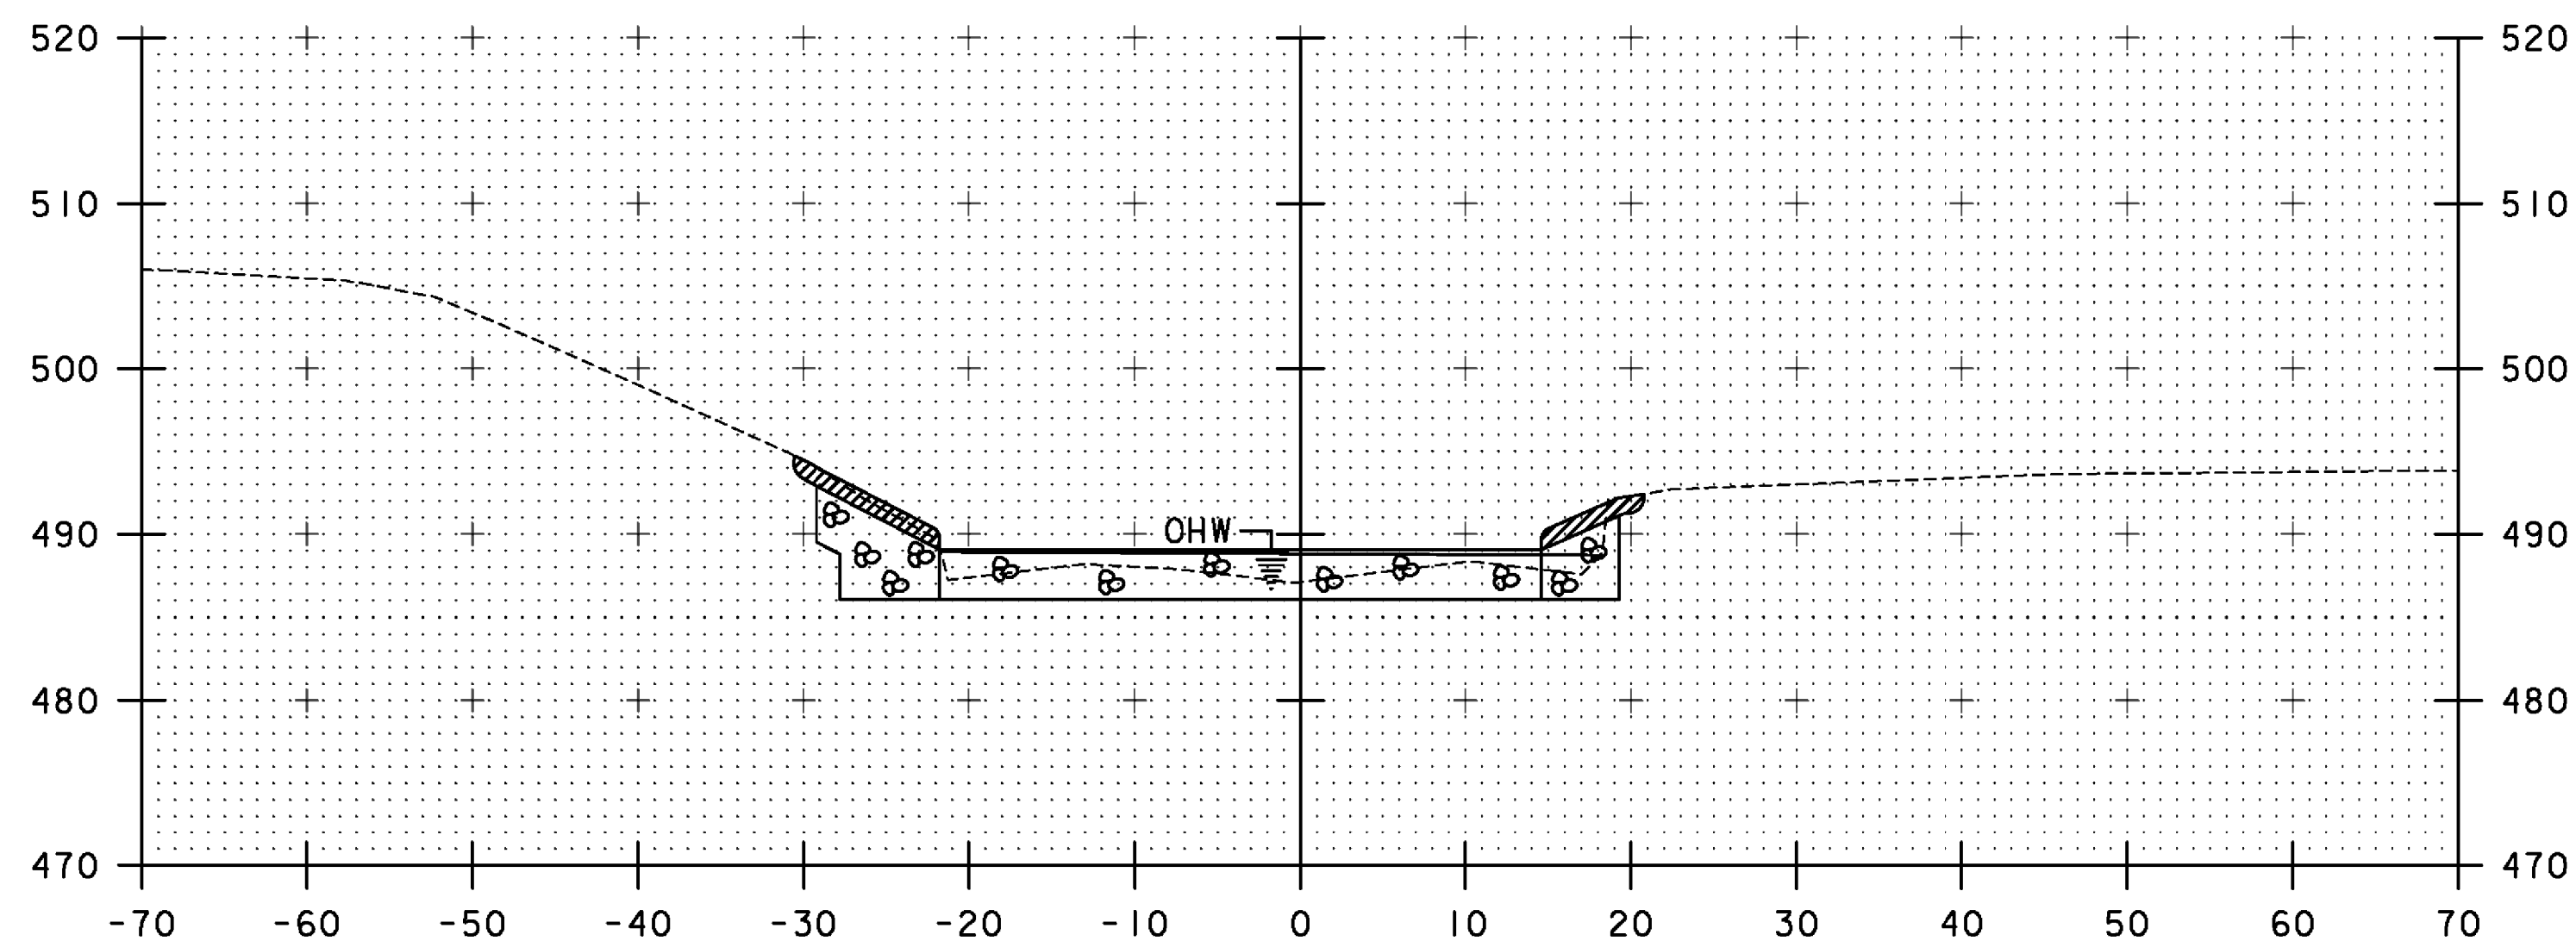

22+25

STA. 22+25 TO STA. 23+00

TYLINTERNATIONAL

PROJECT NAME: DUXBURY  
 PROJECT NUMBER: BF 013-4(47)

FILE NAME: z16b00\xschan.dgn  
 PROJECT LEADER: J. OLUND  
 DESIGNED BY: B. TOOTHAKER  
 CHANNEL SECTIONS 3

PLOT DATE: 5/23/2016  
 DRAWN BY: B. TOOTHAKER  
 CHECKED BY: D. MYERS  
 SHEET 56 OF 69