


EPSC - CONSTRUCTION SITE PLAN 2

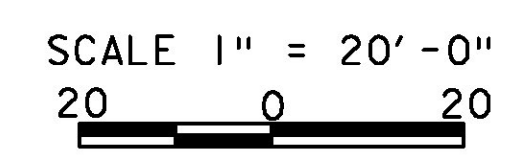

**TYLIN**INTERNATIONAL

PROJECT NAME:	DUXBURY	PLOT DATE:	5/23/2016
PROJECT NUMBER:	BF 013-4(47)	DRAWN BY:	S. MORGAN
FILE NAME:	z16b001ero.dgn	DESIGNED BY:	B. TOOTHAKER
PROJECT LEADER:	J. OLUND	CHECKED BY:	J. OLUND
EPSC CONSTRUCTION SITE PLAN 2		SHEET	61 OF 69