


CURVE (2)  
 DELTA = 53°27'02"  
 D = 5°15'00"  
 R = 1091.35'  
 T = 549.50'  
 L = 1018.11'  
 E = 130.53'  
 PT STA 303+43.66

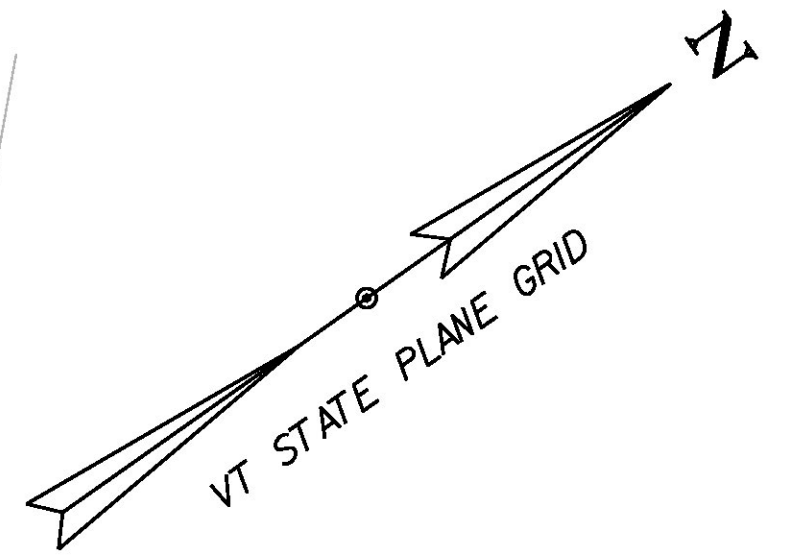

WOVEN WIRE FENCE WITH STEEL POSTS  
 STA 295+88.25 - STA 297+44.38, RT  
**CARMINATI, SUSAN G. & TED L.**  
 ANCHOR FOR STEEL BEAM RAIL  
 STA 296+50.00, RT

N/F  
**WELCH, KELLY J.**

CONSTRUCT DRIVES  
 STA 295+59.37 - STA 295+84.46, LT  
 6' PAVED APRON  
 STA 296+96.26 - STA 297+24.64, LT  
 5' PAVED APRON  
 STA 298+30.77 - STA 299+34.87, RT  
 6' PAVED APRON  
 STA 298+42.42 - STA 299+16.76, LT  
 6' PAVED APRON

N/F  
**SANTARCANGELO, SUZANNE;  
 MERRIMAN, PETER E.**

MATCH LINE STA 295+50

4  
**TOWN OF DUXBURY**

5  
**UNION SCHOOL DISTRICT NO. 45**

**END R.O.W. PROJECT  
 DUXBURY BF 013-4(47)  
 STA. 297+08, 94' RT**

LAYOUT 2  
 SCALE 1" = 20' - 0"  
 20 0 20

LINES SHOWN ON THIS PLAN AS EXISTING PROPERTY LINES P/L ARE BELIEVED TO BE ACCURATE BUT SHOULD NOT BE RELIED UPON FOR PURPOSES UNRELATED TO THE STATE OF VERMONT'S ACQUISITION OF LAND AND RIGHTS FOR THIS PROJECT.

**FOR R.O.W. USE ONLY**

PROJECT NAME: DUXBURY	PLOT DATE: 05-MAY-2016
PROJECT NUMBER: BF 013-4(47)	DRAWN BY: T. POLK
FILE NAME: r16b001lay2.dgn	CHECKED BY: S. PATTERSON
DESIGNED BY: TYLIN	SHEET 69 OF 69
R.O.W. LAYOUT SHEET 2 OF 2	