


TYLINTERNATIONAL
 The stamped document is hereby:
 Approved
 Approved as noted
 Revise and resubmit
 See transmittal for additional information as applicable.

This document is for general information only. It does not constitute a contract. Any deviation from the plan or specifications is to be noted by the Contractor as a change order. Review by the Engineer shall not relieve the Contractor of the contractual responsibility for any errors or omissions from the contract requirements.

Josh Olund
 Reviewer
 08/03/2016
 Date

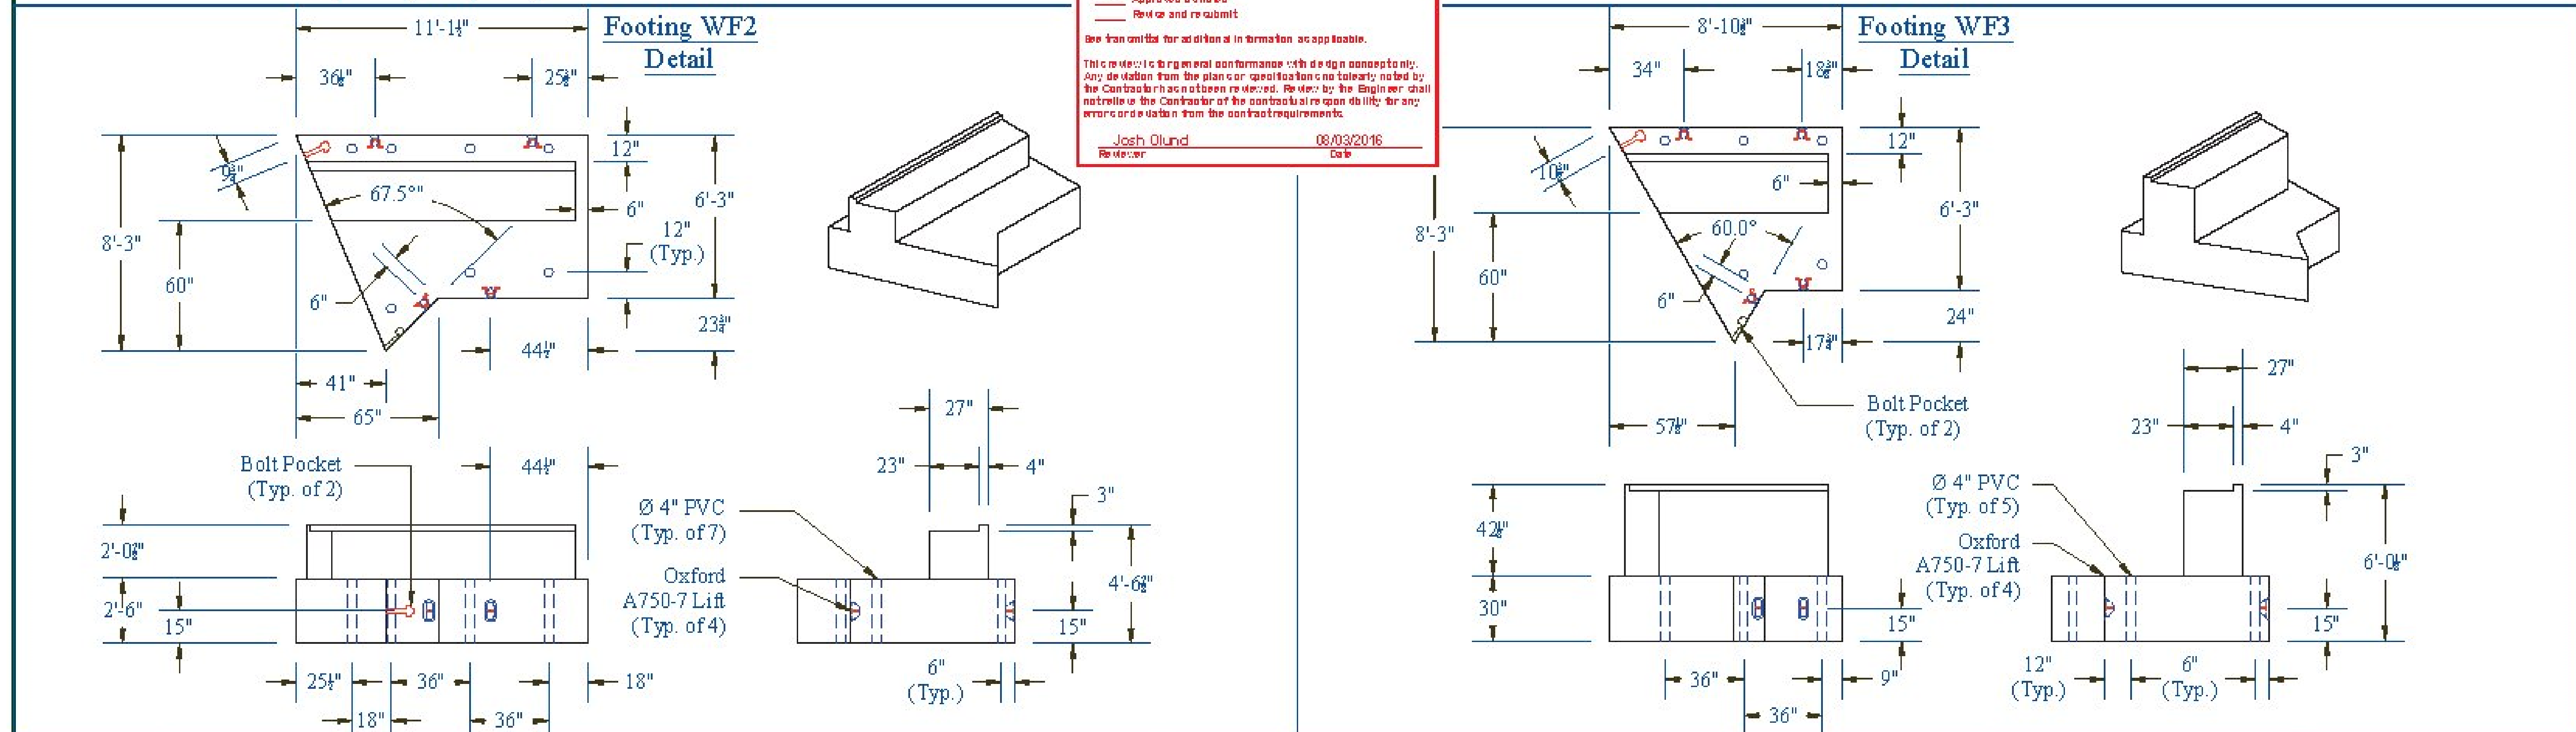

CONTRACTOR'S VISPE:

Vermont Agency of Transportation
RECEIVED
 CK'D BY TYUn OK'D BY MH
 August 2, 2016
 RESUBMIT No Approved
 BY Nils Haggre DATE 08/03/2016

PRECAST CONCRETE BOX CULVERT SHOP DRAWINGS (SDI JOB #17682)
 SUPERVISOR: E. Barendse
 DETAILER: I. ADAMS
 CHECKER: E. Barendse

INSTALLER:
 J.A. McDONALD
 585 Gilman Rd
 Lyndon Ctr, VT 05850
 07/29/16

FABRICATOR:
 193 INDUSTRIAL AVE.
 WILLISTON, VT 05495
 Ph: (802) 658-0201
SD Ireland
 PRECAST
 WING_FOOTINGS
 5_OF_12