



**Footing SF2-15/NF2-NF15 Detail**

Heaviest Section: NF-2

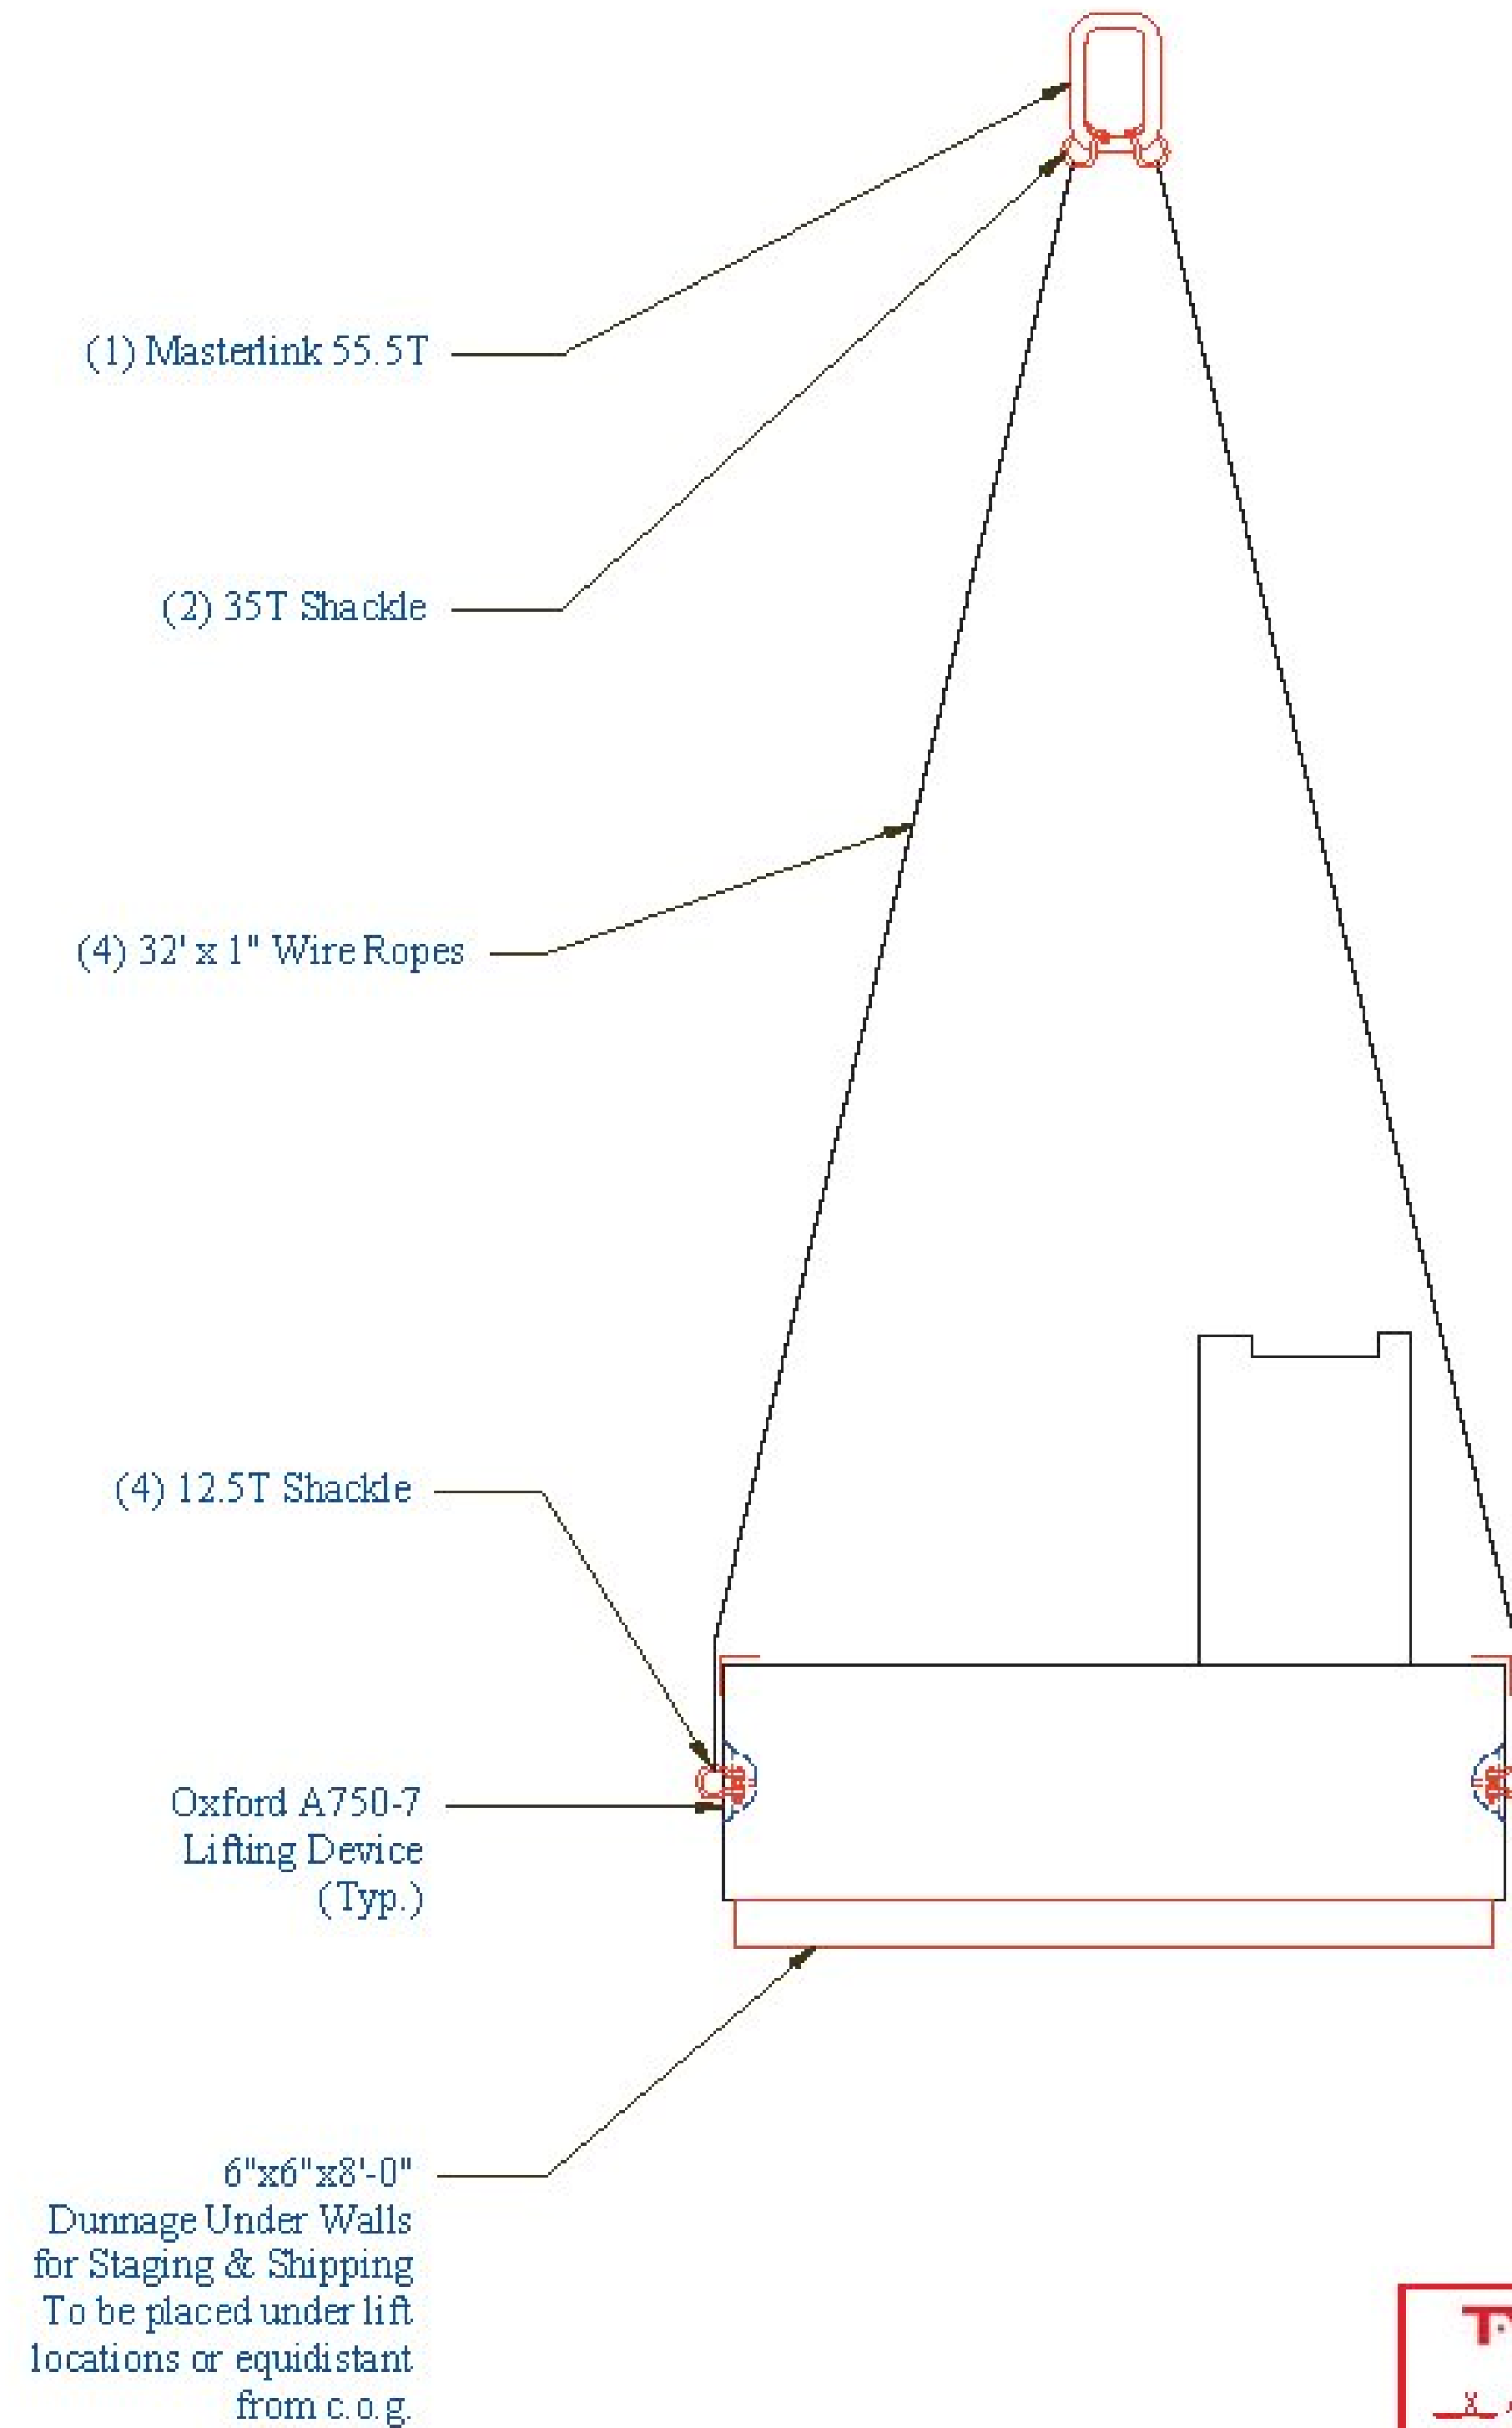

**Footing SF1,SF16,NF1,NF16,& WF Footings Detail**

Heaviest Section: NF-1

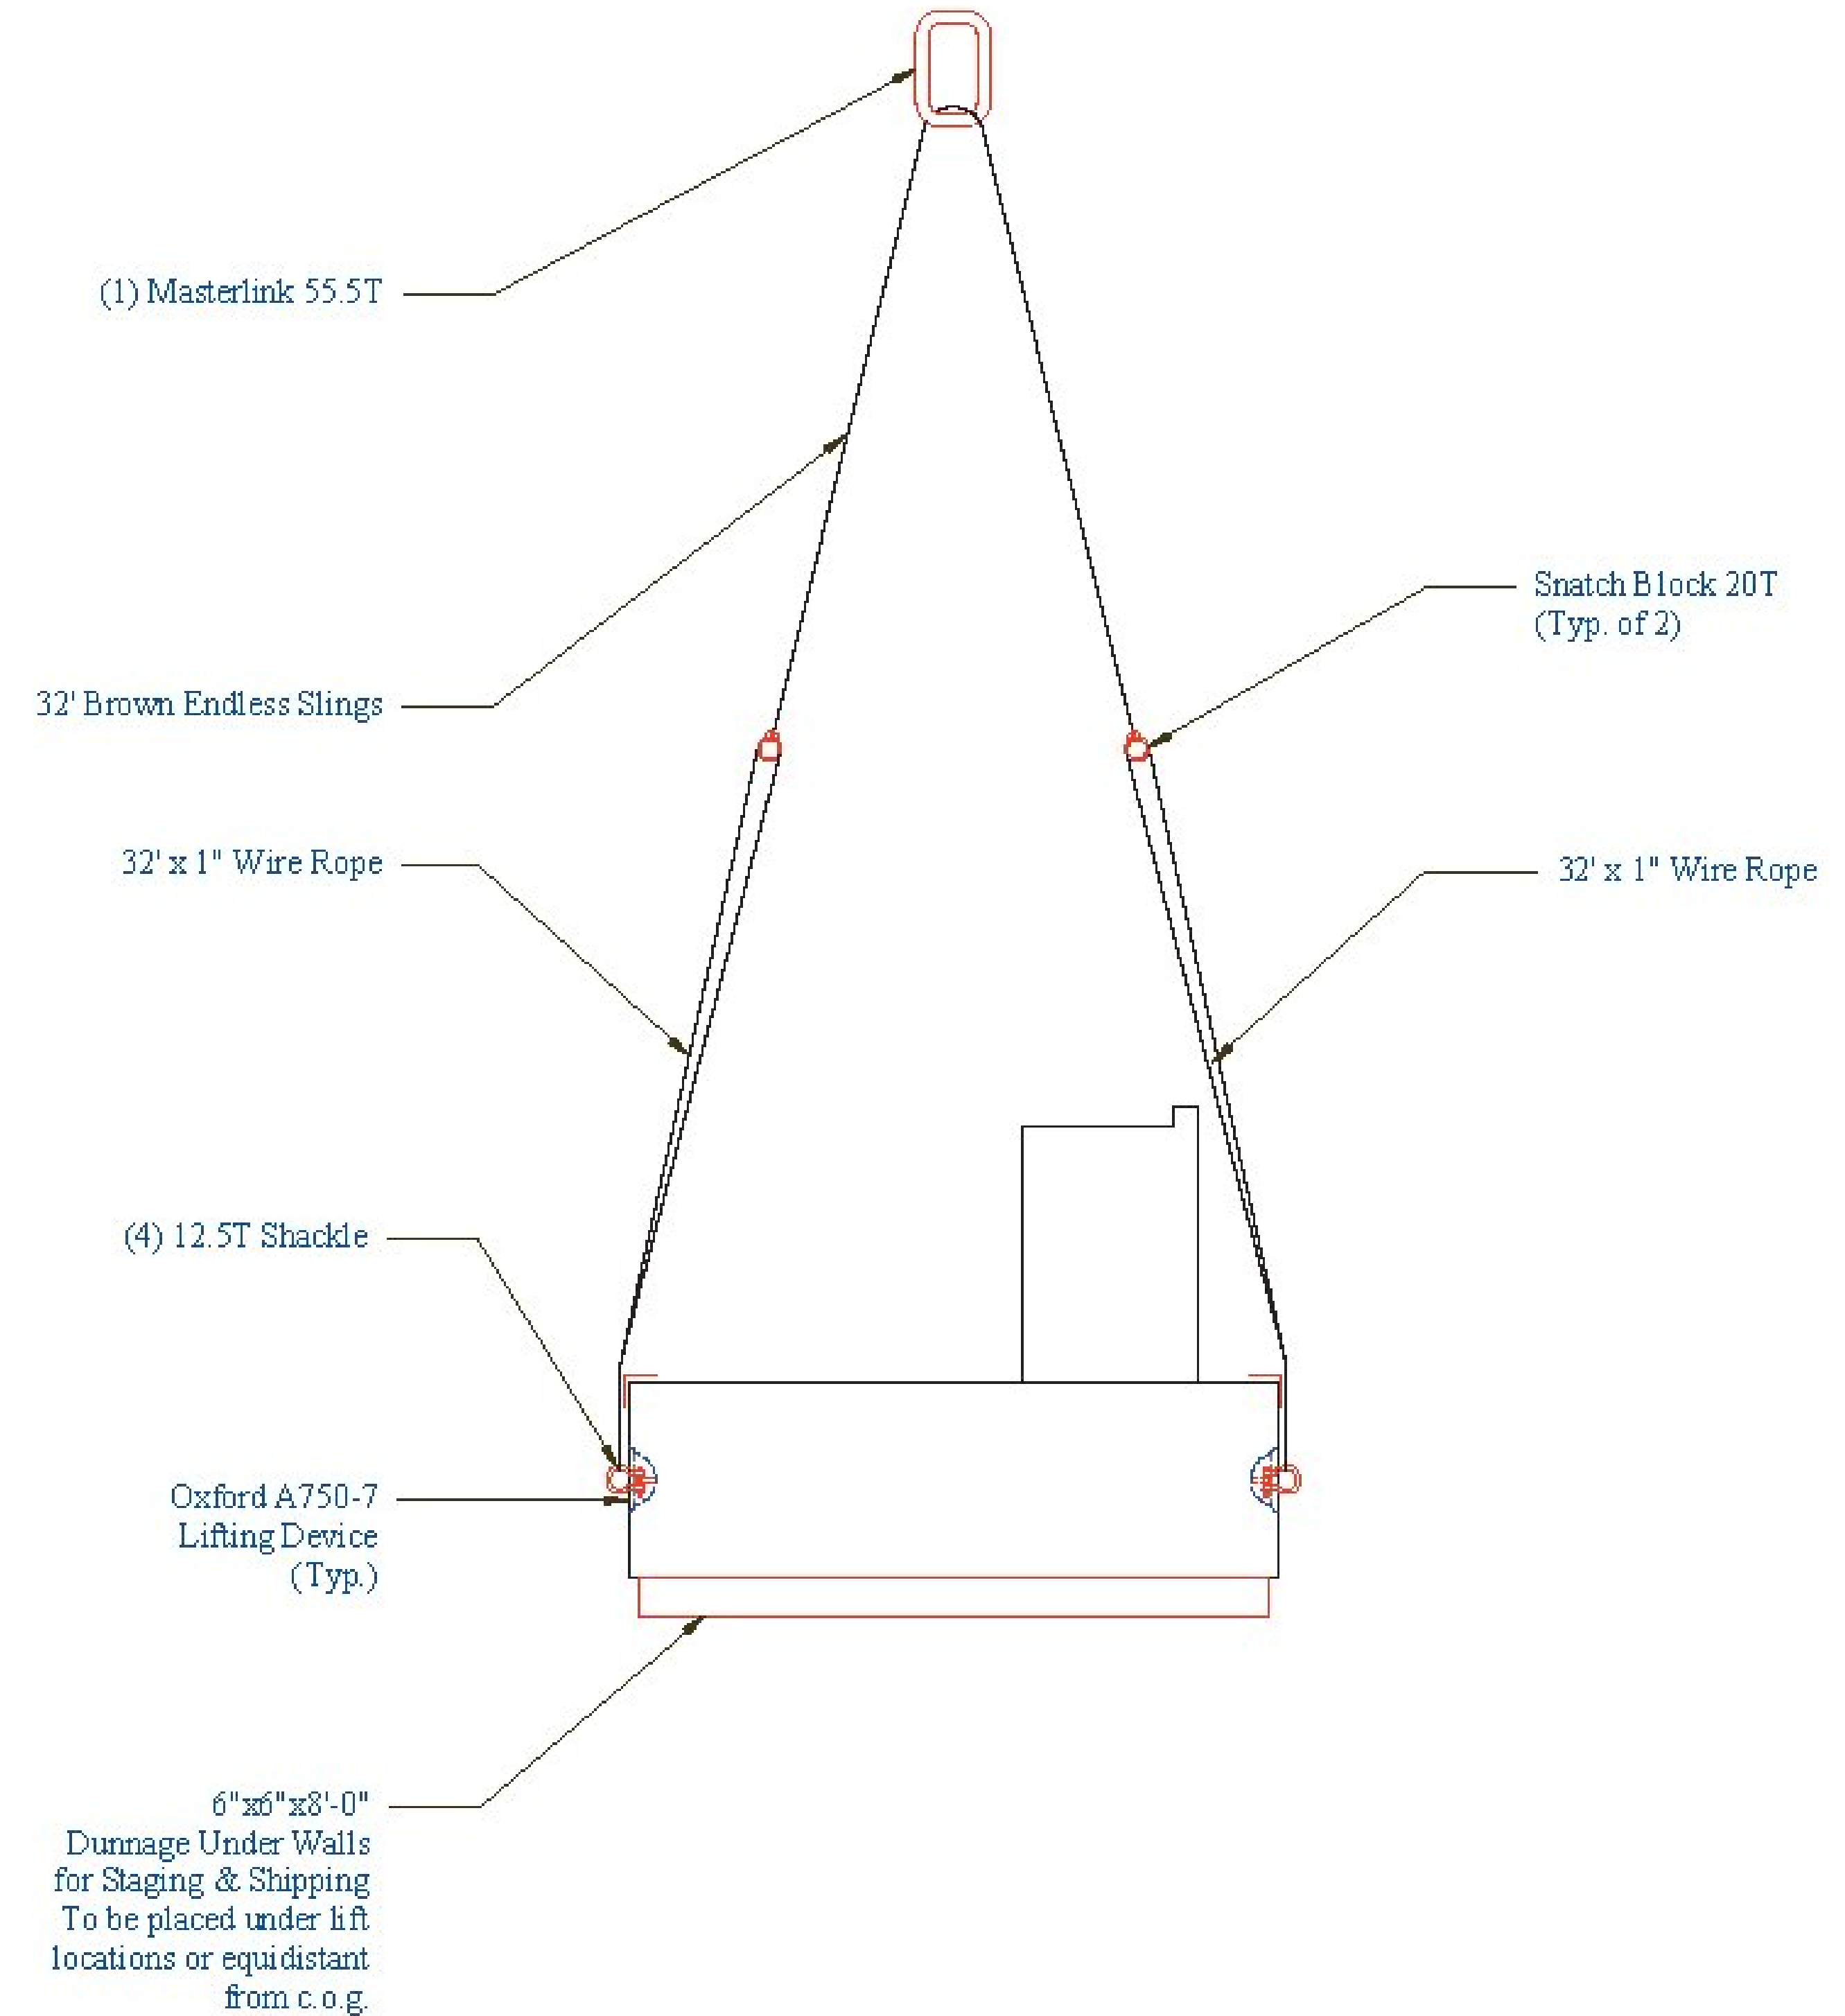

**TYLIN INTERNATIONAL**

The stamped documents are hereby:

Approved

Approved as noted

Rejected and resubmit

See transmittal for additional information as applicable.

This review is for general conformance with design only. Any deviation from the plan or specification is solely noted by the Contractor has not been reviewed. Review by the Engineer shall not relieve the Contractor of their liability for any errors or deviation from the contract requirements.

Josh Olund 08/03/2016  
Reviewer Date

CONTRACTORS VISPE:

Vermont Agency of Transportation  
**RECEIVED**  
OK'D BY TY:lh OK'D BY JMH  
August 2, 2016  
RESUBMIT No Approved  
BY Kristin Higgins DATE 08/03/2016

PRECAST CONCRETE BOX CULVERT SHOP DRAWINGS (SDI JOB #17682)

SUPERVISOR: E. Barendse  
DETAILER: I. ADAMS  
CHECKER: E. Barendse

PROJECT NAME: DUXBURY  
PROJECT #: BF 013-4(47)  
LOCATION: DUXBURY, VT

INSTALLER:  
J.A. McDONALD  
585 Gilman Rd  
Lyndon Ctr, VT 05850

07/29/16

FABRICATOR:  
193 INDUSTRIAL AVE.  
WILLISTON, VT 05495  
Ph: (802) 658-0201



LIFTING\_DETAIL

12\_OF\_12