


STATE OF VERMONT AGENCY OF TRANSPORTATION

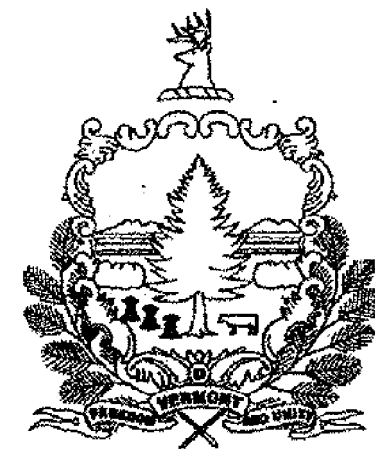

PROPOSED IMPROVEMENT BRIDGE PROJECT


TOWN OF NORTH HERO – GRAND ISLE
COUNTY OF GRAND ISLE

ROUTE NO. : US ROUTE 2 BRIDGE NO. : 8

PROJECT LOCATION : LOCATED ON US ROUTE 2, APPROXIMATELY 2,000 FEET NORTH OF THE
INTERSECTION OF US ROUTE 2 AND EAST SHORE NORTH OVER LAKE CHAMPLAIN.

PROJECT DESCRIPTION : INTERIM DRAWBRIDGE REPAIRS – WORK PACKAGE II


LENGTH OF STRUCTURE : 258.80 FEET.

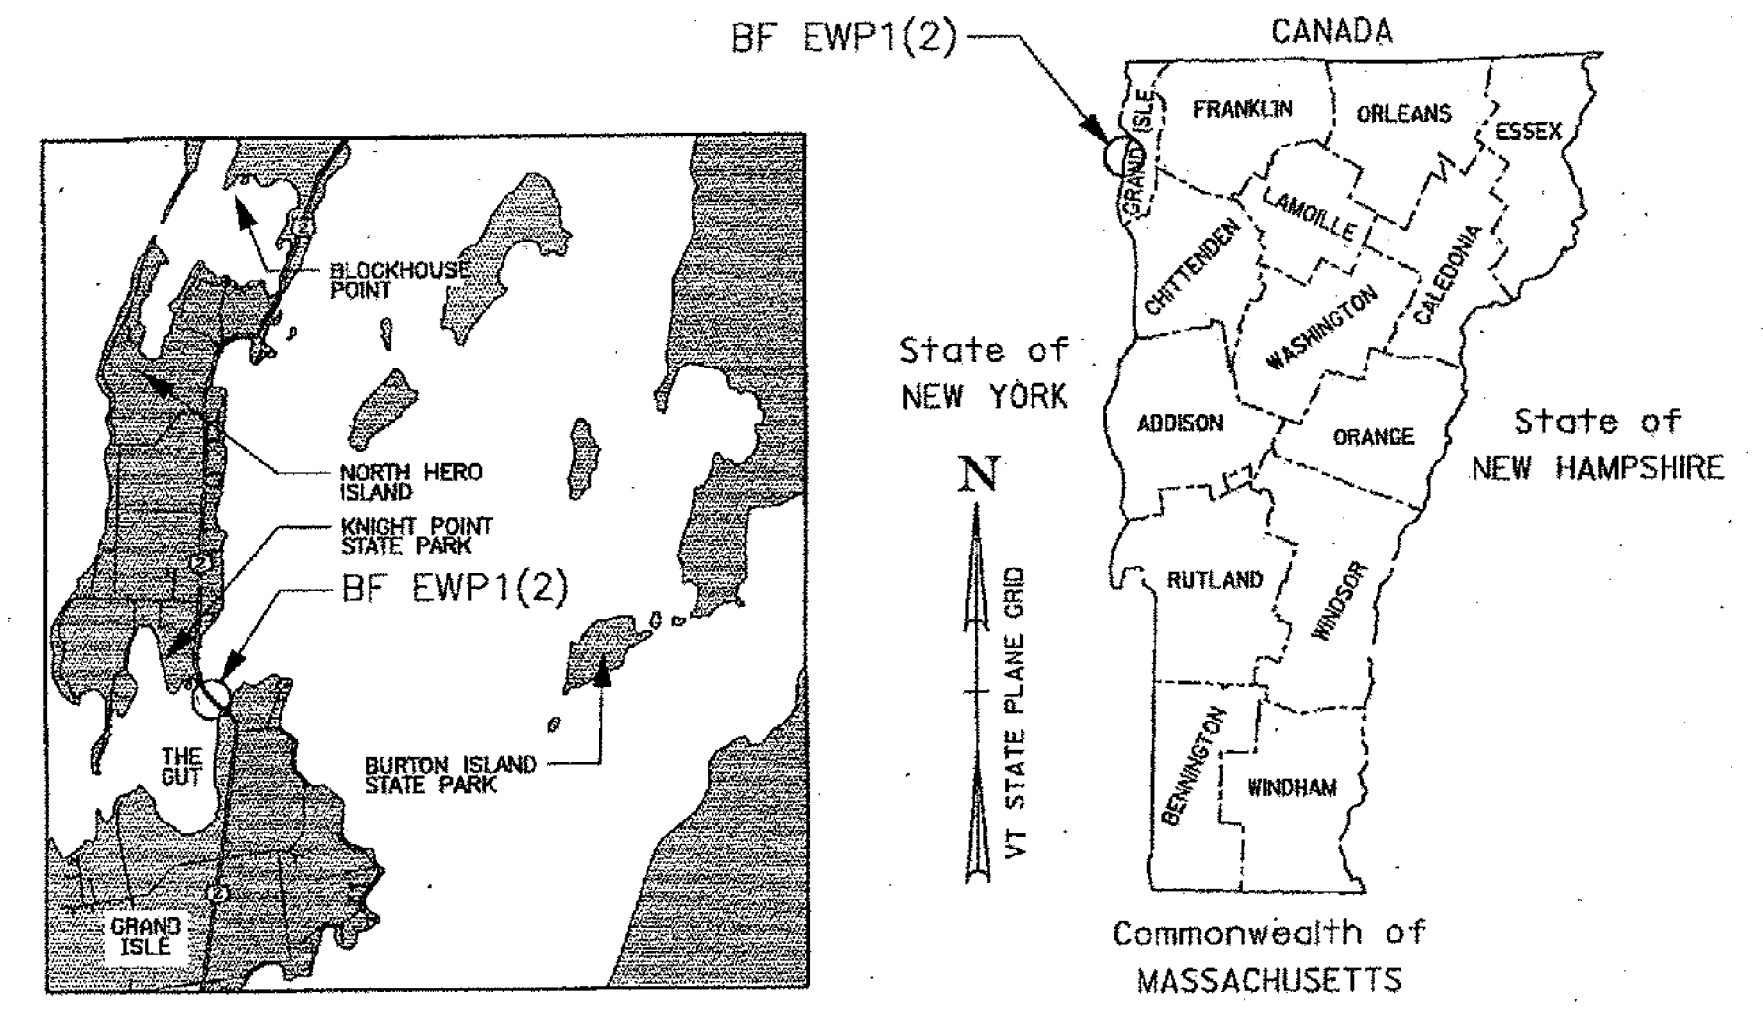

| SHEET NO. | TITLE |
|-----------|--|
| 1 OF 8 | TITLE SHEET |
| 2 OF 8 | PAY ITEMS AND QUANTITIES |
| 3 OF 8 | MECHANICAL WORK |
| 4 OF 8 | MECHANICAL WORK DETAILS I |
| 5 OF 8 | MECHANICAL WORK DETAILS II |
| 6 OF 8 | ELECTRICAL WORK |
| 7 OF 8 | ELECTRICAL EQUIPMENT BILL OF MATERIALS |
| 8 OF 8 | AUXILIARY DRIVE CONTROLS |

| RECORD PLANS | |
|--|--------------------------------------|
| CONTRACTOR: | CIANBRO CORPORATION - PITTSFIELD, ME |
| RESIDENT ENGINEER: | GREG WILCOX |
| CONSTRUCTION BEGAN: | FEBRUARY 8, 2016 |
| CONSTRUCTION COMPLETE: | MARCH 21, 2016 |
| RECORD PLANS BY: | GREG WILCOX & KEVIN KING |
| I HEREBY CERTIFY THAT ALL THE CONSTRUCTION REQUIRED BY THIS SET OF DRAWINGS HAS BEEN ACCOMPLISHED AS INDICATED HEREIN. | |
| BY | RESIDENT ENGINEER |
| DATE | 3/8/17 |
| NOTE: Any further information concerning final quantities, amounts or other details relative to this project may be found at Central Files in the electronic archives. | |


BUILT AS DESIGNED

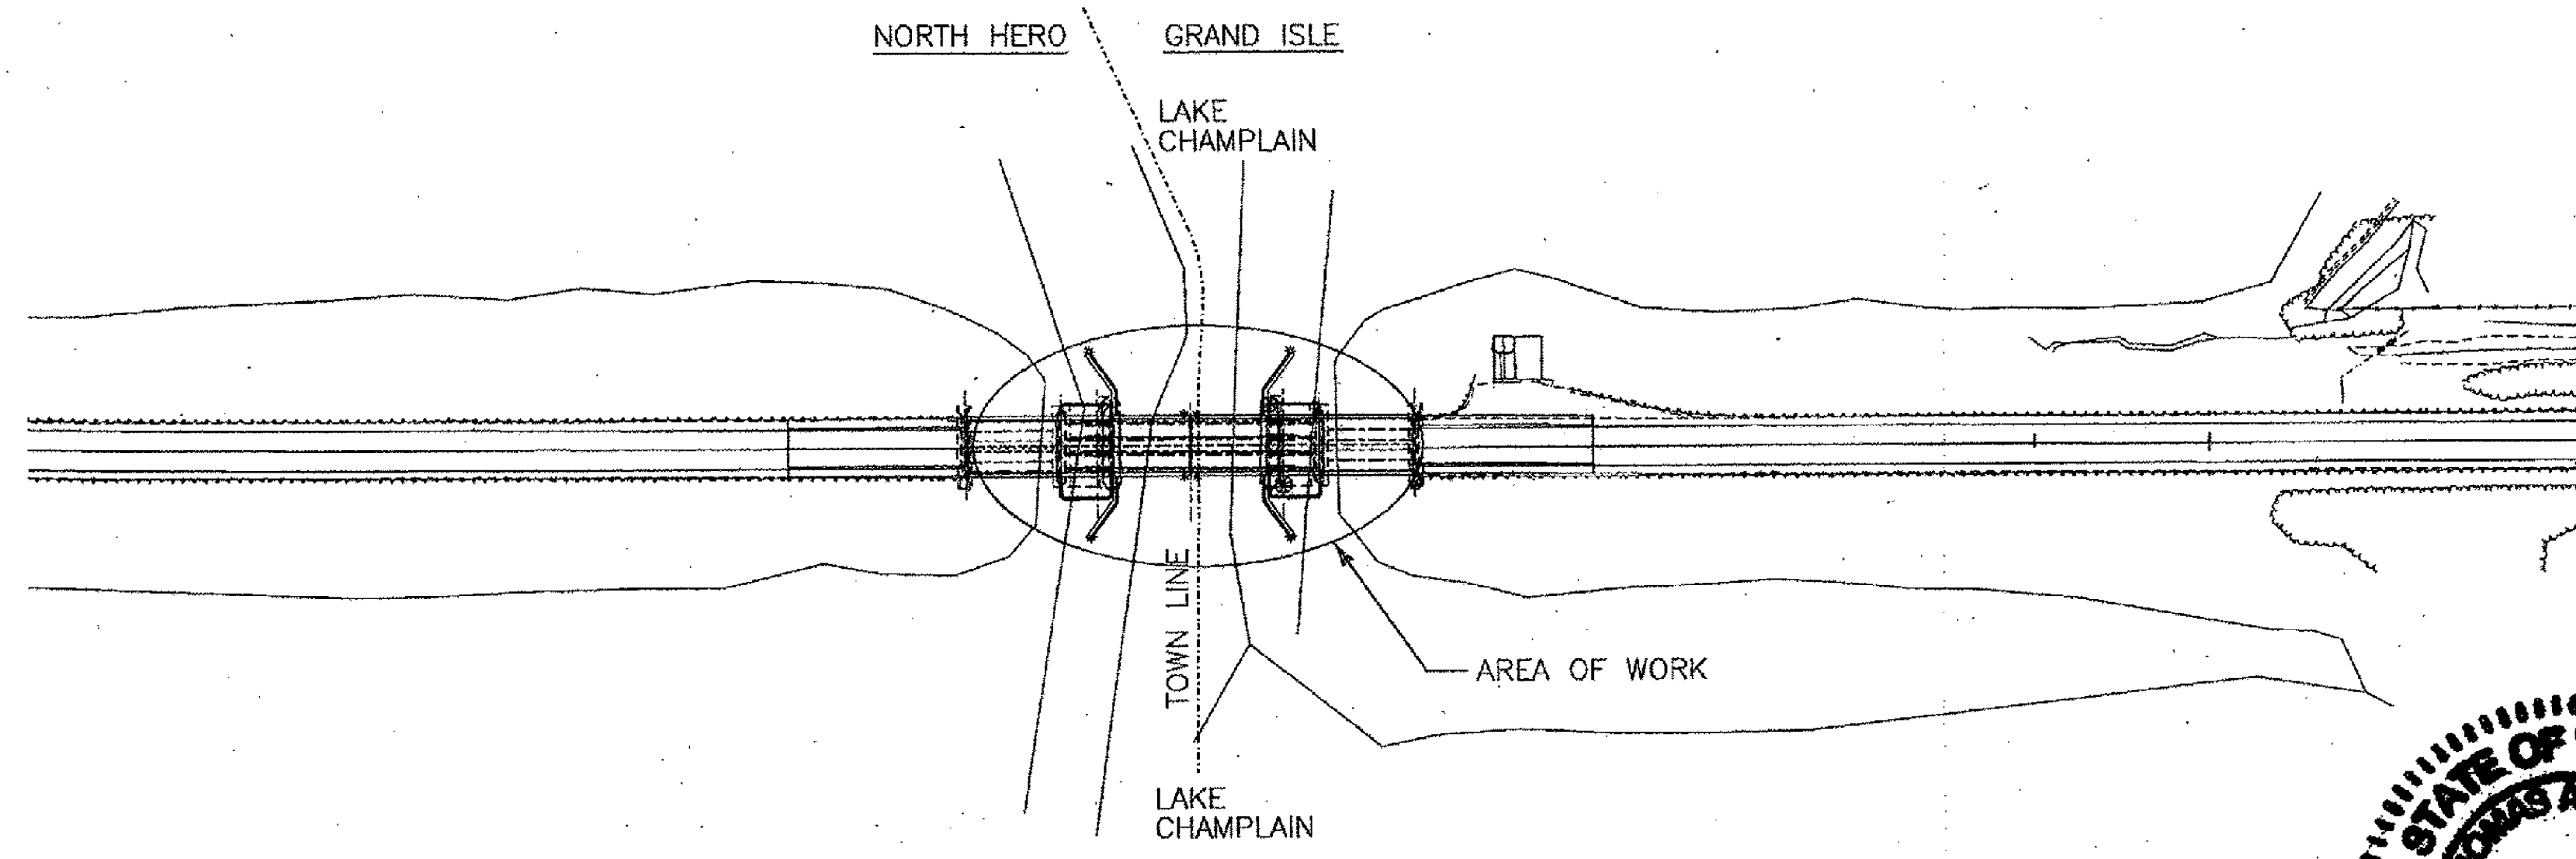

THESE PLANS ARE SUBJECT TO SUCH ENGINEERING CHANGES AS MAY BE REQUIRED BY THE FEDERAL HIGHWAY ADMINISTRATION OR THE DIRECTOR OF PROGRAM DEVELOPMENT. CONSTRUCTION IS TO BE CARRIED ON IN ACCORDANCE WITH THESE PLANS AND THE STANDARD SPECIFICATIONS FOR CONSTRUCTION DATED 2014, AS APPROVED BY THE FEDERAL HIGHWAY ADMINISTRATION ON JULY 20, 2011 FOR USE ON THIS PROJECT, INCLUDING ALL SUBSEQUENT REVISIONS AND SUCH REVISED SPECIFICATIONS AND SPECIAL PROVISIONS AS ARE INCORPORATED IN THESE PLANS.

| |
|-------------------------------------|
| QUALITY ASSURANCE PROGRAM : LEVEL 2 |
| SURVEYED BY : |
| SURVEYED DATE : |
| DATUM |
| VERTICAL N/A |
| HORIZONTAL N/A |

SCALE 1" = 80'-0"
80 0 80

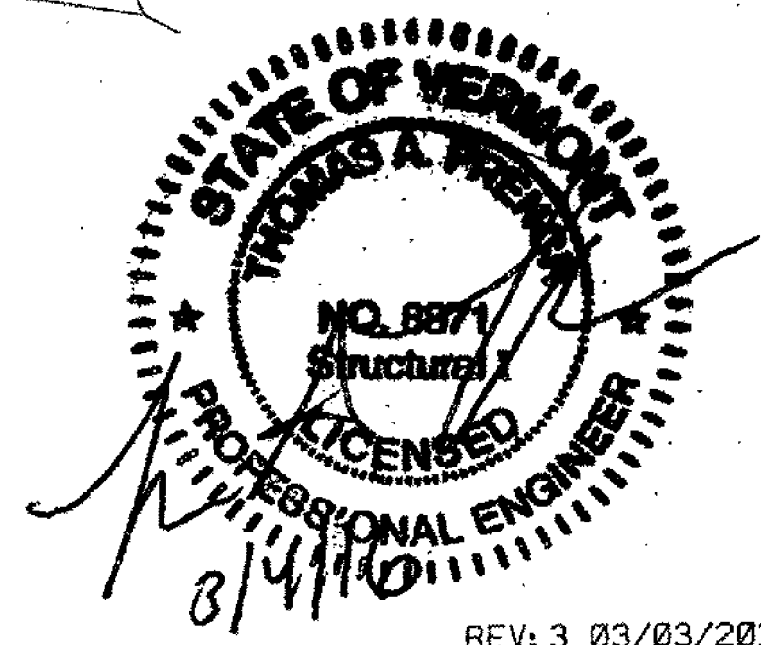

| |
|---|
| DEPARTMENT OF TRANSPORTATION FEDERAL HIGHWAY ADMINISTRATOR |
| APPROVED <i>Mark A. Vasta</i> DATE 3/8/16 |
| DIRECTOR OF HIGHWAY DIVISION |
| APPROVED <i>J.P.M.</i> DATE 3/4/2016 |
| PROJECT MANAGER : D. LANDRY |
| PROJECT NAME : NORTH HERO GRAND ISLE |
| PROJECT NUMBER : BF EWP1(2) |
| SHEET 1 OF 8 SHEETS |

REV: 3 03/03/2016