



PIPE #17 PROFILE
(SEE SHEET GP 2 FOR PLAN)

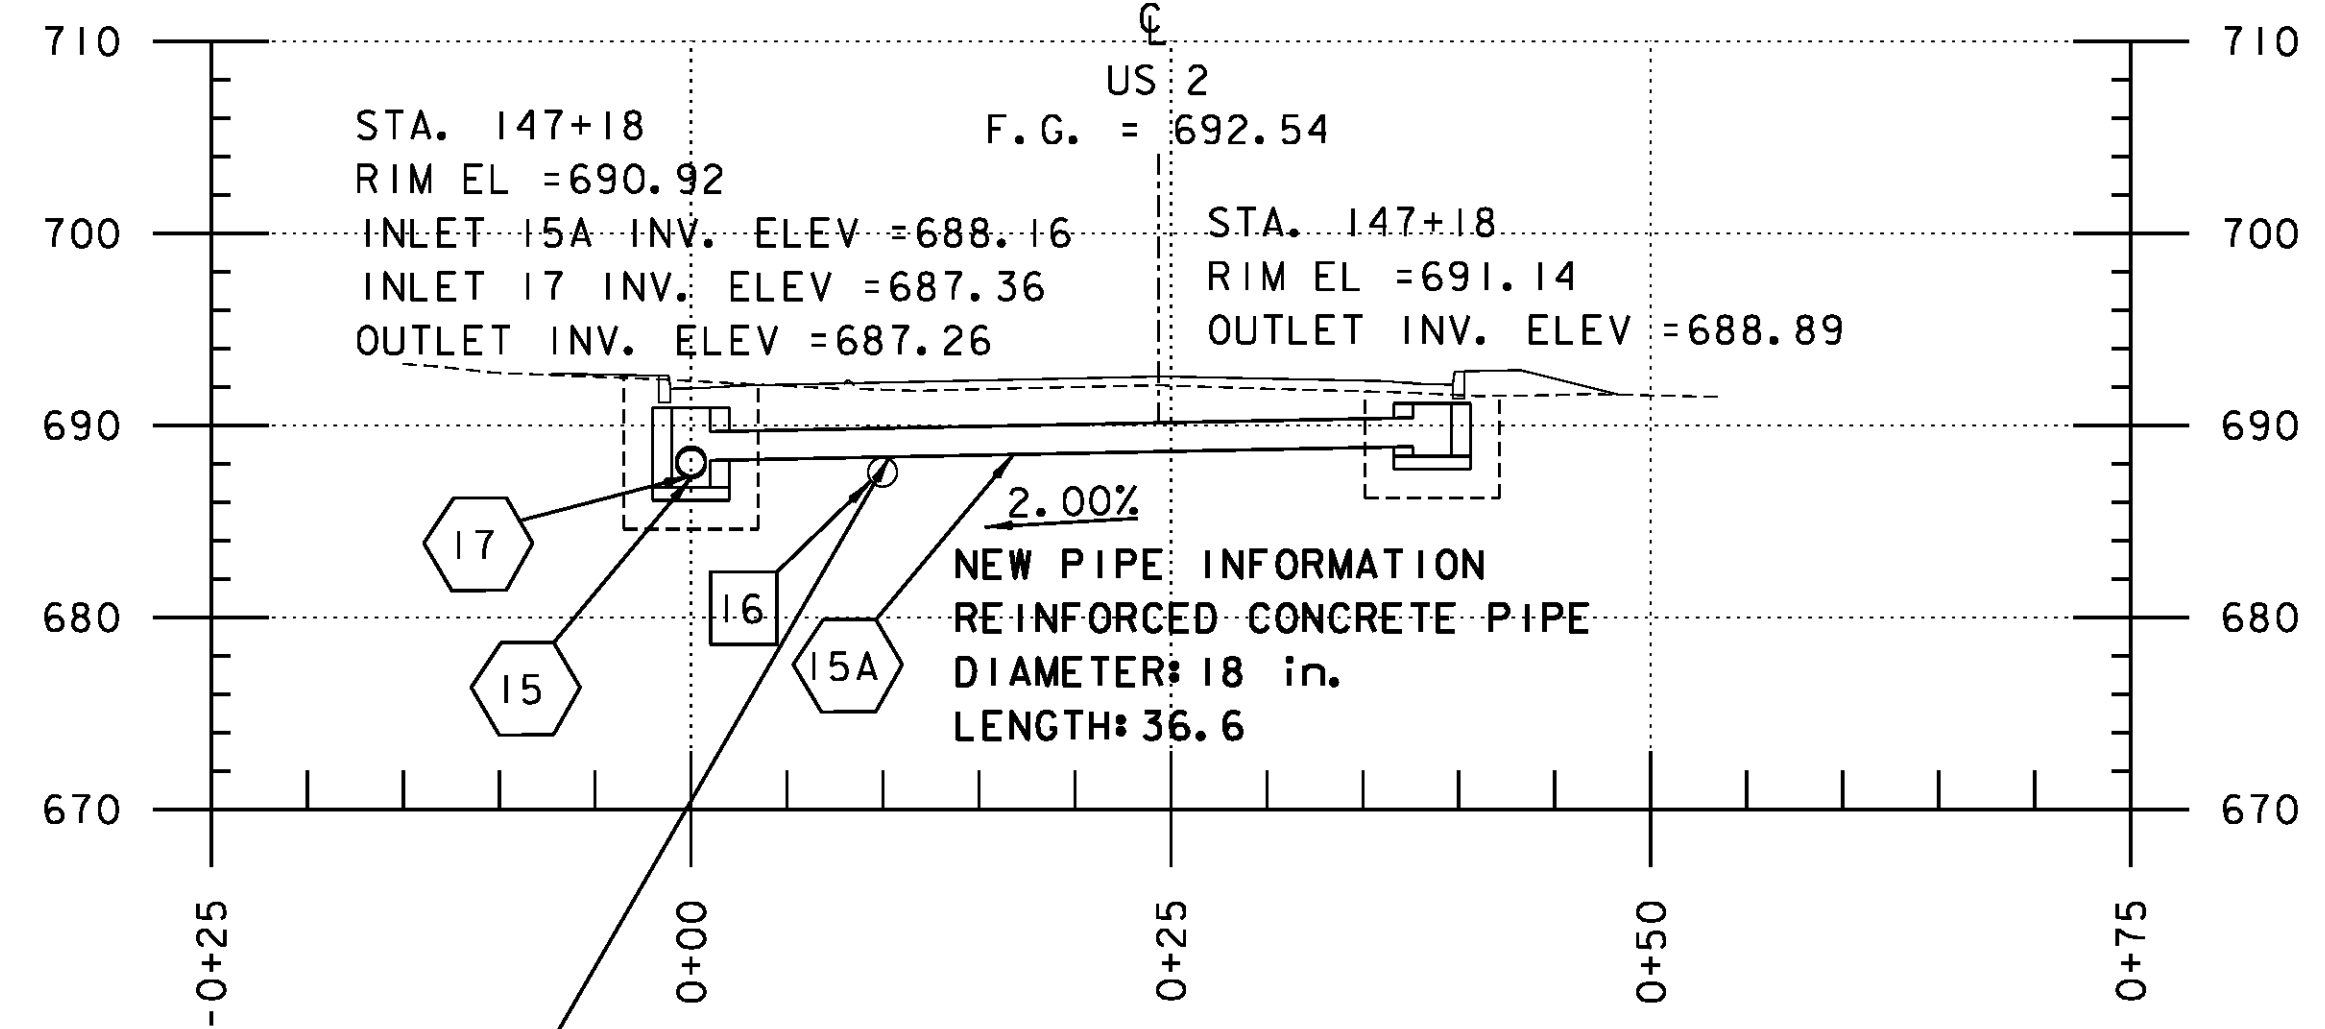


PIPE #15A PROFILE
(SEE SHEET GP 2 FOR PLAN)

EXPLORATORY EXCAVATION
 REQUIRED TO VERIFY ELEVATION
 OF THE TOP OF PIPE #16
 (TRANS MAY ELECT TO ELIMINATE
 PIPE #15A FROM THE WORK, IF
 PROFILE IS NOT FEASIBLE)

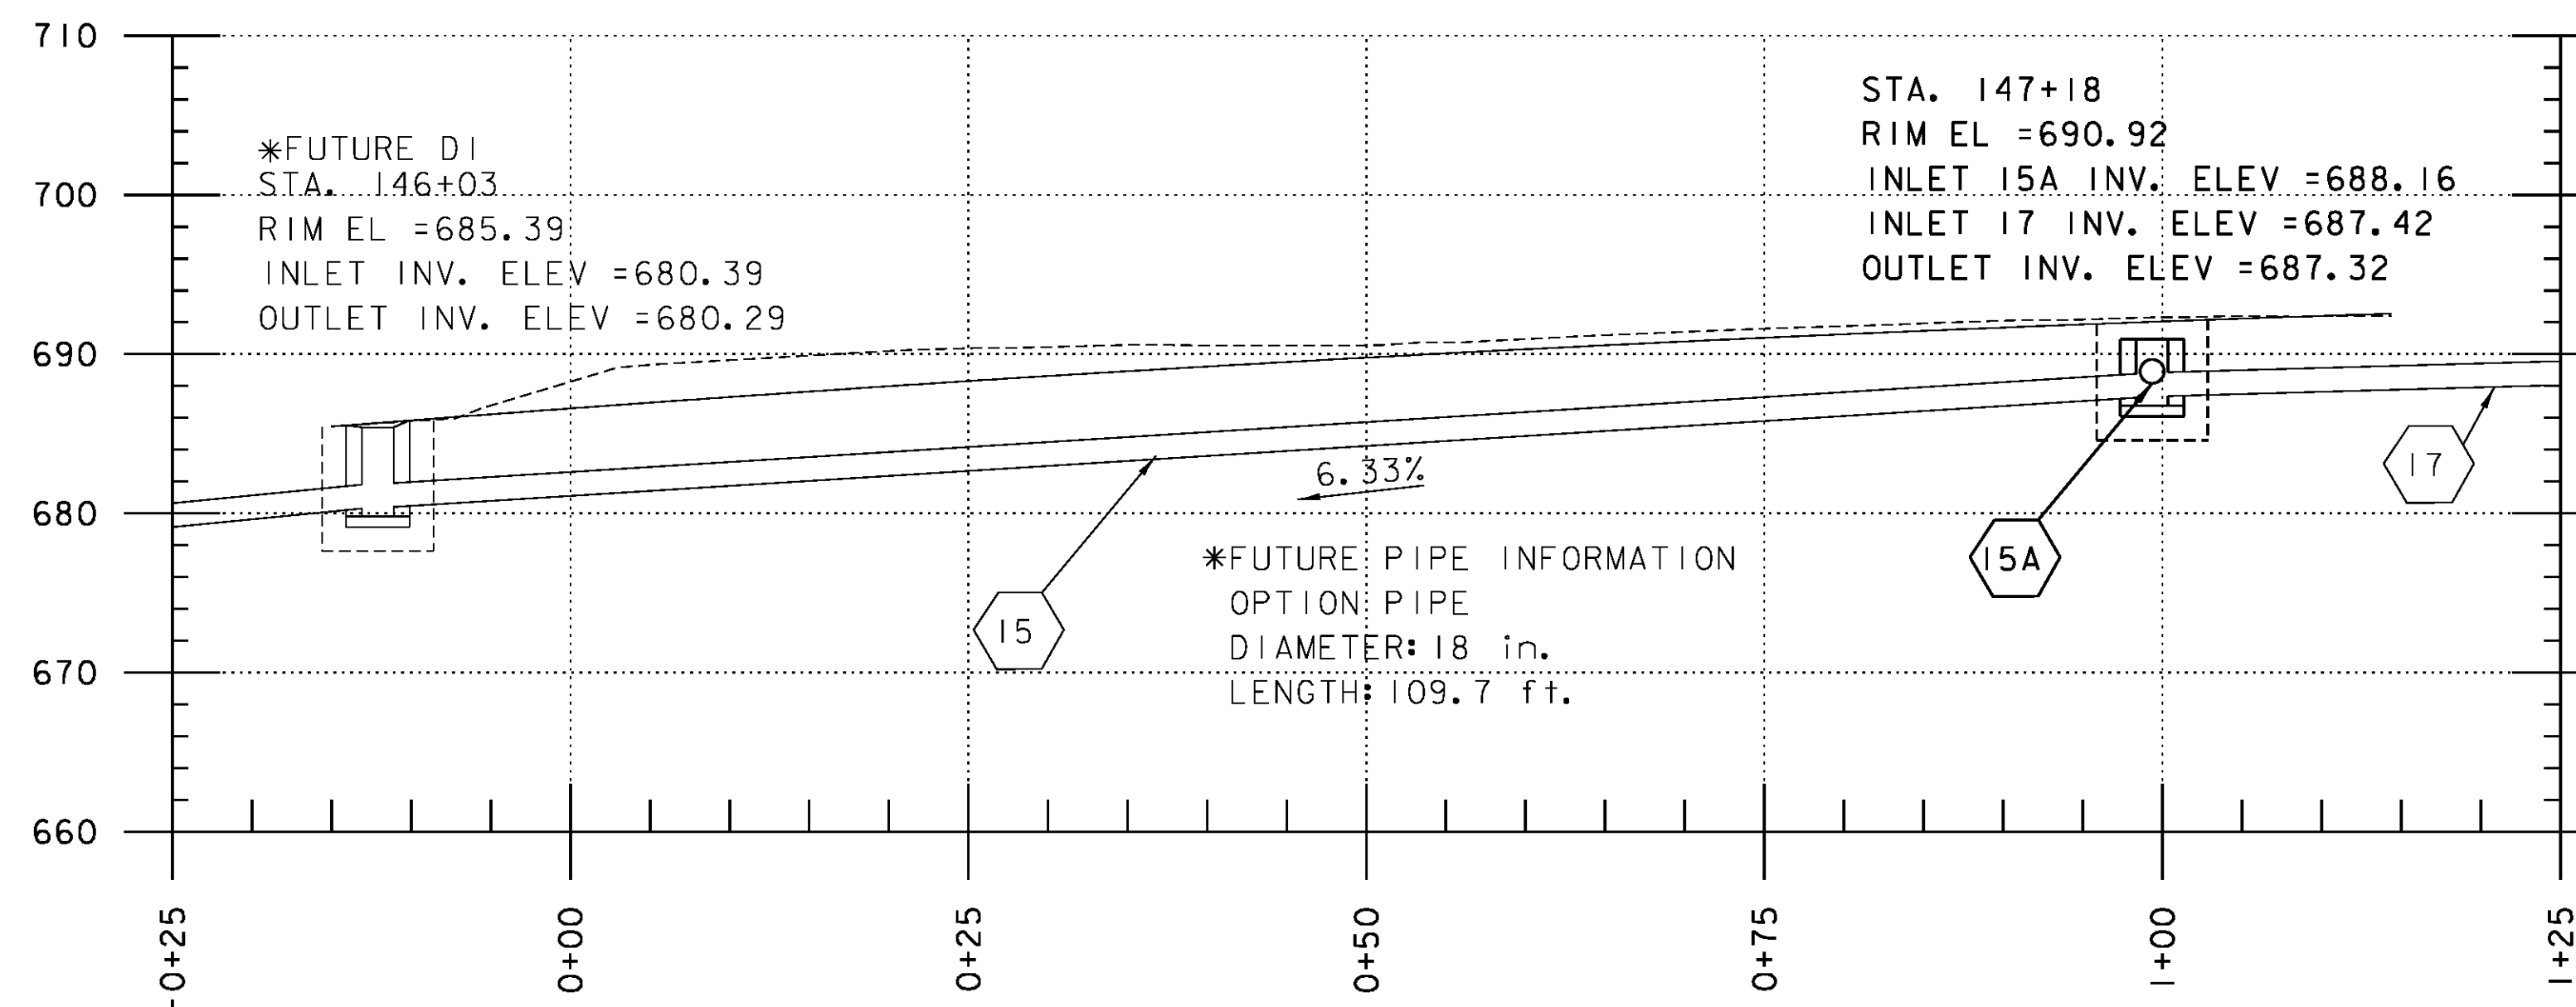

PIPE #15 PROFILE
(SEE SHEET GP 2 FOR PLAN)

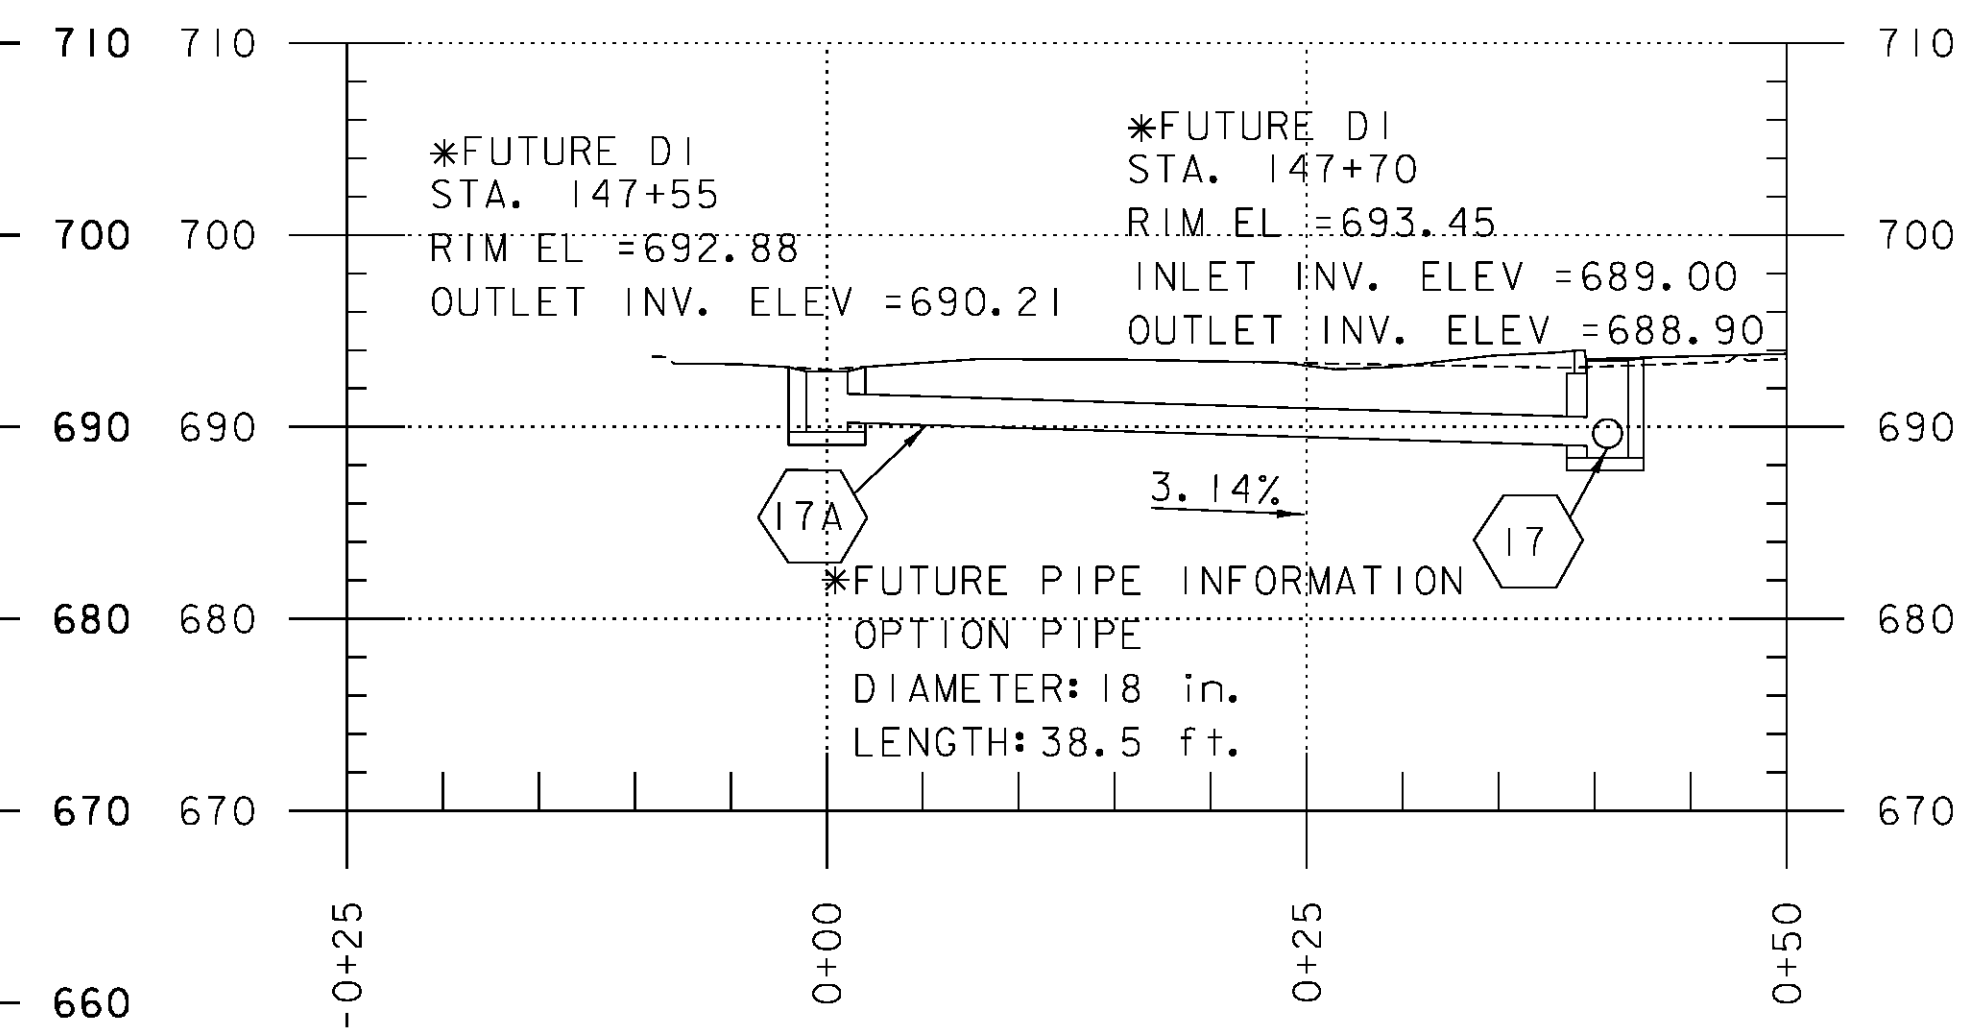


PIPE #17A PROFILE
(NOT IN CONTRACT)

NOTE
 PIPE #15A AND CONNECTED INLETS ARE
 PART OF THIS CONTRACT. ALL OTHER
 DRAINAGE INFORMATION IS SHOWN FOR
 REFERENCE ONLY AND IS INTENDED TO
 BE BUILT AS PART OF A FUTURE
 CONTRACT.

* DRAINAGE FEATURE IS NOT PART OF
 THIS CONTRACT; SHOWN FOR
 INFORMATION ONLY

NOTE:

FOR CLARITY UNDERDRAIN IS NOT SHOWN IN PROFILES
 ADJUST UNDERDRAIN AS REQUIRED TO AVOID CULVERTS
 DRAINAGE STRUCTURES.

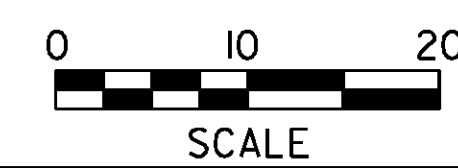

PROJECT NAME: EAST MONTPELIER
 PROJECT NUMBER: BF EWP2(1)

FILE NAME: 19_Drainage profiles - ER.dgn PLOT DATE: 5/26/2016
 PROJECT LEADER: T. KNIGHT DRAWN BY: C. GENDRON
 DESIGNED BY: K. RICHARDSON CHECKED BY: T. KNIGHT
 DRAINAGE PROFILES DP 3 SHEET 12 OF 42